


6136

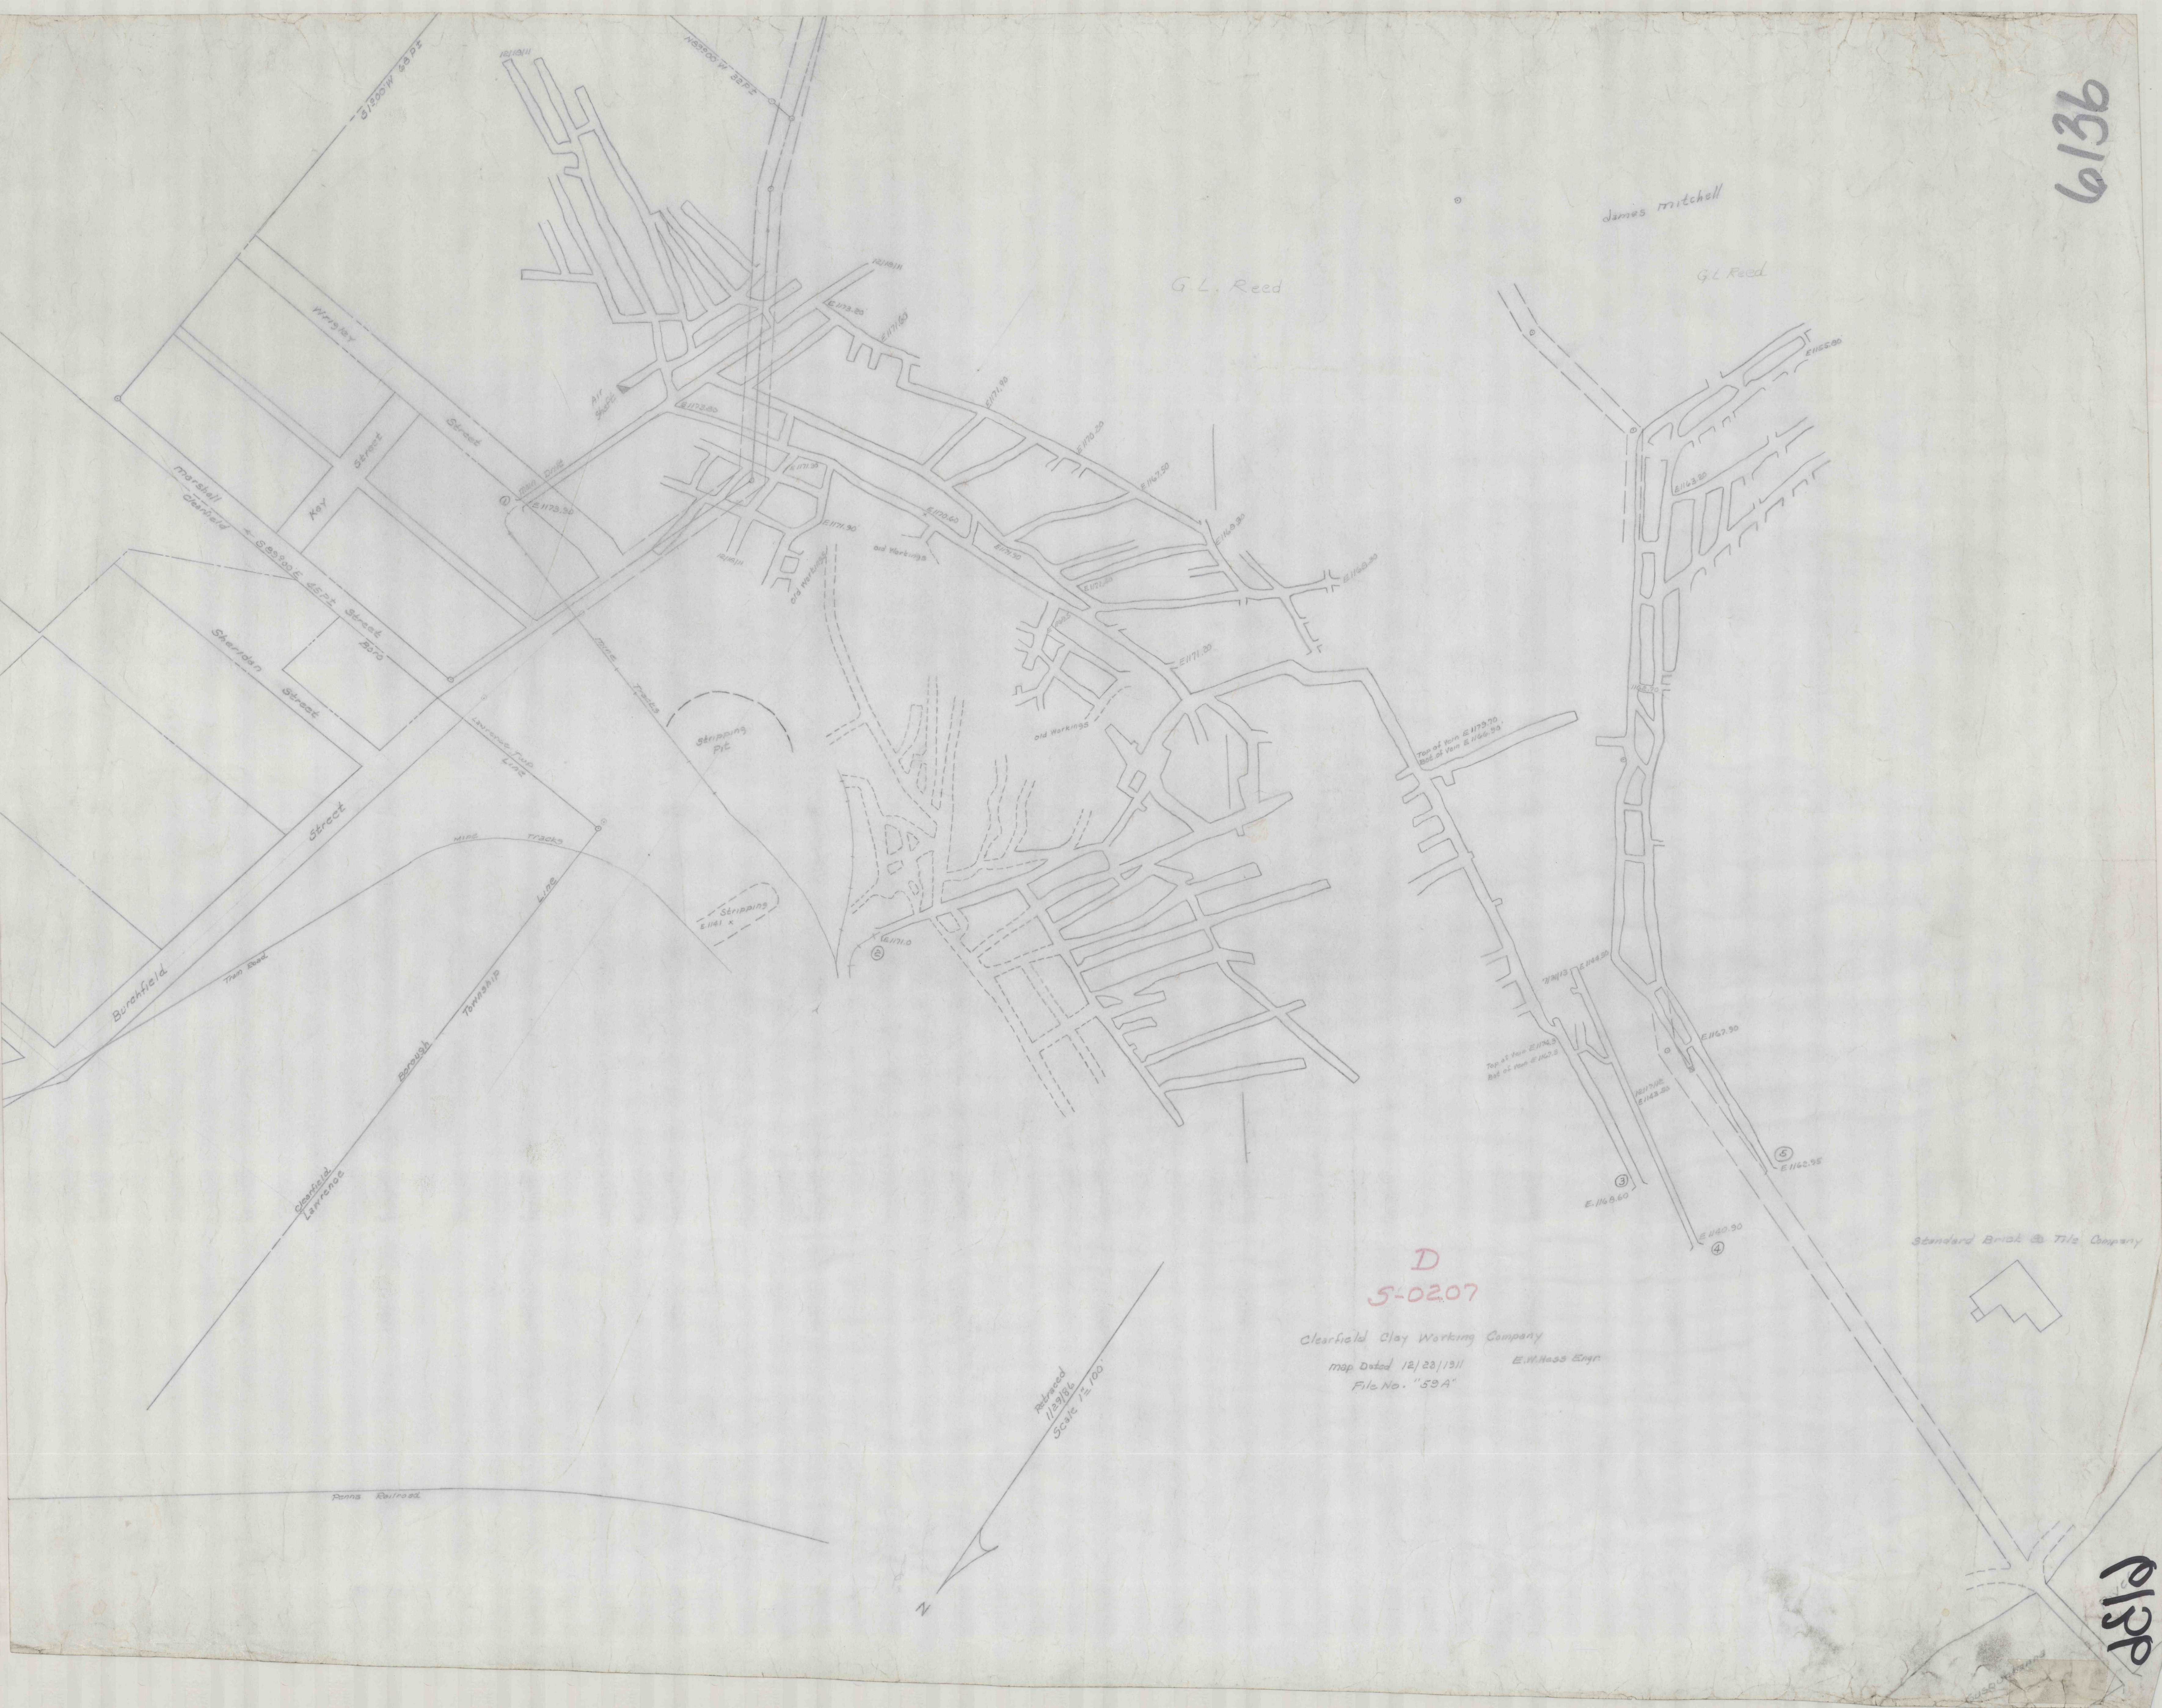

James Mitchell

G.L. Reed

G.L. Reed

D  
5-02.07

Clearfield Clay Working Company  
Map Dated 12/23/1911  
File No. "53A" E.W. Moss Engr.

Reduced  
1/2500  
Scale 1" = 100'

Standard Brick & Tile Company

6136