
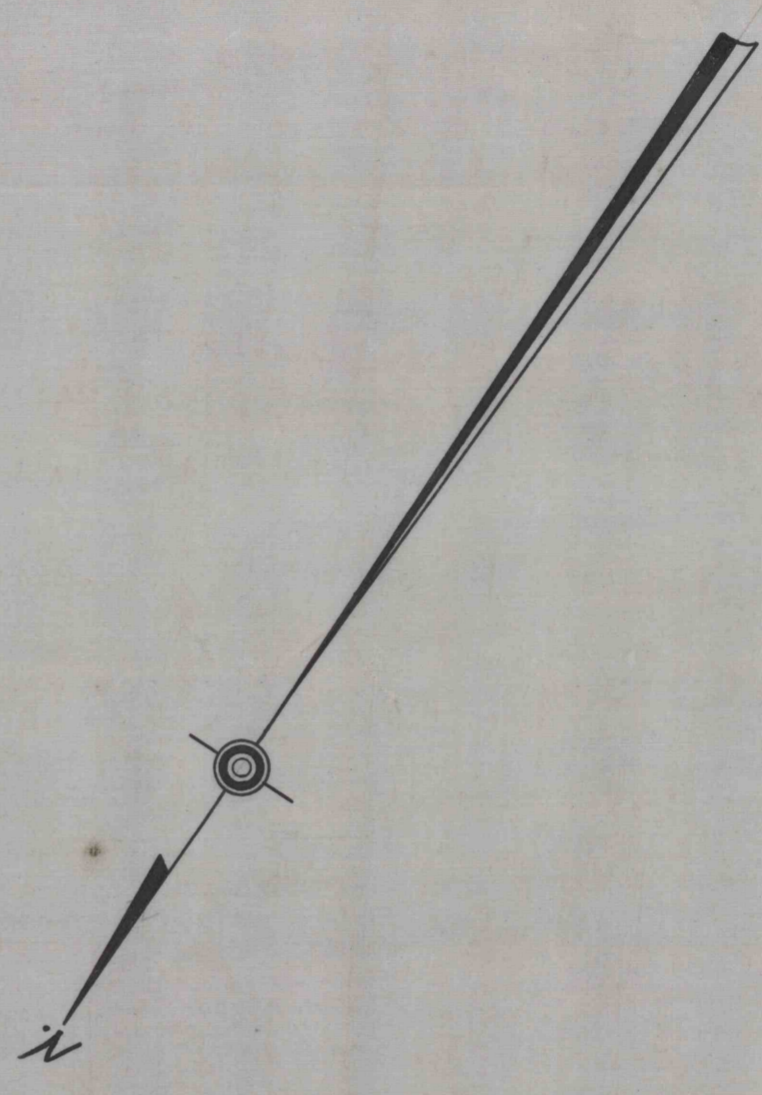


322-B D

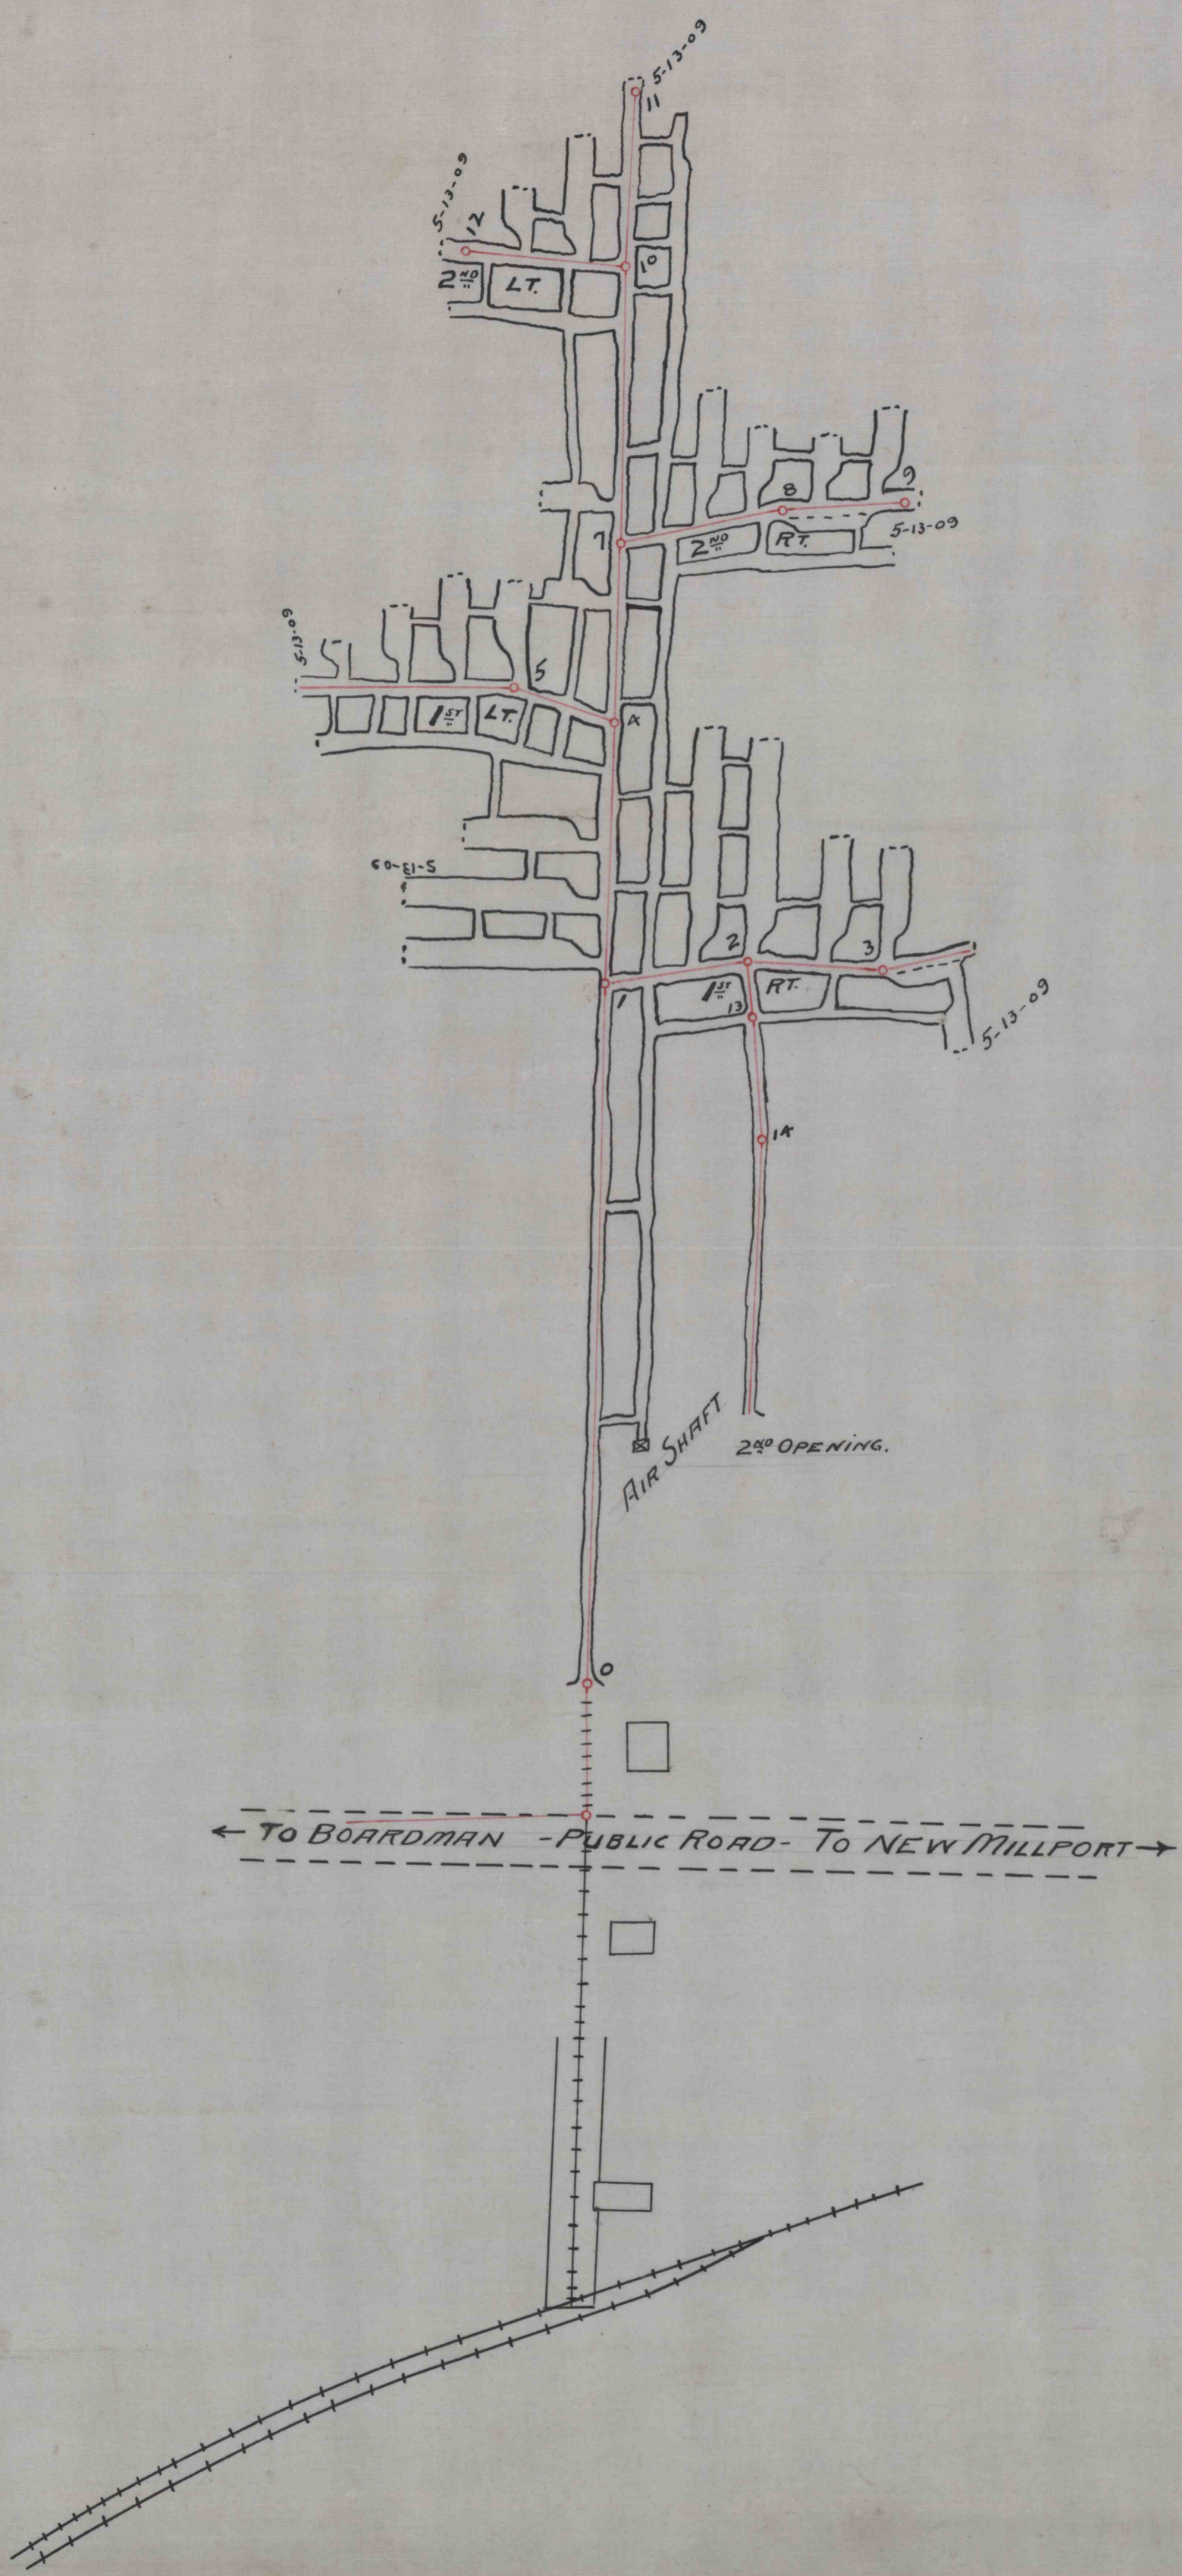

D

MAP OF  
 BOARDMAN MINE  
 OPERATED BY JAMES KEER.  
 OPENING N<sup>o</sup> 3  
 CLEARFIELD, PA - SCALE 1"=100' - E.W. HESS,  
 MAY 20<sup>th</sup> - 09 ENGR.

986B

6267