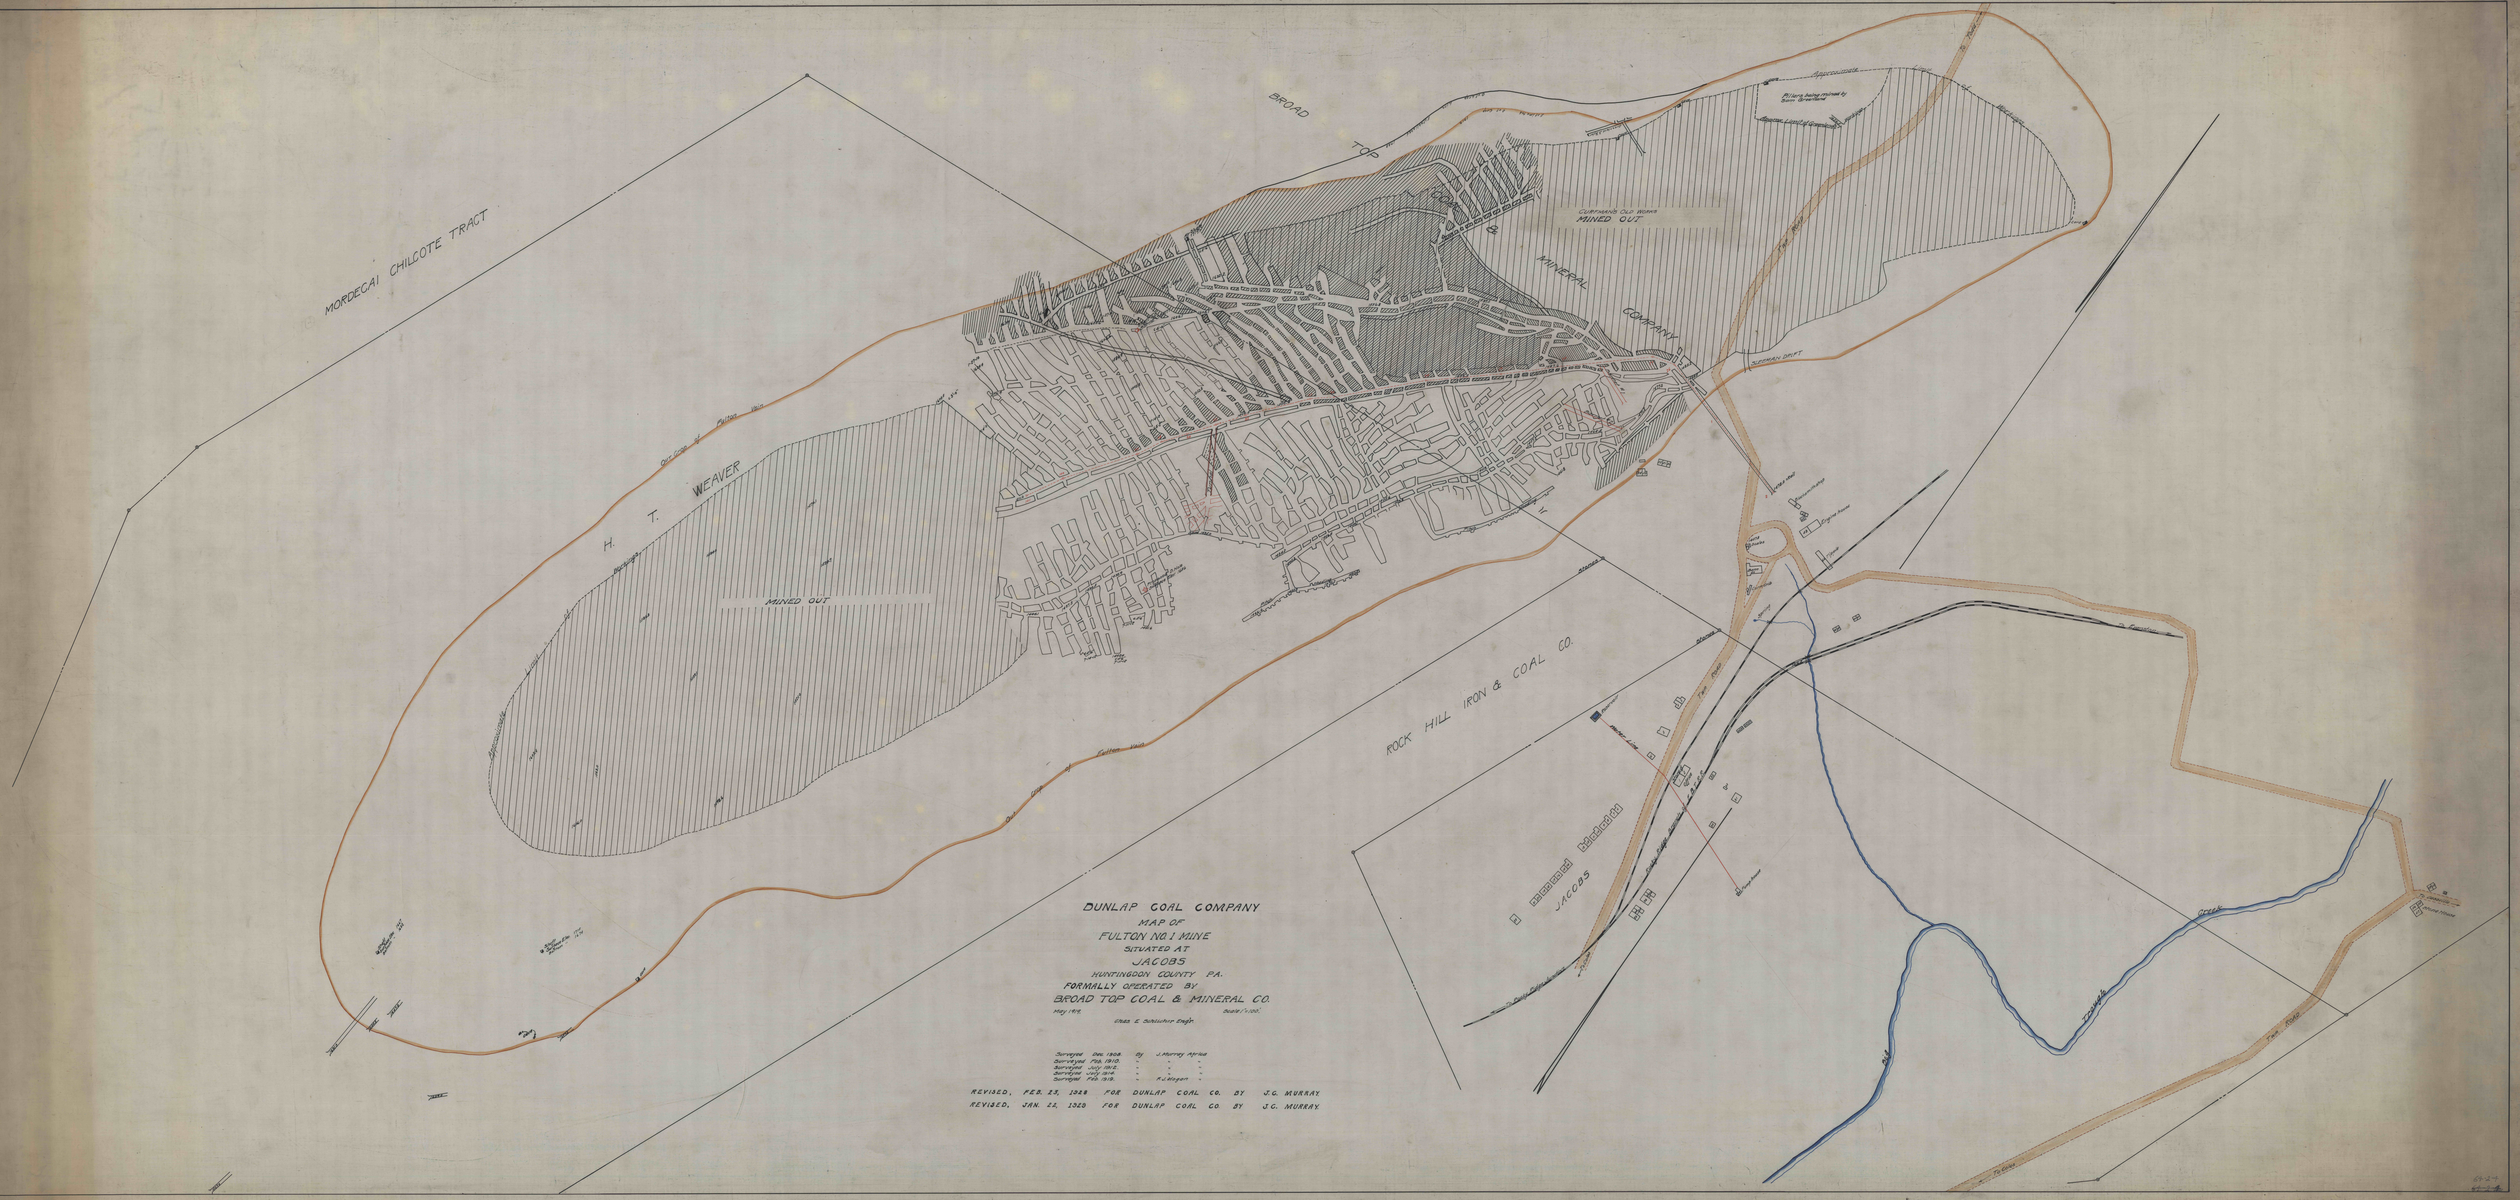
MORDECAI CHILCOTE TRACT
BROAD TOP
MINERAL COMPANY
CURRAN'S OLD WORK
MINED OUT
SLOPE
SLOPE
H. T. WEAVER
MINED OUT
ROCK HILL IRON & COAL CO.
JACOBS
DUNLAP COAL COMPANY
MAP OF
FULTON NO. 1 MINE
SITUATED AT
JACOBS
HUNTINGDON COUNTY PA.
FORMALLY OPERATED BY
BROAD TOP COAL & MINERAL CO.
May 1915
Scale 1"=100'.
Chas. E. Schlicher Engr.
Surveyed Dec. 1908 By J. Murray Africa
Surveyed Feb. 1910. " " "
Surveyed July 1912. " " "
Surveyed July 1914. " " "
Surveyed Feb. 1918. " R. J. Wagner "
REVISED, FEB. 23, 1928 FOR DUNLAP COAL CO. BY J.G. MURRAY
REVISED, JAN. 22, 1920 FOR DUNLAP COAL CO. BY J.G. MURRAY