

MAP OF PART OF NARCO'S FROSTBURG CLAY MINE
SHOWING ENCROACHMENT ON B.S.F.B.CO.

REFERENCE DATA

GEO. S. GOOD FIRE BRICK CO.

CURWENSVILLE, CLEARFIELD COUNTY, PA.
ENGINEERING DEPARTMENT


ENV. No.

SHEET No.

66-2-18

SCALE 1" = 100 FT.

DATE 5/26/37

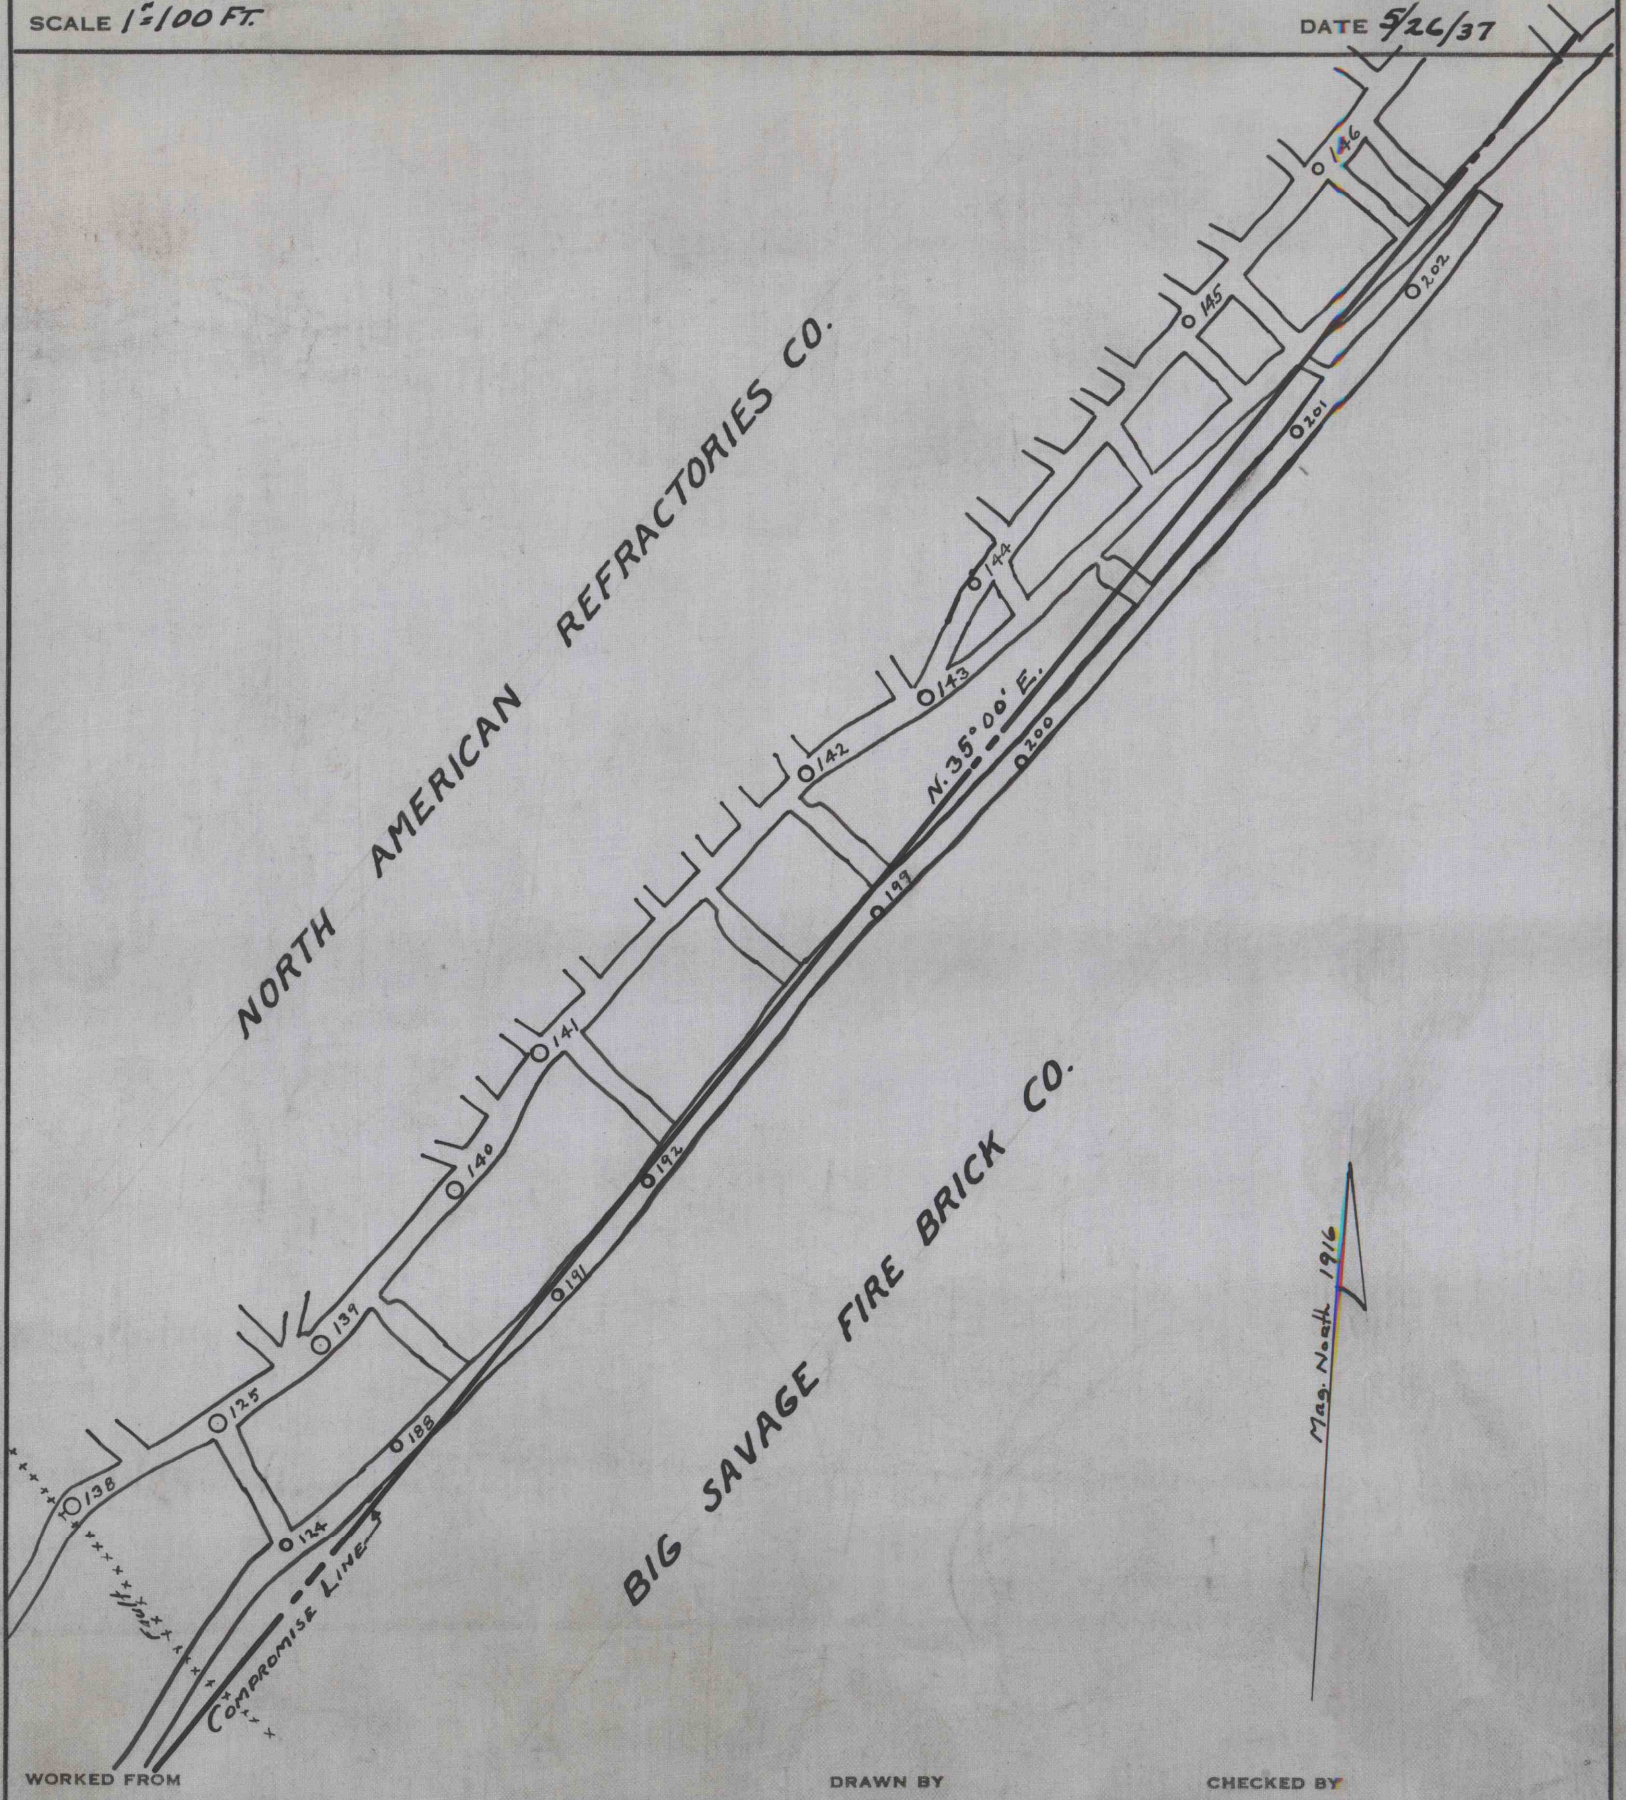

WORKED FROM

DRAWN BY

CHECKED BY