


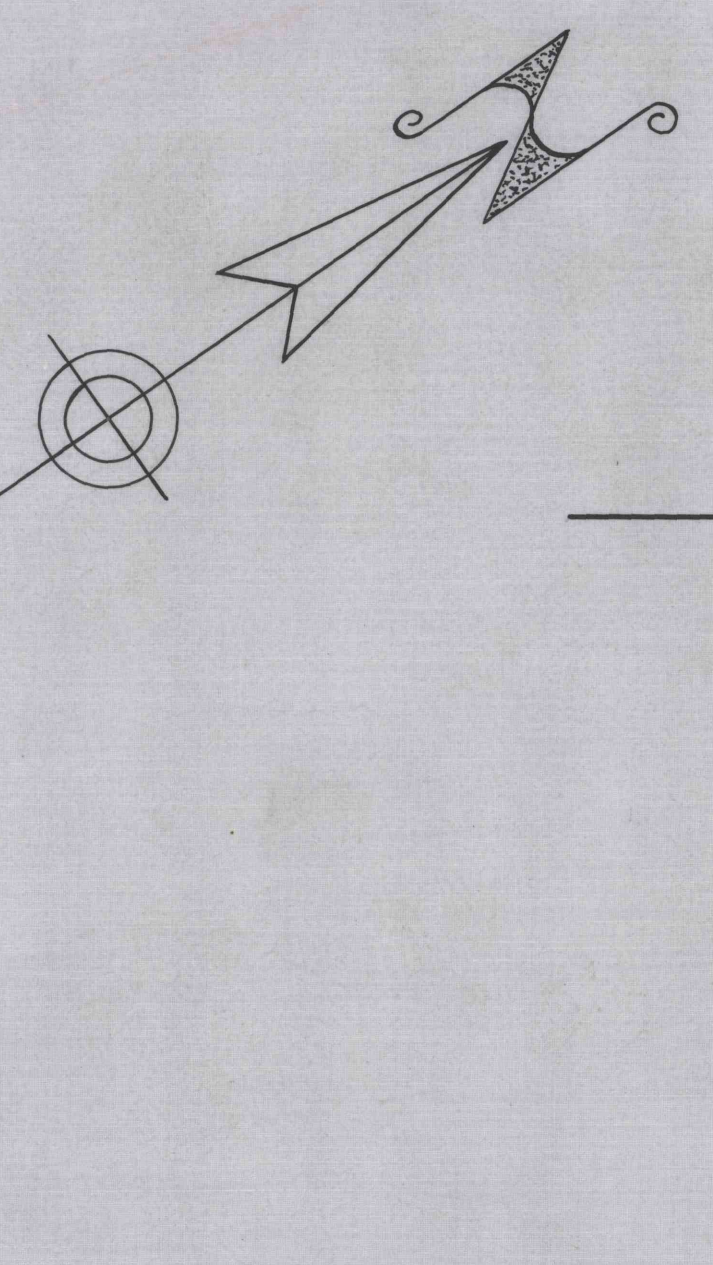

N.A.R. Co.  
(CLAY LEASE)

BIG SAVAGE FIRE BRICK Co.  
(CLAY LEASE)



NORTH AMERICAN REFRACTORIES COMPANY  
 SAVAGE MOUNTAIN FIRE CLAY PROPERTY AND MINE  
 FROSTBURG MD. SCALE 1"=100'

SURVEYED JULY 12-16, 1937  
 DRAWN BY W. F. S. CHECKED BY J. S. S.  
 CURWENVILLE Pa. Aug 6, 1937  
 INDEX No. 66-2-20