


6785

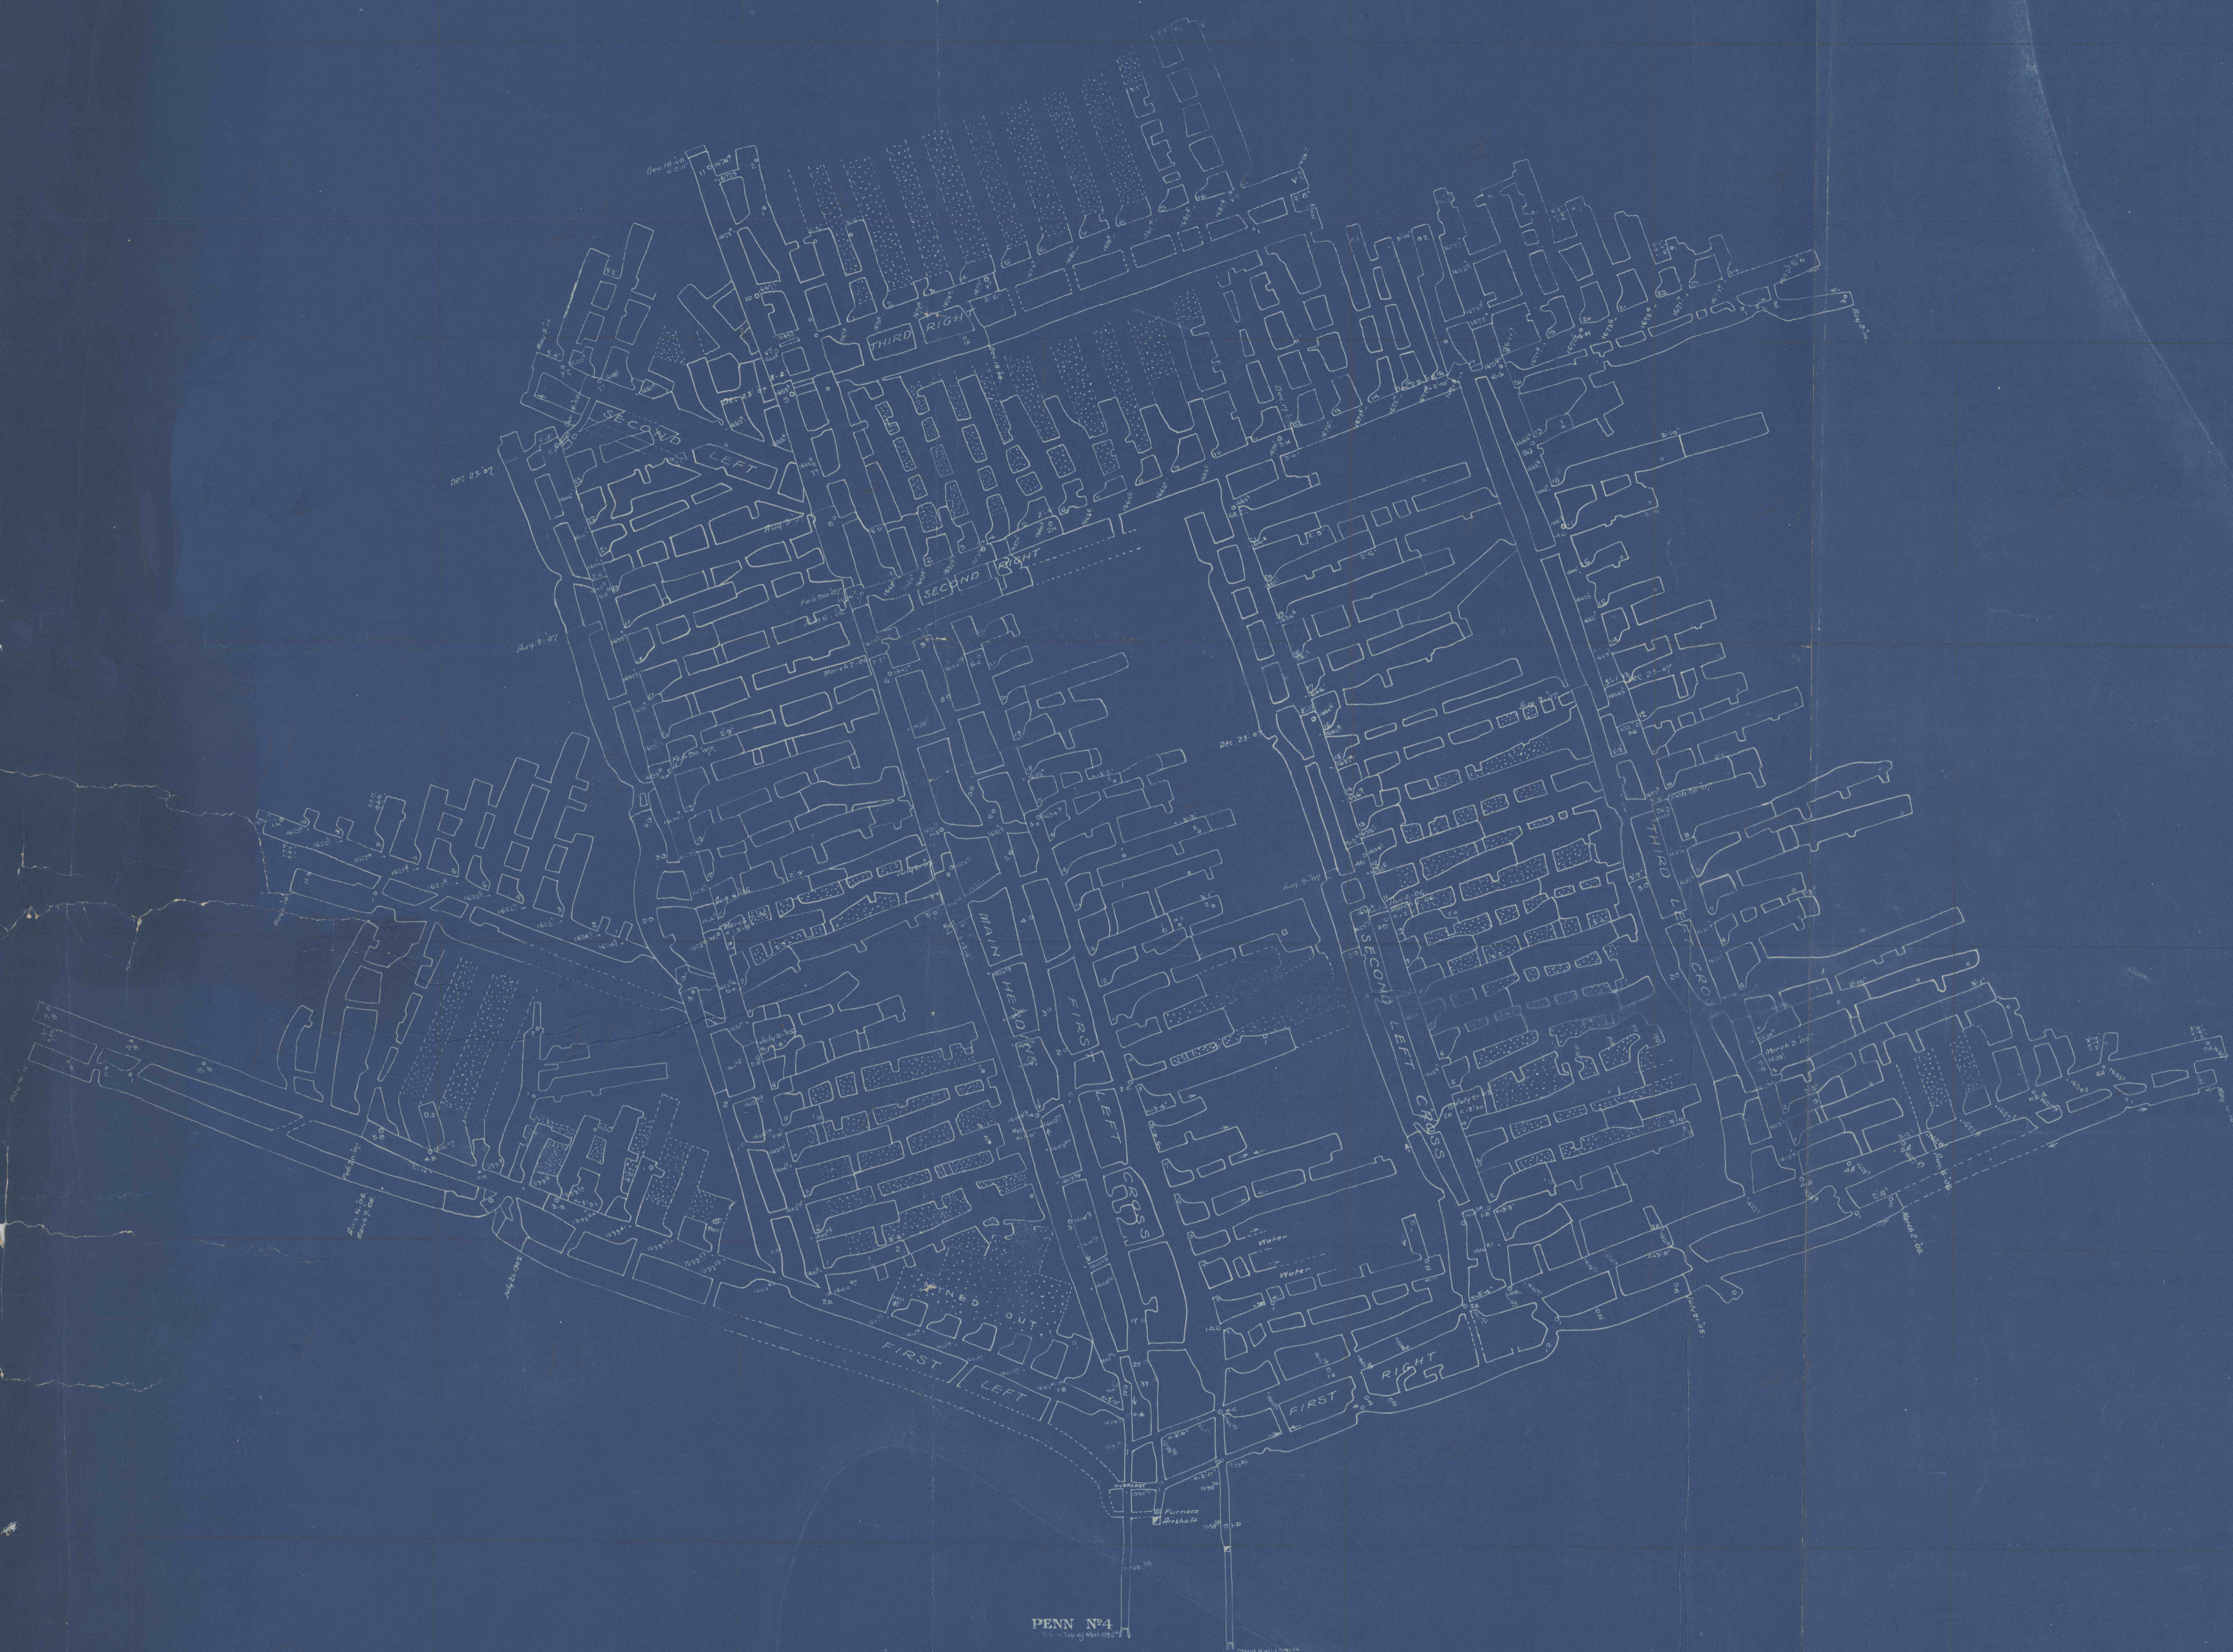

PENN N°4

D

MAP SHOWING PENN N°4 MINE  
 ON THE  
**PAUL ZANTZINGER TRACT**  
 OPERATED BY THE  
**Clearfield & Grampian Coal Company**  
 in Rush Township, Centre County, Pa.  
 Scale 1" = 100'

6785

95 (924) 6785