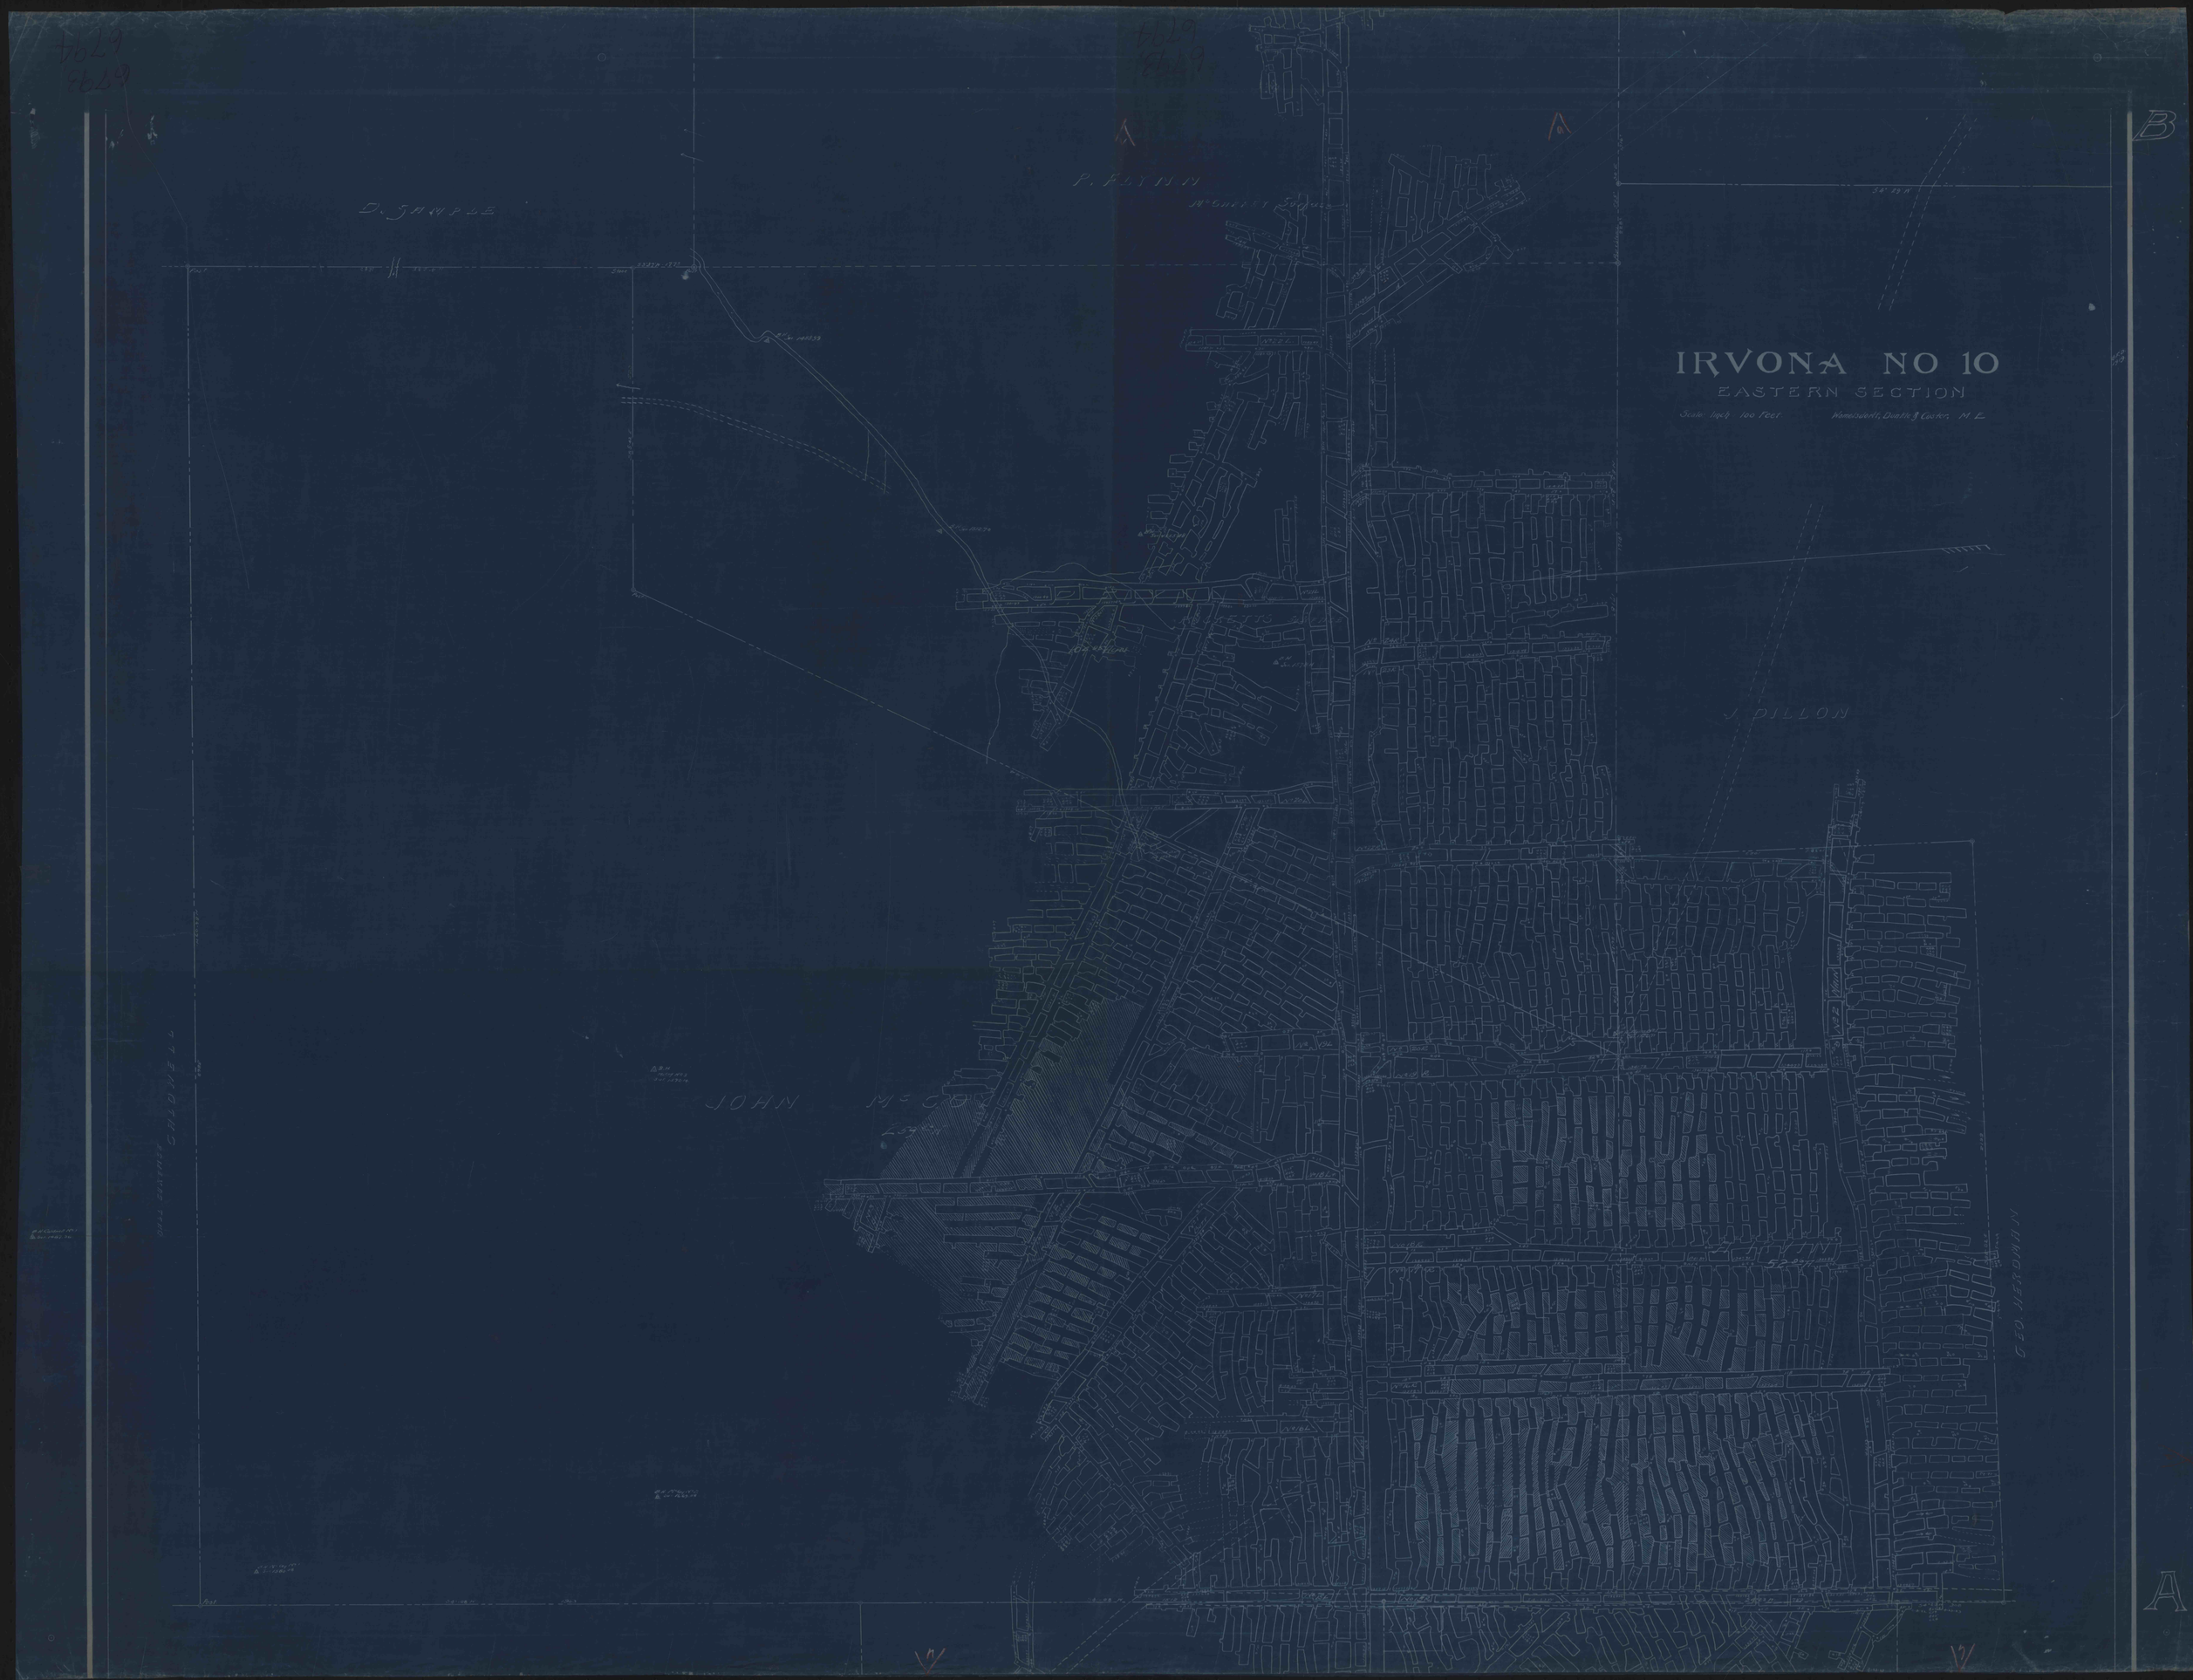
IRVONA NO 10
EASTERN SECTION
Scale: 1 inch = 100 Feet
Wamelsdorff, Dunkle & Coster, M.E.
D. SAMPLE
P. FLYNN
J. DILLON
JOHN McCO
GEO. HERDMAN
B
A