

6802  
6803

J. W. REITER, JR.


REITER  
Not OWNED

J. REITER

KARTHAUS ESTATE

WM. HOFFER EST.

SCHNARRS

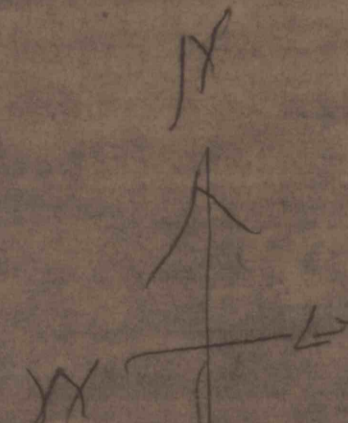

SCALE  
1" = 100'

POTTER, BIGLER & POTTER  
MAP

SHOWING CROP LINE AND BORE HOLES  
ON THE

KARTHAUS ESTATE

COVINGTON TWP., CLEARFIELD CO., PA.

SCALE 1" = 100'

MINE ADDED DEC. 24, 1922  
OCT. NOV. 1923  
MAY 12, 1925 (CONCL.)

CLEARFIELD, PA. OFFICE OF E. W. HESS,  
ENGINEER

6802  
6803

MAP FOR  
TO [unclear]