


8558  
8558

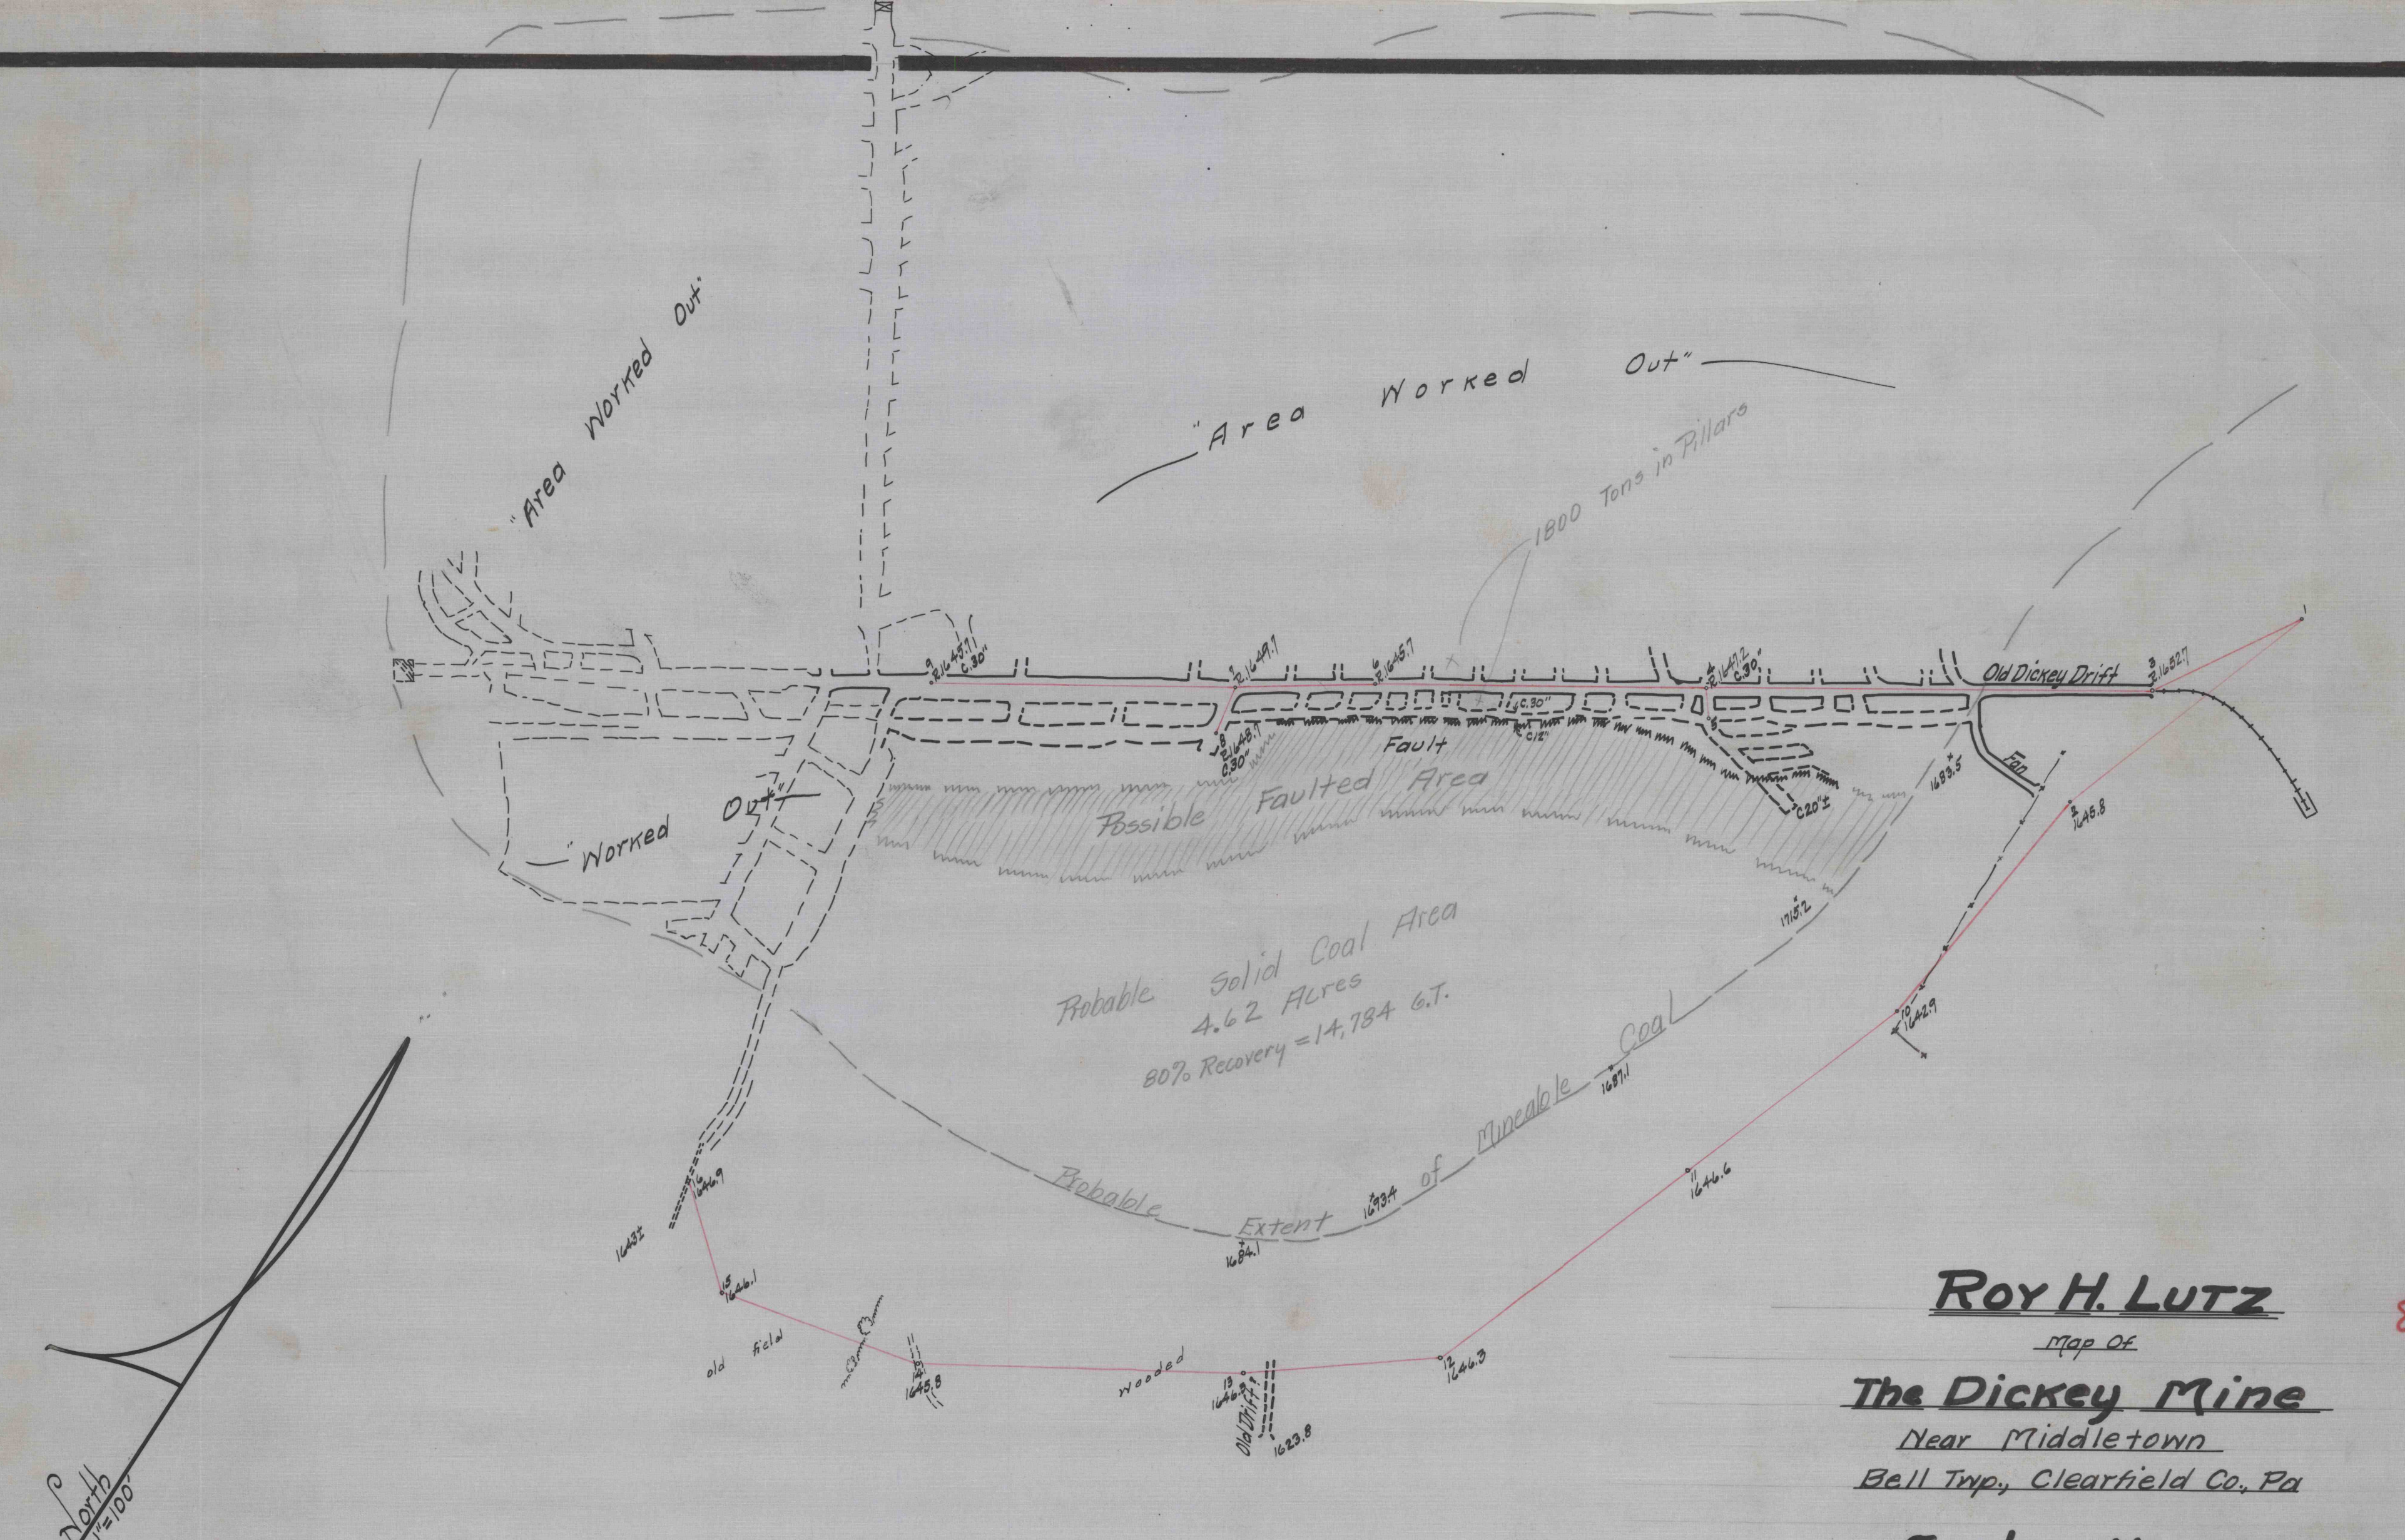

**Roy H. Lutz**

D  
8267

Map of  
**The Dickey Mine**  
Near Middletown  
Bell Twp., Clearfield Co., Pa

**Scale - 1 in = 100 ft.**

Sept. 17, 1949  
Clearfield, Penna.  
Engineering Offices  
West. Bromfield & Heas  
Supt. & File

6932