

5700


MAP SHOWING  
 MINE WORKINGS & SURFACE FEATURES  
 OF THE  
 CHESTNUT RIDGE MINING CO.  
 IN  
 BELL TWP., CLEARFIELD CO. PENNA.

SCALE 1"=100'

APR. 5, 1921

CLEARFIELD  
 COUNTY

Stanislaus  
 Wesniesky (Surface)  
 M. H. C. M. Co. Coal Mining Rights.

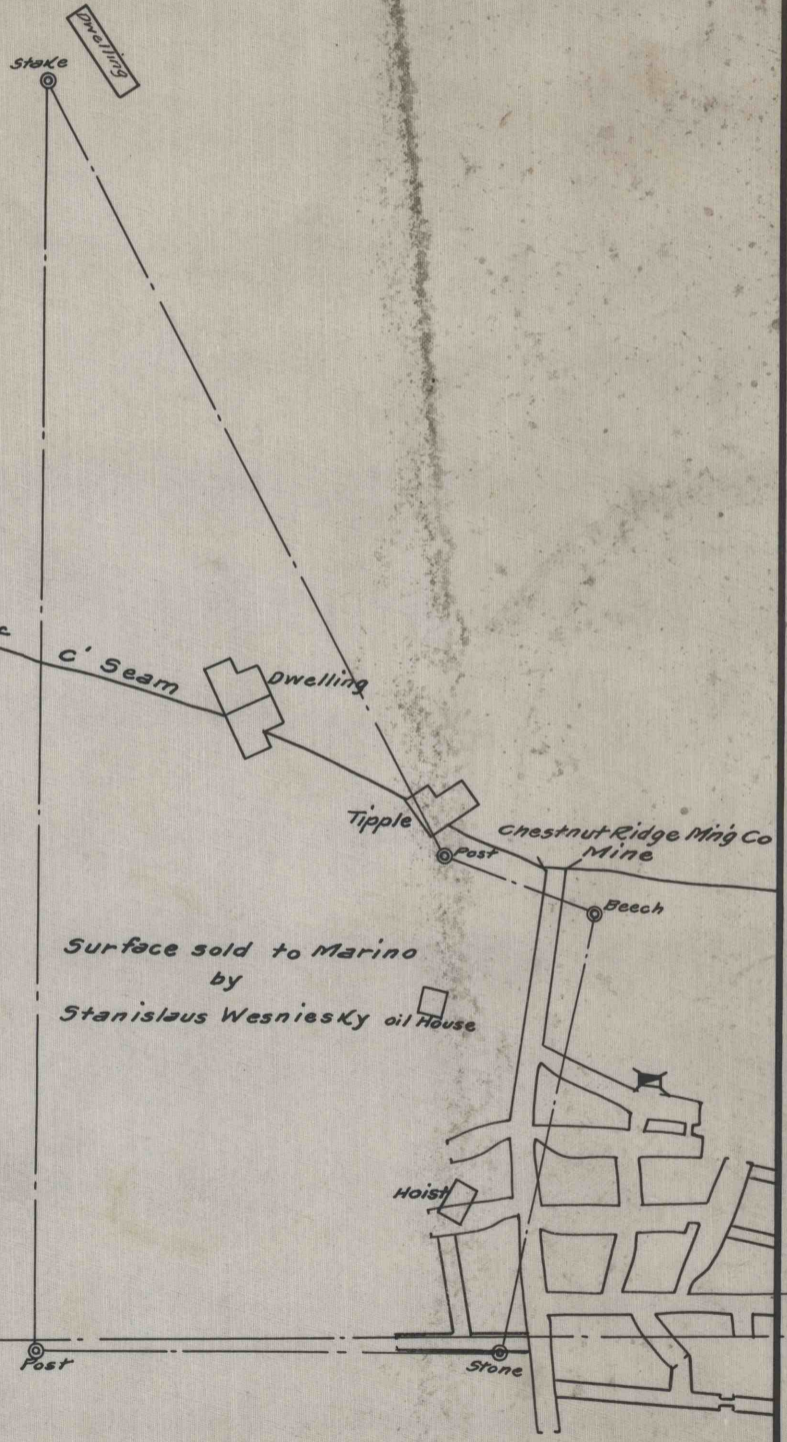

James & Esther McGee

D  
 8237

EXHIBIT-B

6972

5700