


HARRY GRAHAM

JOSIAH W. SMITH, EST.

JEROME R. WILSON

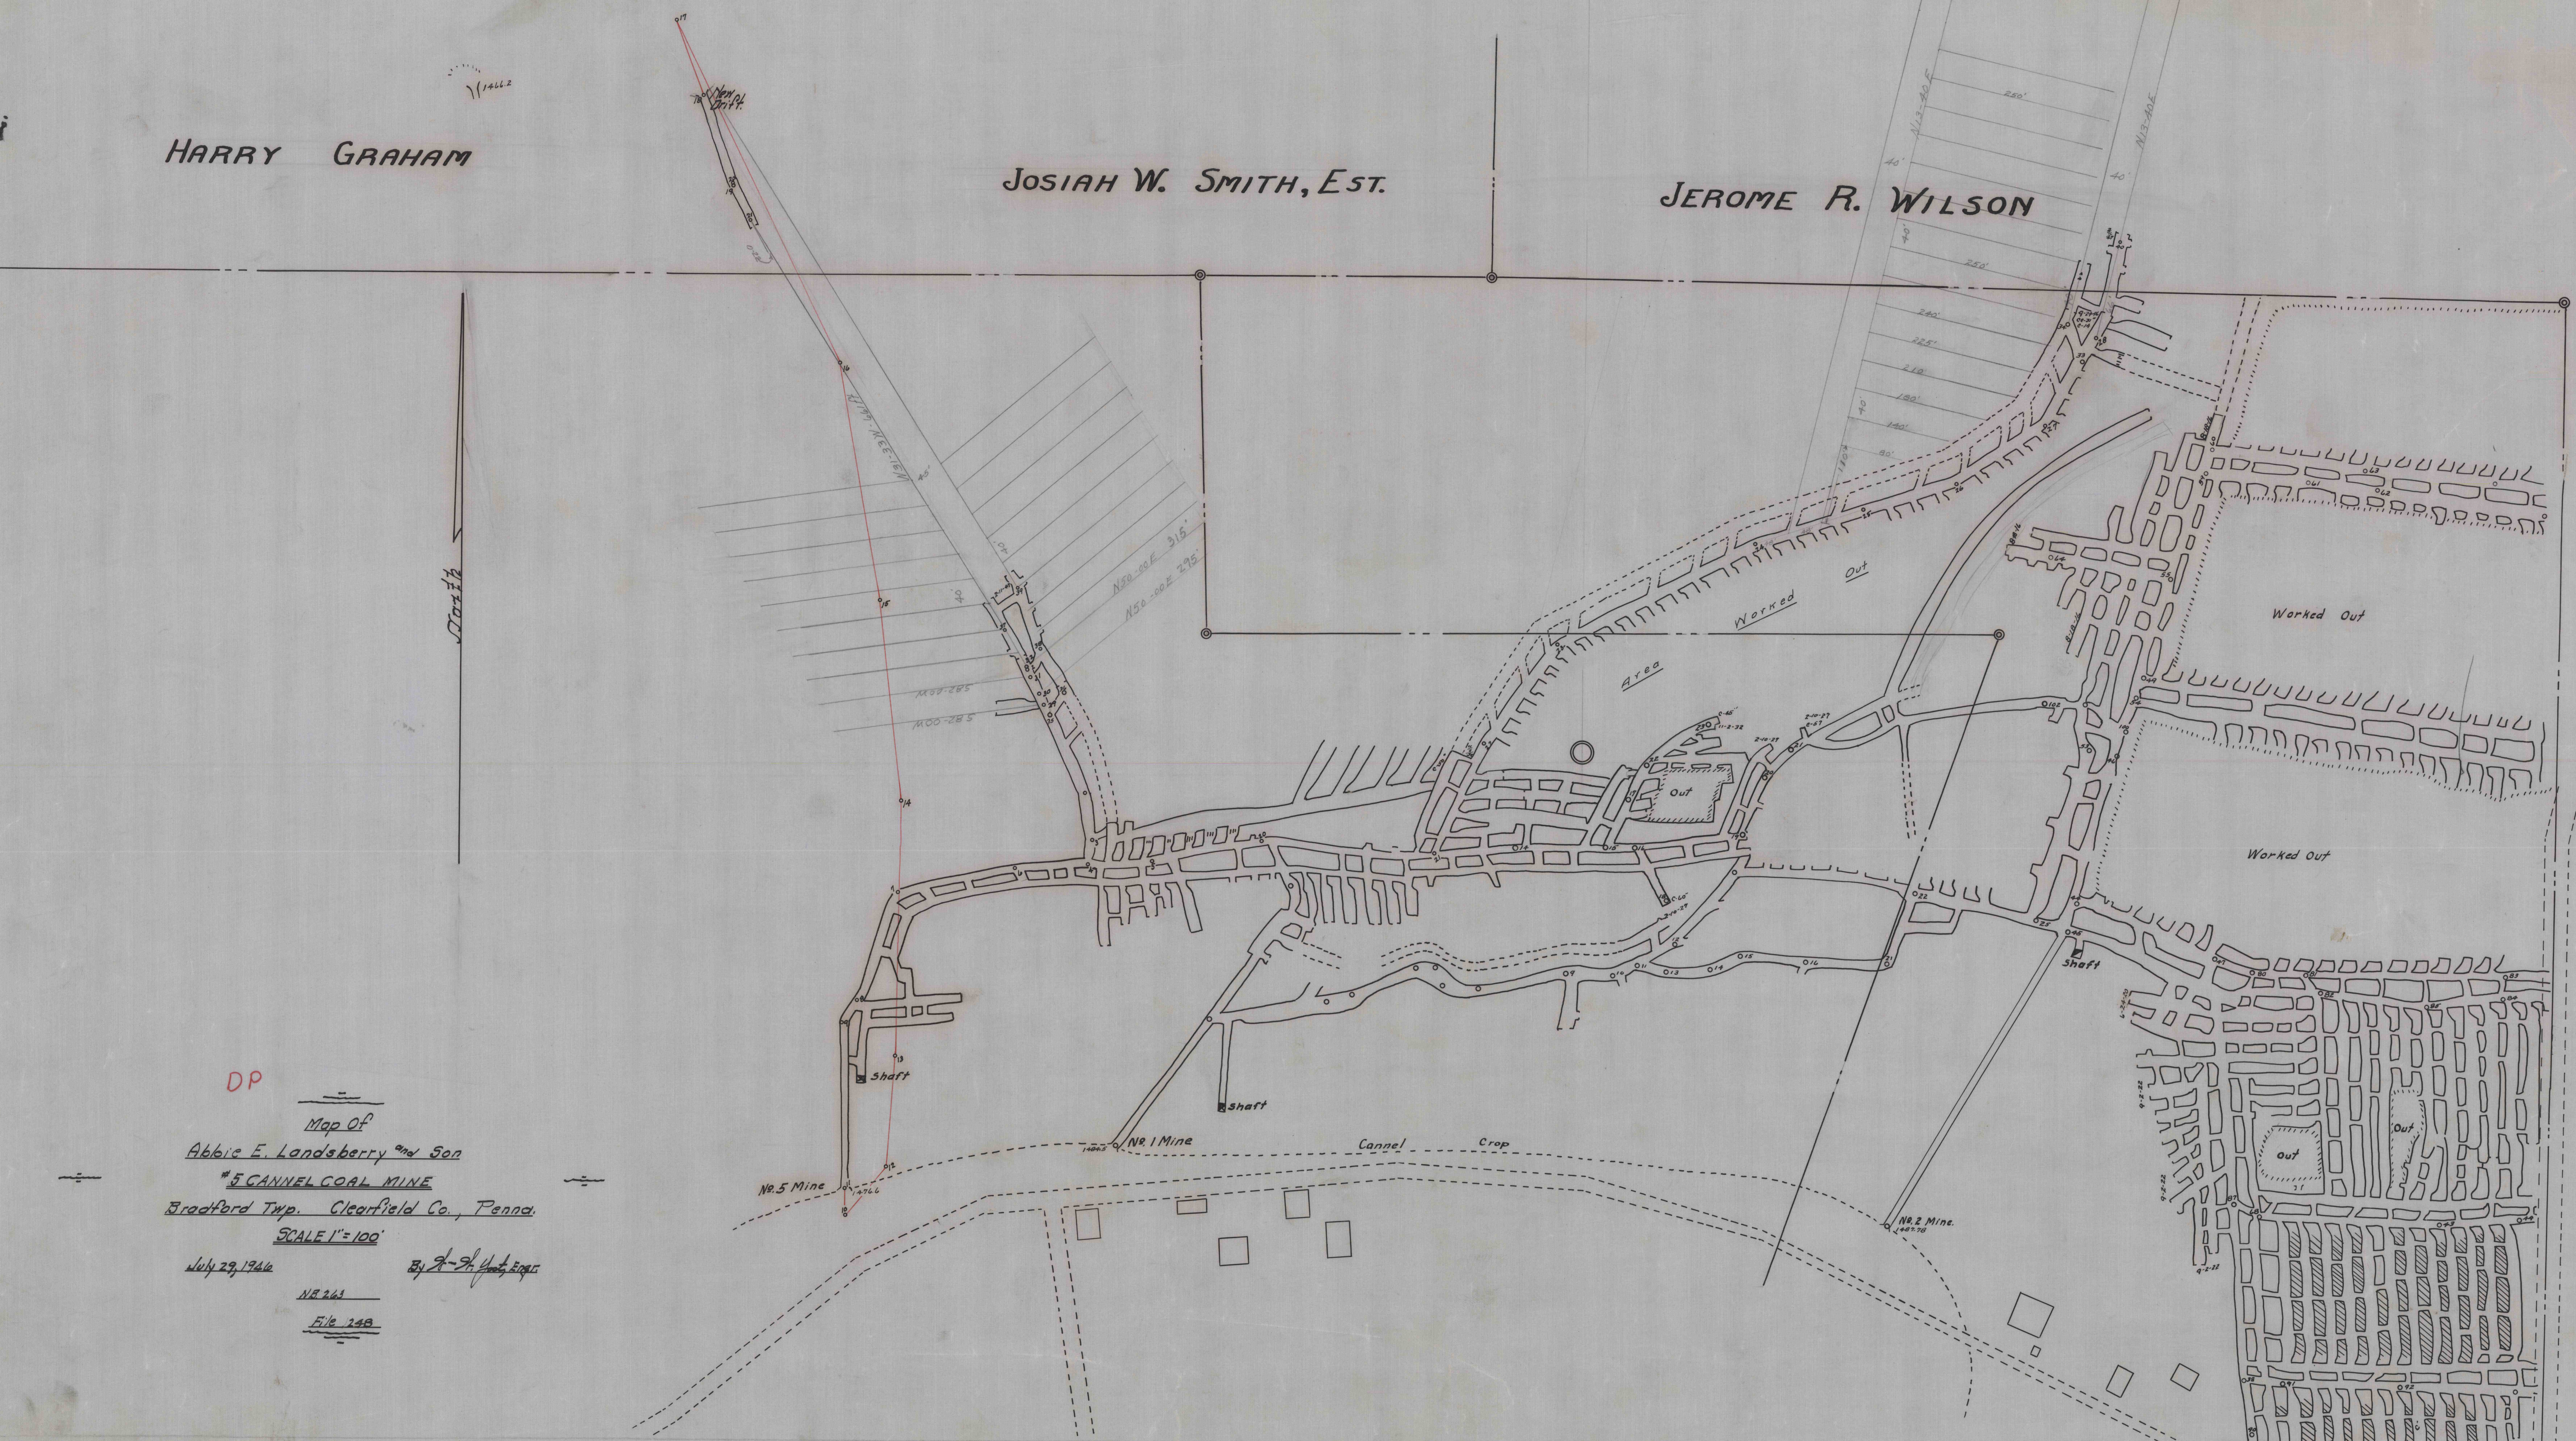

DP

Map of
 Abbie E. Landsberry and Son
 #5 CANNEL COAL MINE
 Bradford Twp. Clearfield Co., Penna.

SCALE 1"=100'

July 29, 1944

By J. H. Smith, Engr.

NR 261

File 24B