


A. B. SHAW EST.



MILLARD KYLER
 SHAWVILLE, PA.
 MAP OF MINES
 GOSHEN TWP CLFD CO., PA.
 SCALE 1"=100'

CLEARFIELD, PA. ROY C. KINDIG
 MAY 25, 1953 REG. ENGR.

*Levels run in 1st Right and
 new Kyler mine only*

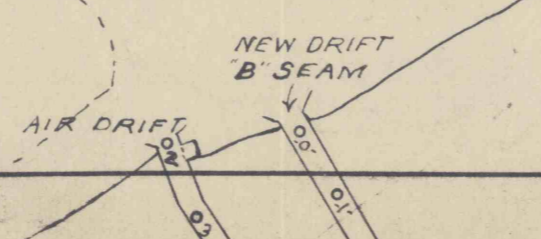

X-0278

7358

7358