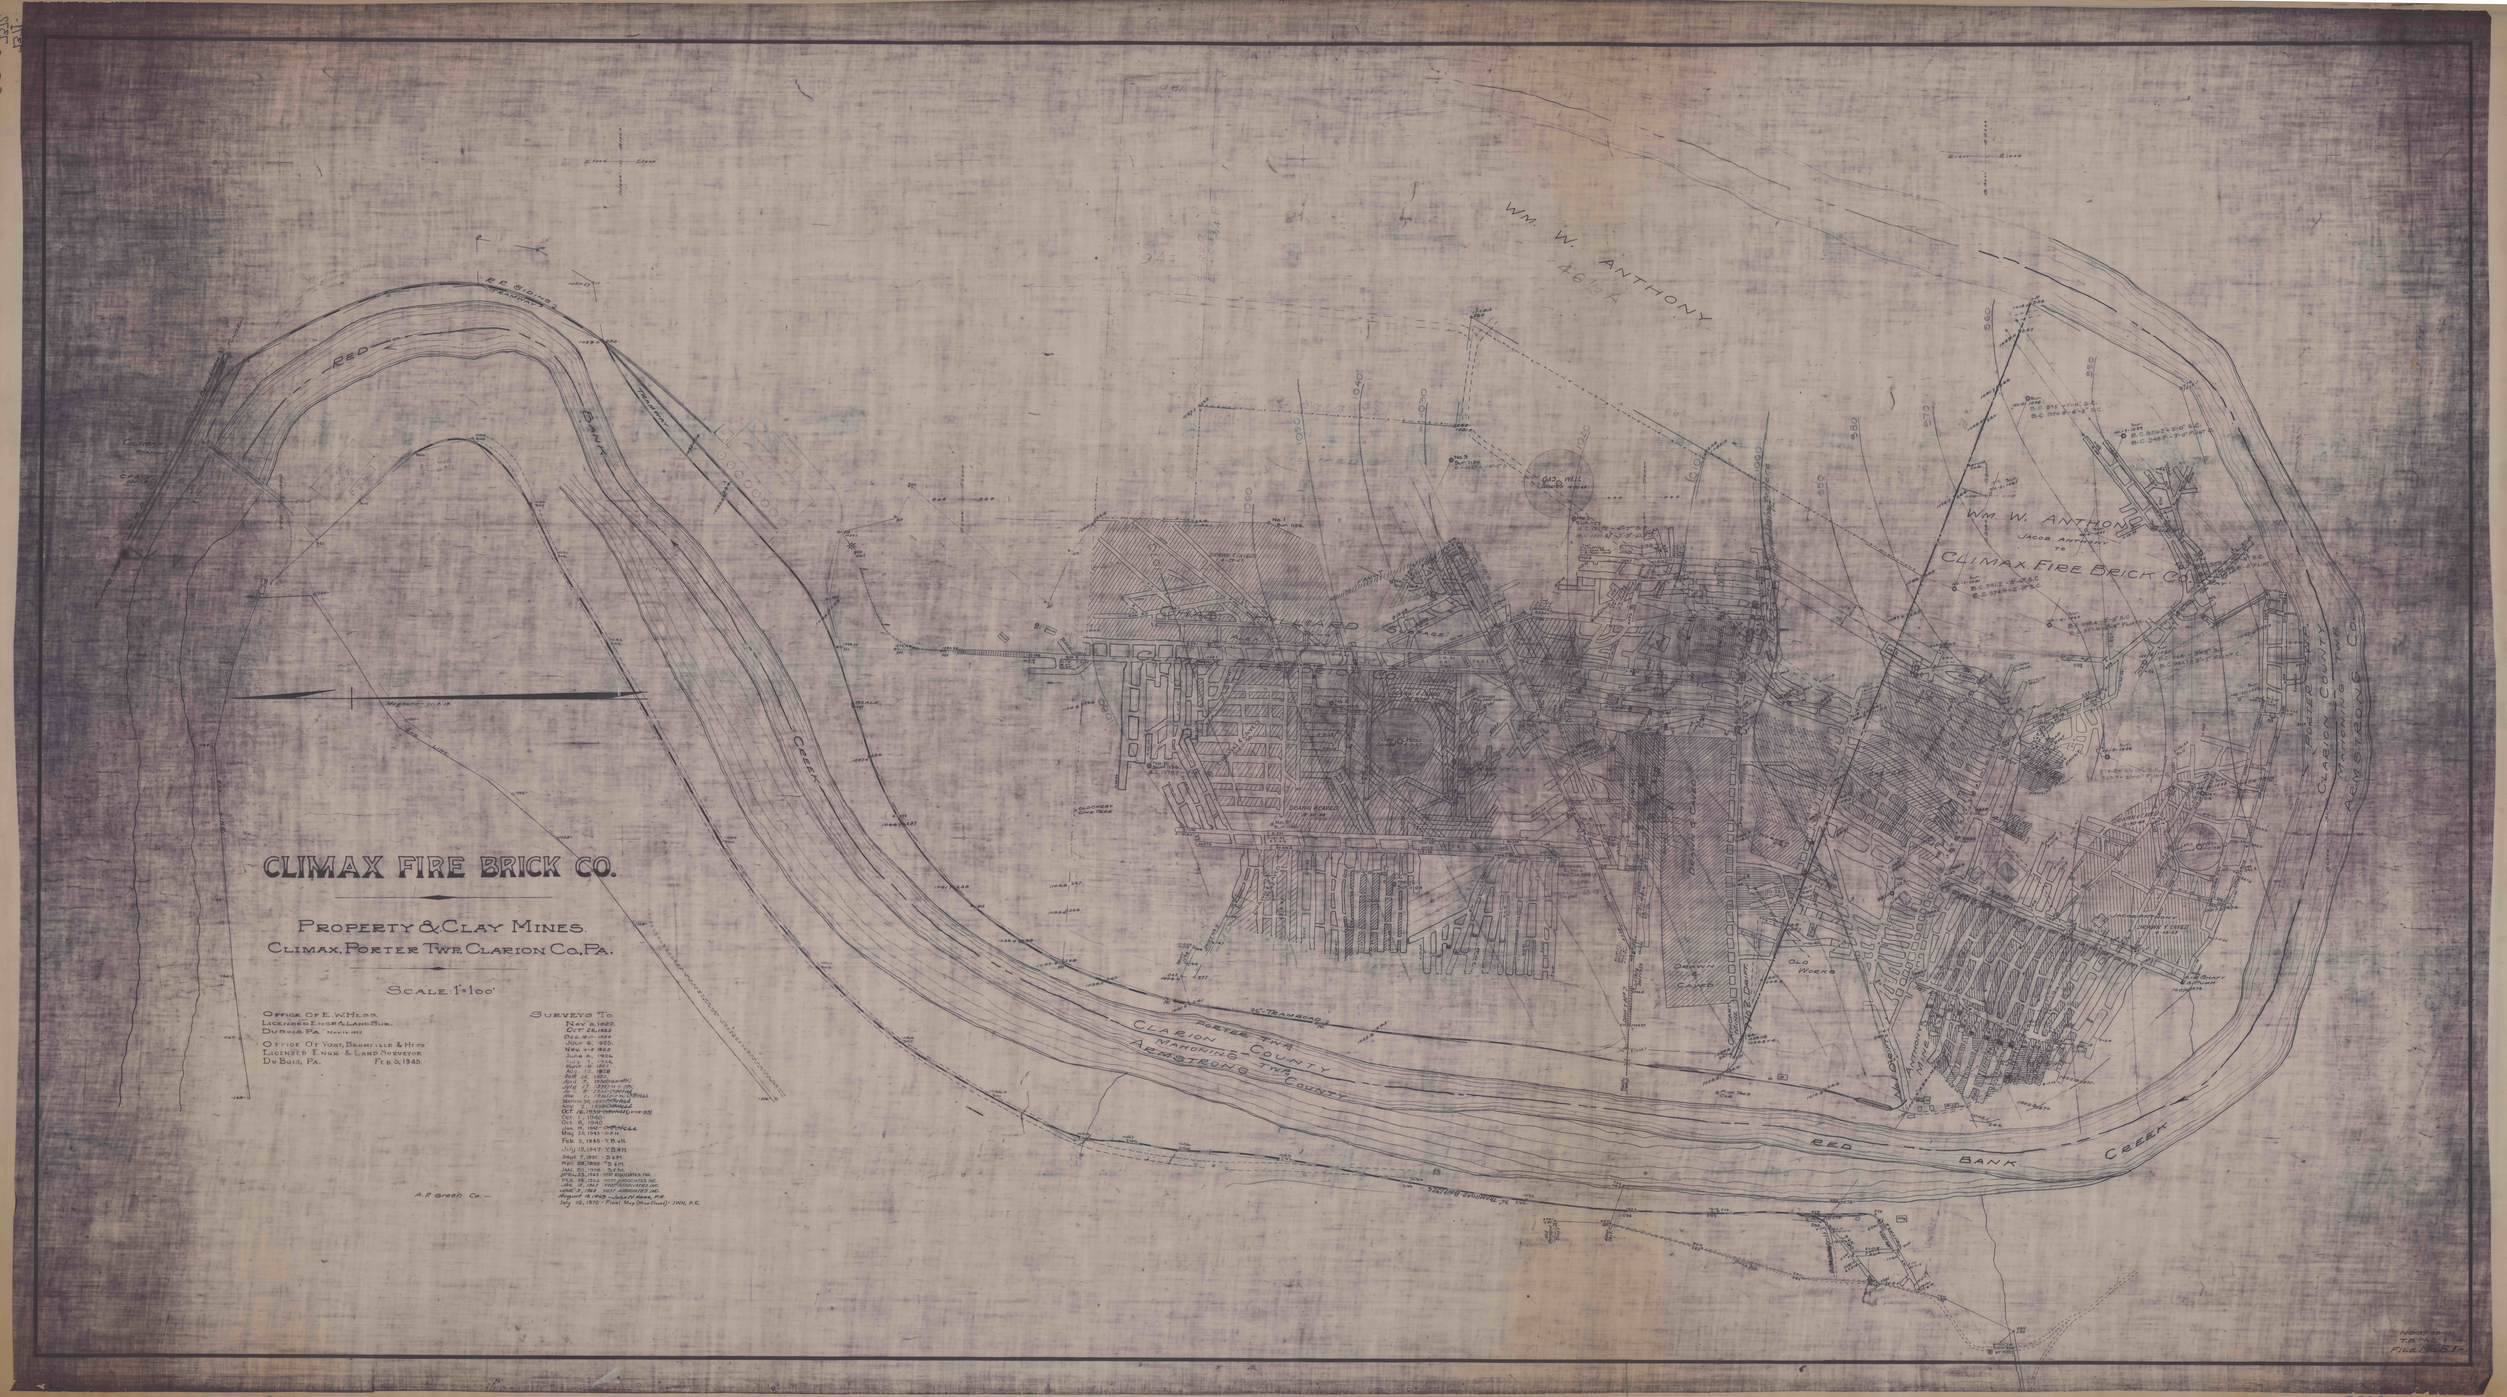
CLIMAX FIRE BRICK CO.
PROPERTY & CLAY MINES.
CLIMAX, PORTER TWP. CLARION CO., PA.
SCALE: 1" = 100'
OFFICE OF E. W. HILES
LICENSED ENGR. & LAND SUR.
DUBOIS, PA.
OFFICE OF YOST, BRUMFIELD & HYDE
LICENSED ENGR. & LAND SURVEYOR.
DU BOIS, PA.
FEB. 5, 1945
SURVEYS TO
A. P. Green Co.
WM. W. ANTHONY
WM. W. ANTHONY
JACOB ANTHONY
TO
CLIMAX FIRE BRICK CO.
RED BANK CREEK
PORTER TWP.
CLARION COUNTY
MAHONING TWP.
ARMSTRONG TWP. COUNTY
PORTER TWP.
CLARION COUNTY
MAHONING TWP.
ARMSTRONG CO.
OLD WORKS
GRAVEL PIT
OLD WILL
Jacob Anthony
Wm. W. Anthony
Nov. 6, 1922
Oct. 16, 1923
Dec. 1, 1923
Nov. 4-9 1923
June 21, 1926
July 2, 1926
Apr. 11, 1928
Mar. 12, 1930
July 2, 1930
Mar. 1, 1931
Mar. 30, 1931
Oct. 16, 1939
Oct. 1, 1940
Oct. 8, 1940
May 24, 1943
Feb. 3, 1945
July 13, 1947
Sept. 7, 1951
Apr. 28, 1952
July 23, 1952
Feb. 18, 1953
Jan. 7, 1957
August 4, 1958
July 10, 1970 - Final Map (Blue Print) - JWH, P.E.
FILE/JWH.E.P.

7371

7372