


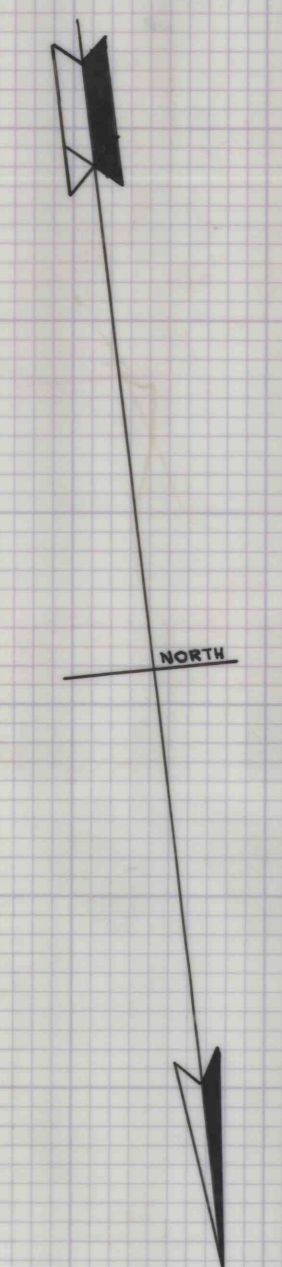

47 ACRES WITHIN CROPLINE



7648

DATE	REVISION	BY	DATE	REVISION	BY

U.S. REFRACTORIES CORP. MITCHELL #1 MINE  NOV. 1922, BARRETT, PA		
<b>HESS &amp; FISHER ENGINEERS, INC.</b> CONSULTING ENGINEERS & GEOLOGISTS 36 NORTH SECOND STREET CLEARFIELD, PA. 16830 814-765-7541		
DRAWN BY: F.R.R.	DATE: 2-15-83	FILE NO.:
CHECKED BY: M.A.	SCALE: 1" = 100'	JOB NO.:
APPROVED: _____ DATE: _____ REG. NO.: _____	ENGINEER DATE: _____	SEAL SHEET OF F.B. NO.: