


551

776

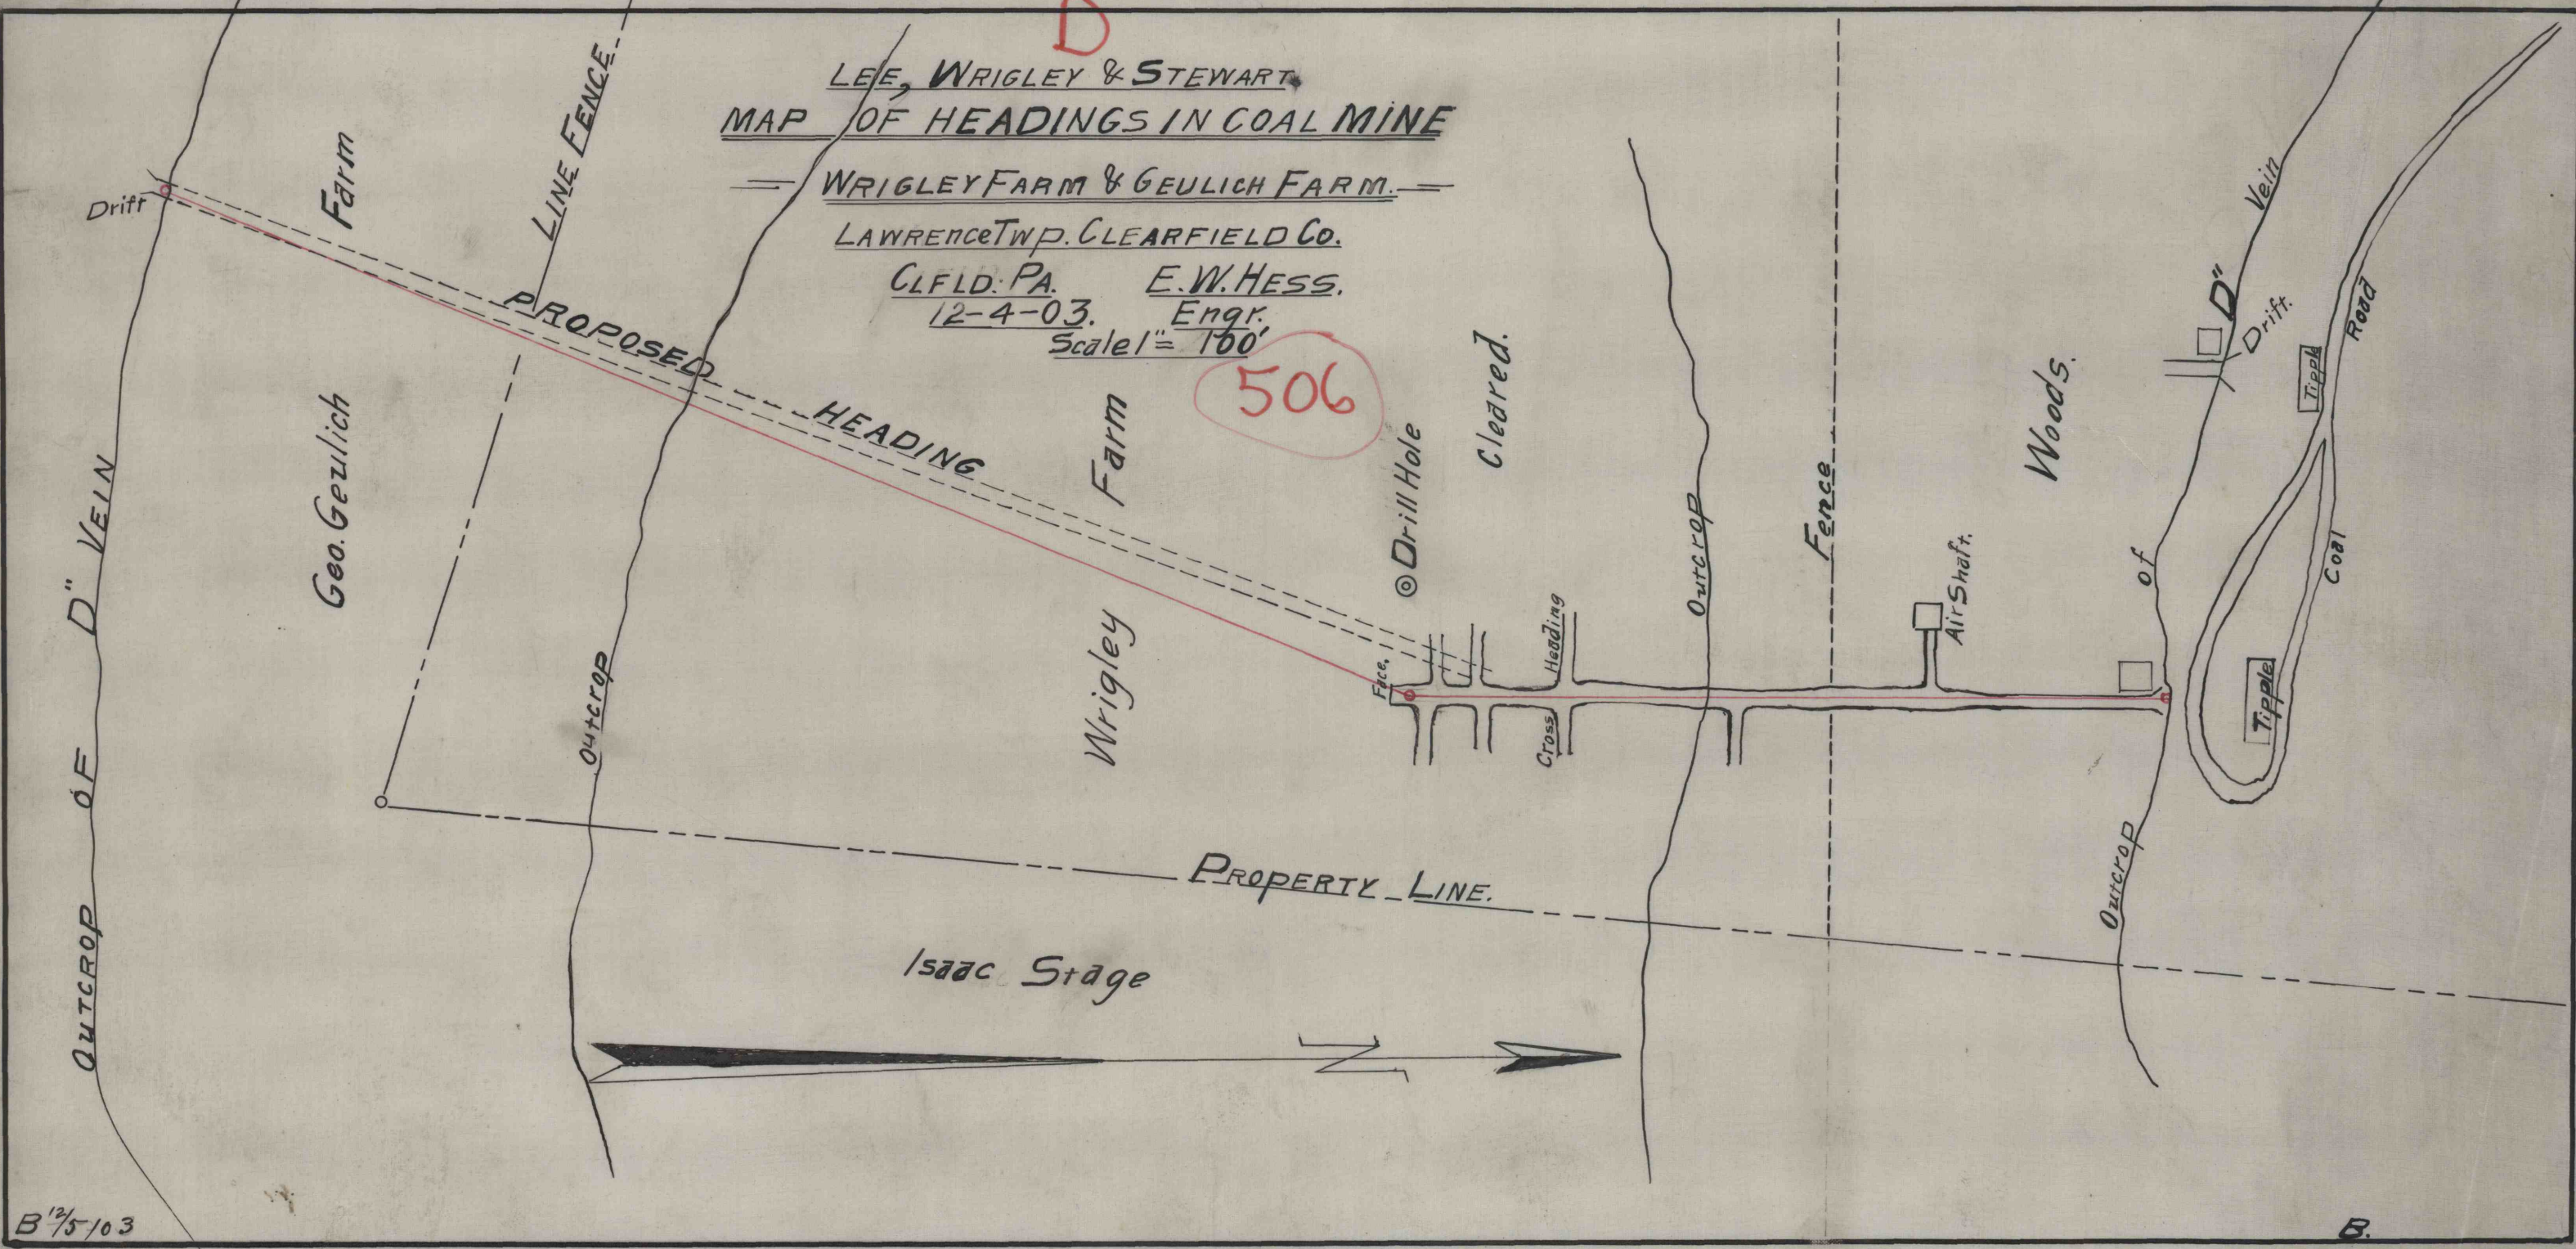

B¹²/5/03

D.