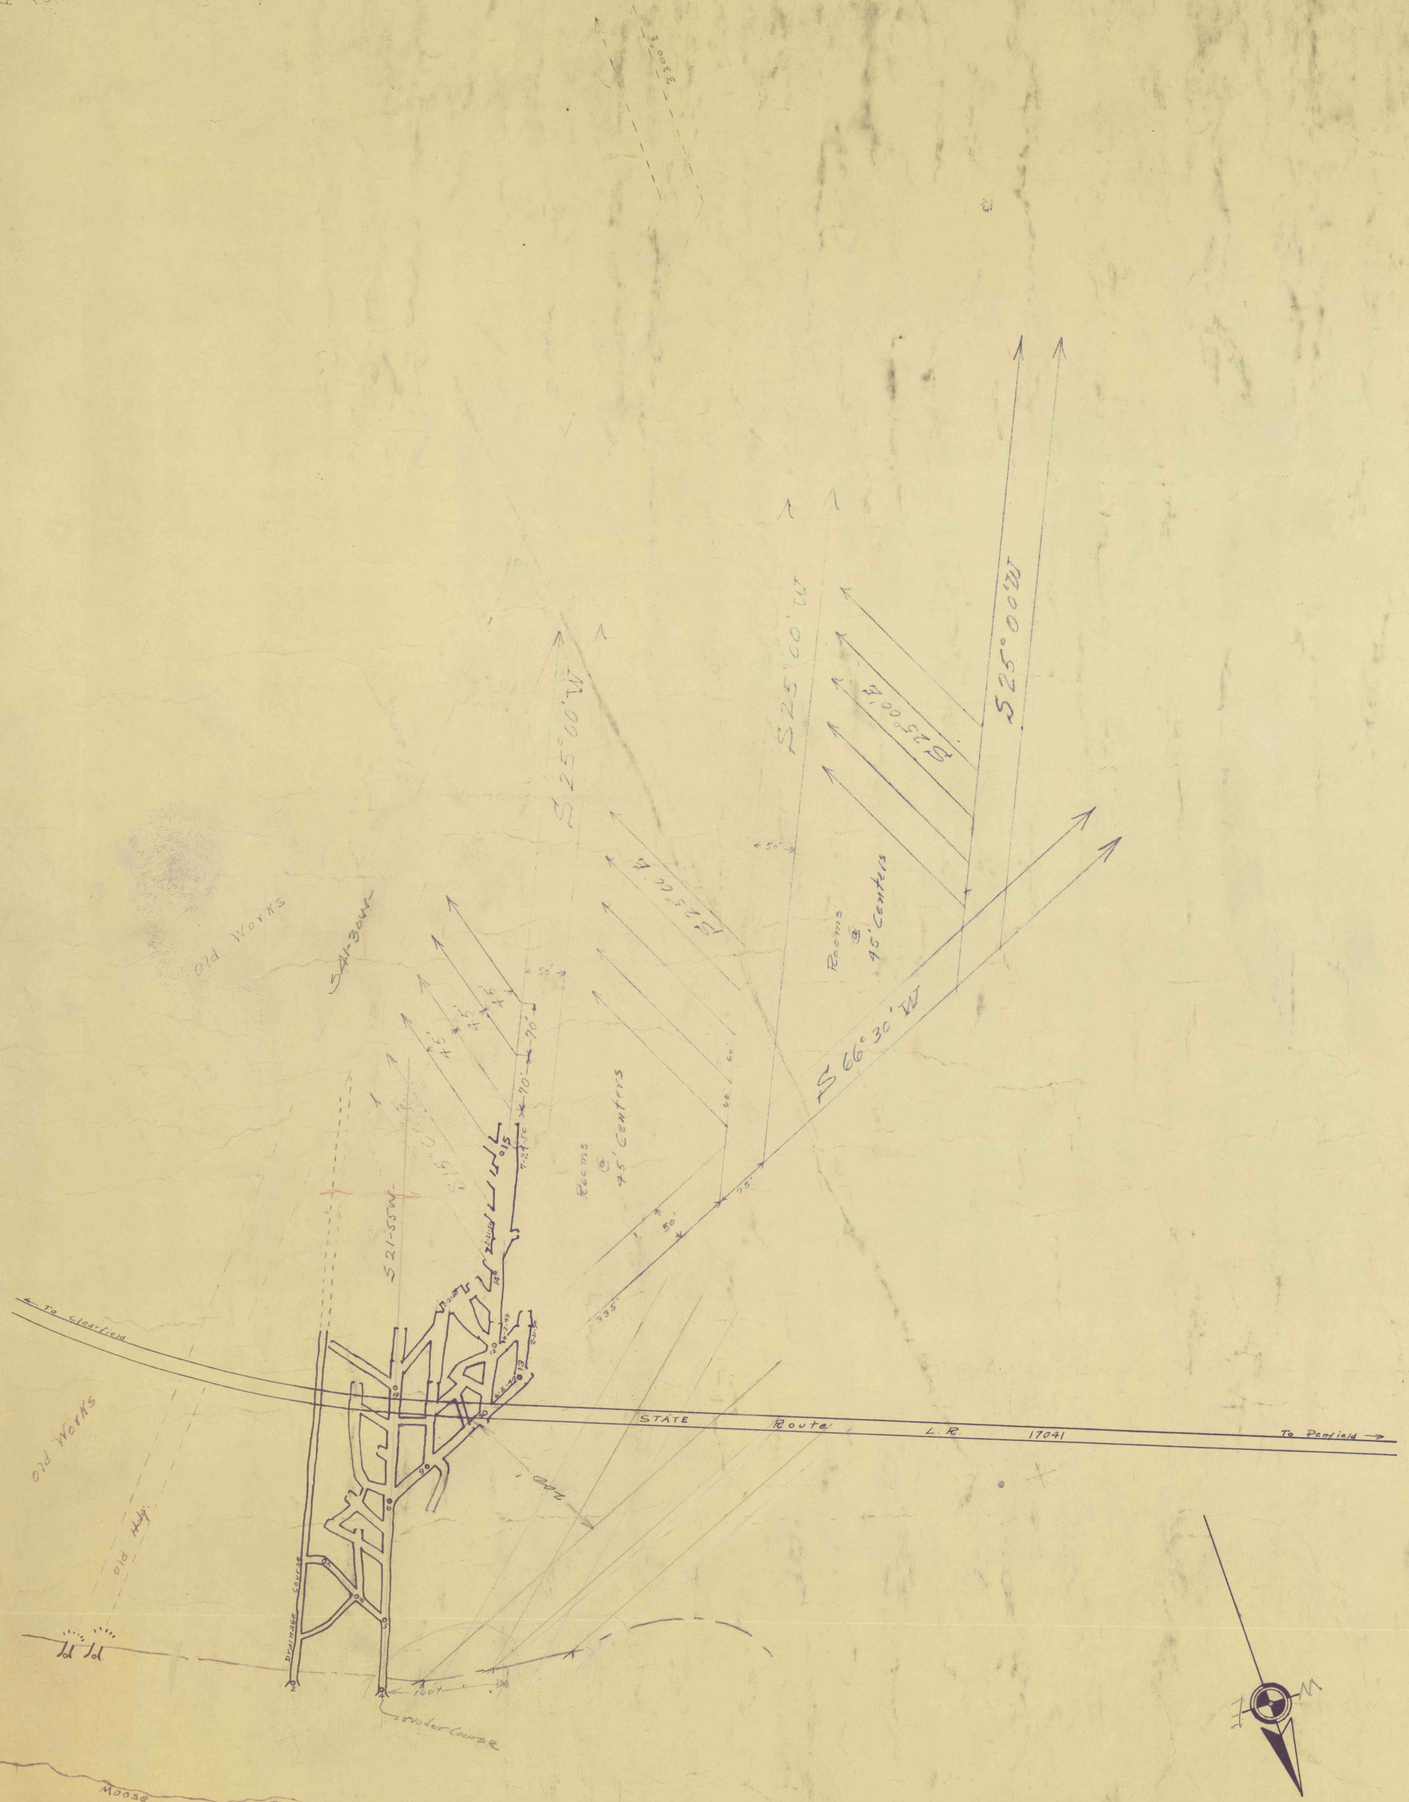

MINE MAP

P. & N. COAL CO.

PENFIELD MINE

HUSTON TWP., CLEARFIELD COUNTY, PENN'A.

SCALE 1" = 100' APRIL, 1949

Walter J. Zimmerman, Engineer - Surveyor, Punxsutawney, Pa.

A-0330

7889