


1108
802

1108
802

WALLACE TRACT - H. B. SWOOPE ESTATE

H. B. SWOOPE ESTATE

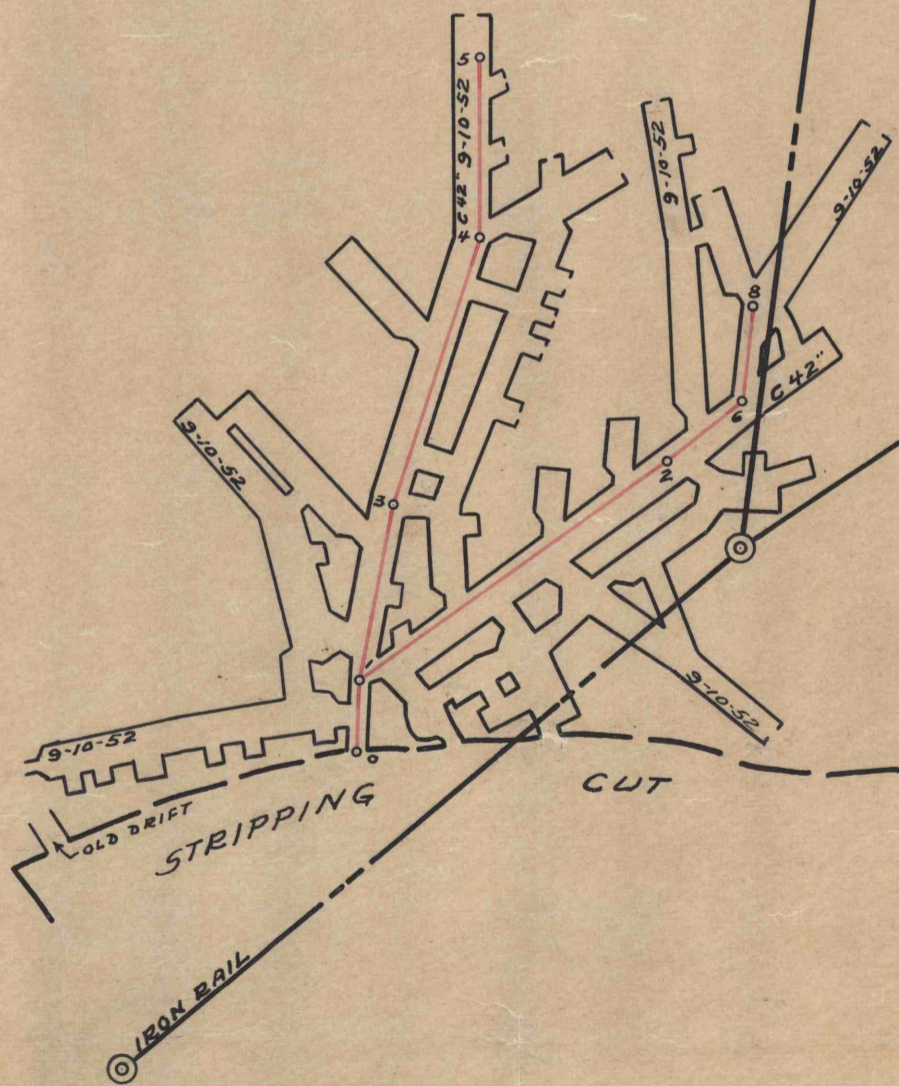

HAGARTY TRACT - SWOOPE & GATEHOUSE



D
8011

— MAP OF "D" SEAM MINE —
 — OPERATED BY FUNDAK BROS. —
 — BIGLER TWP. CLEARFIELD COUNTY PA. —
 — SCALE 1" = 100' — — OCT. 1, 1952 —
 — BERNARD LUCAS ENGR. —

1108

7937