
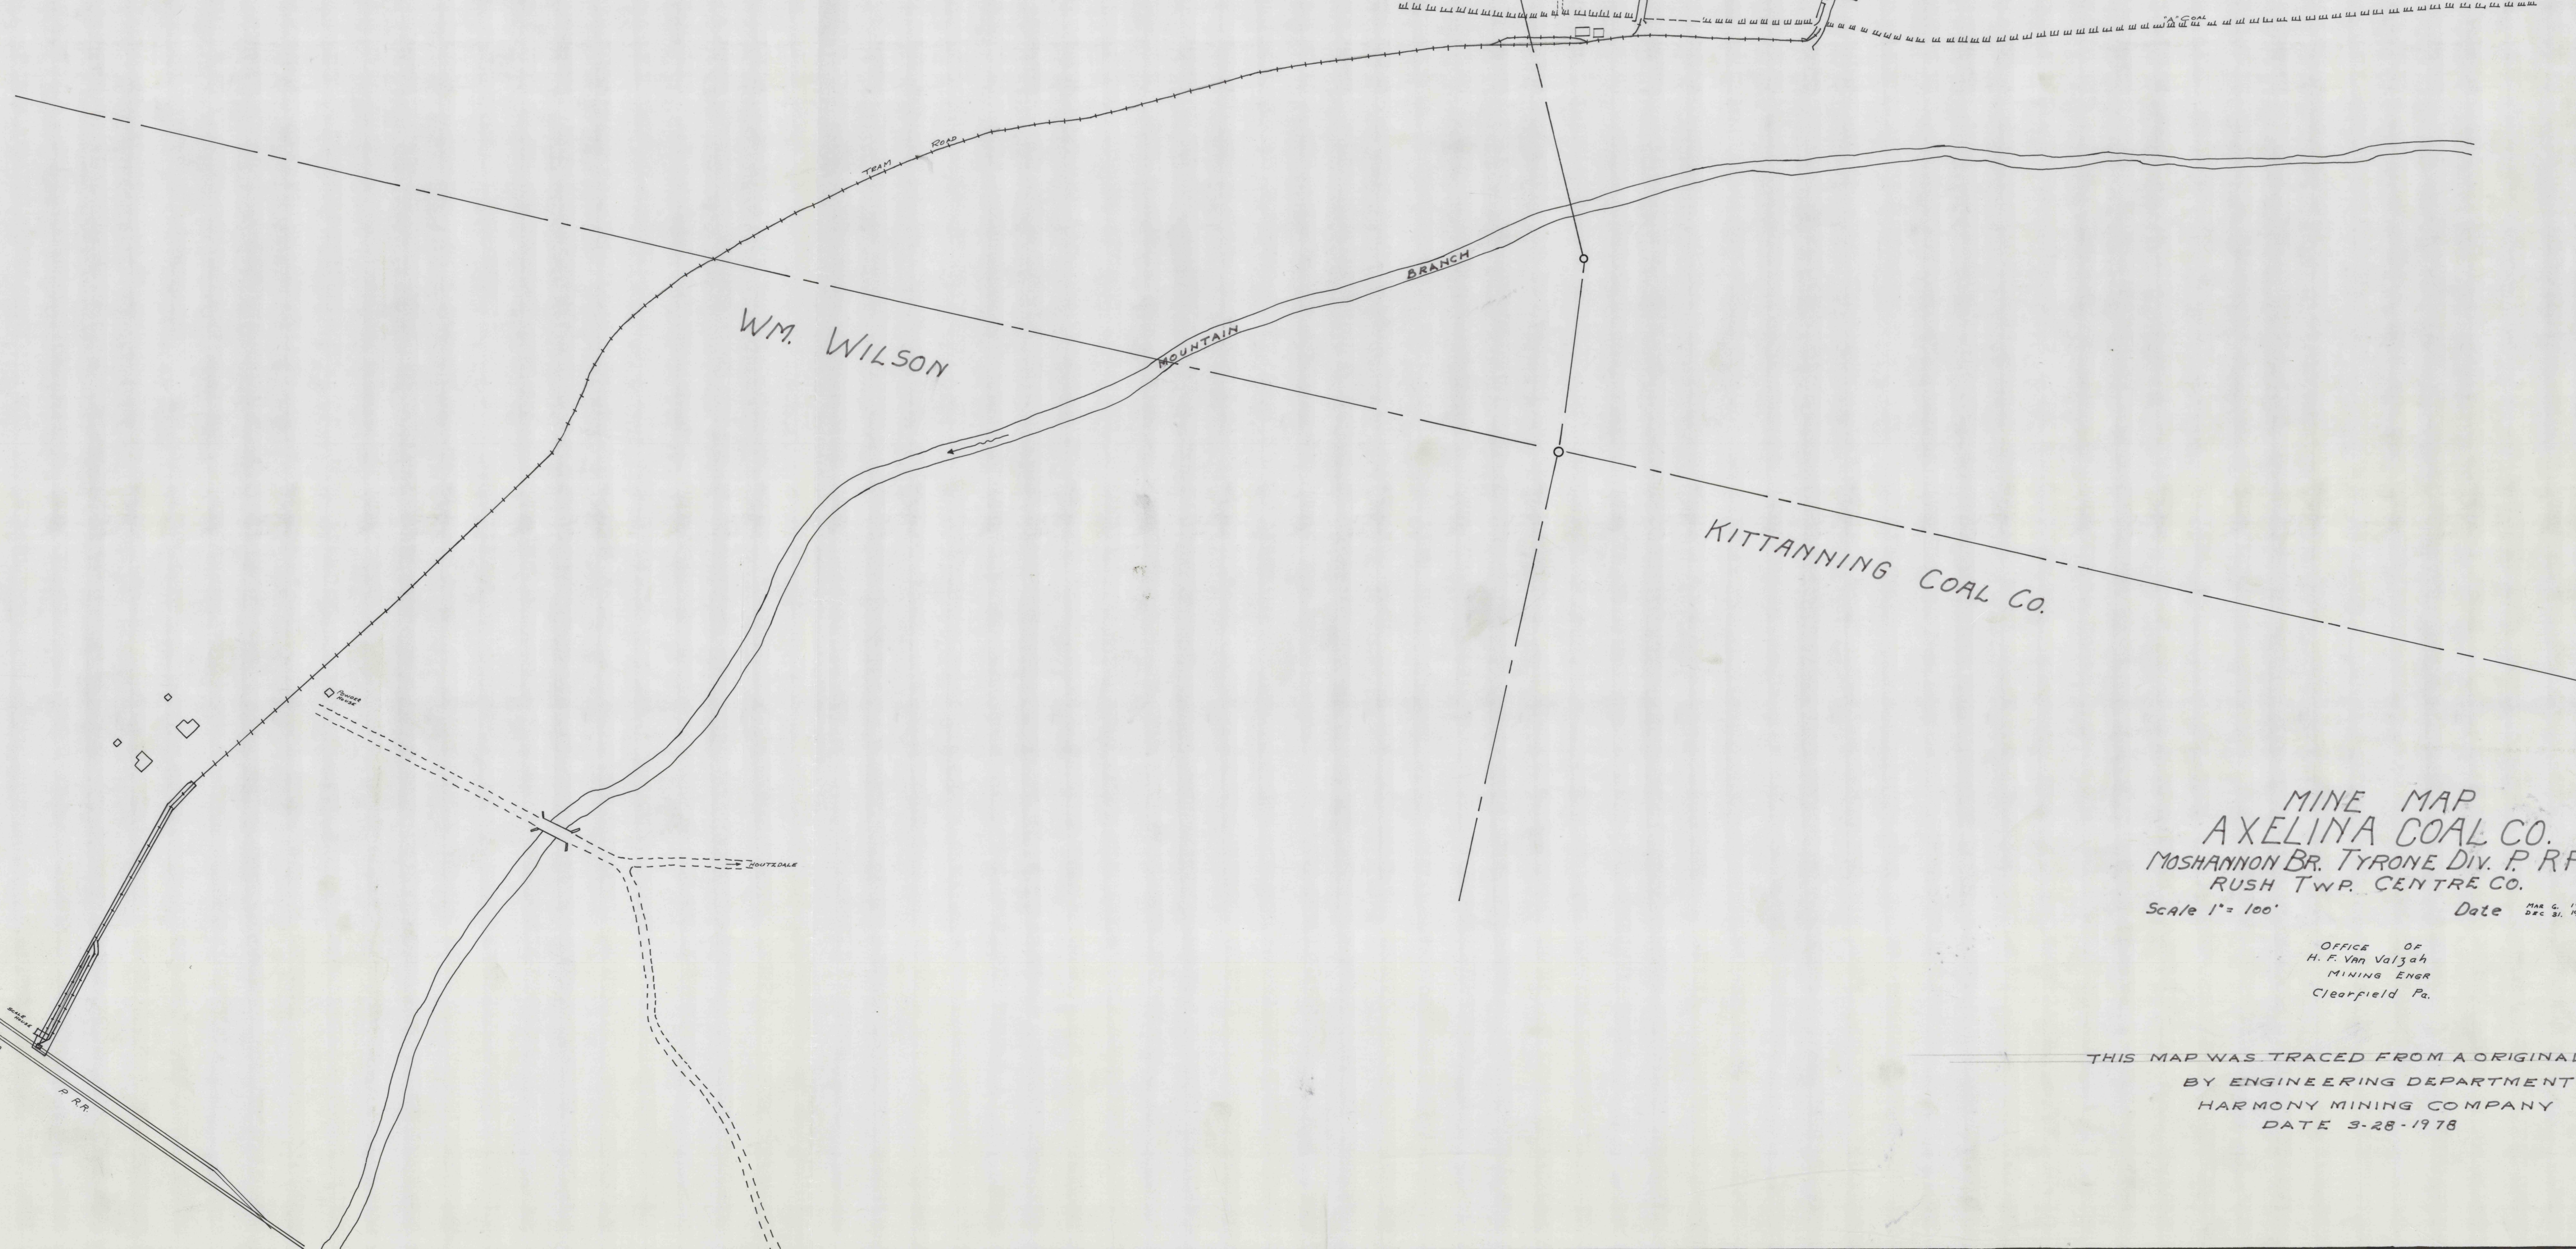
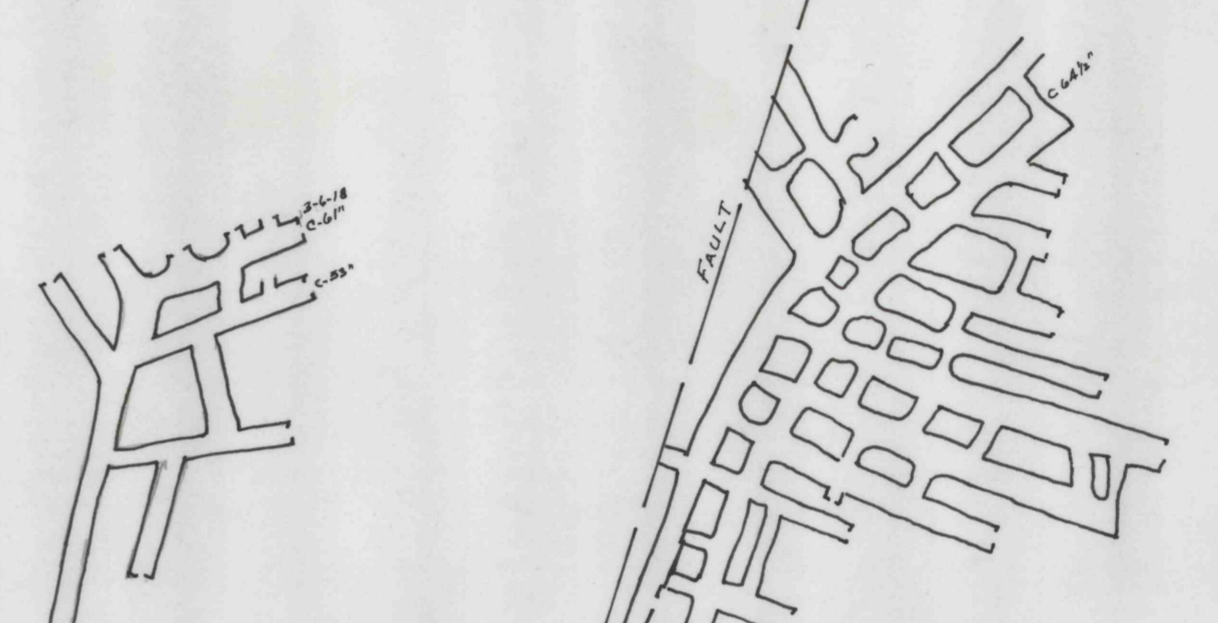


PHILPSBURG COAL & LAND CO.

PHILPSBURG COAL & LAND CO.

THOMAS REESE (TRACT)
AXELINA (COAL)

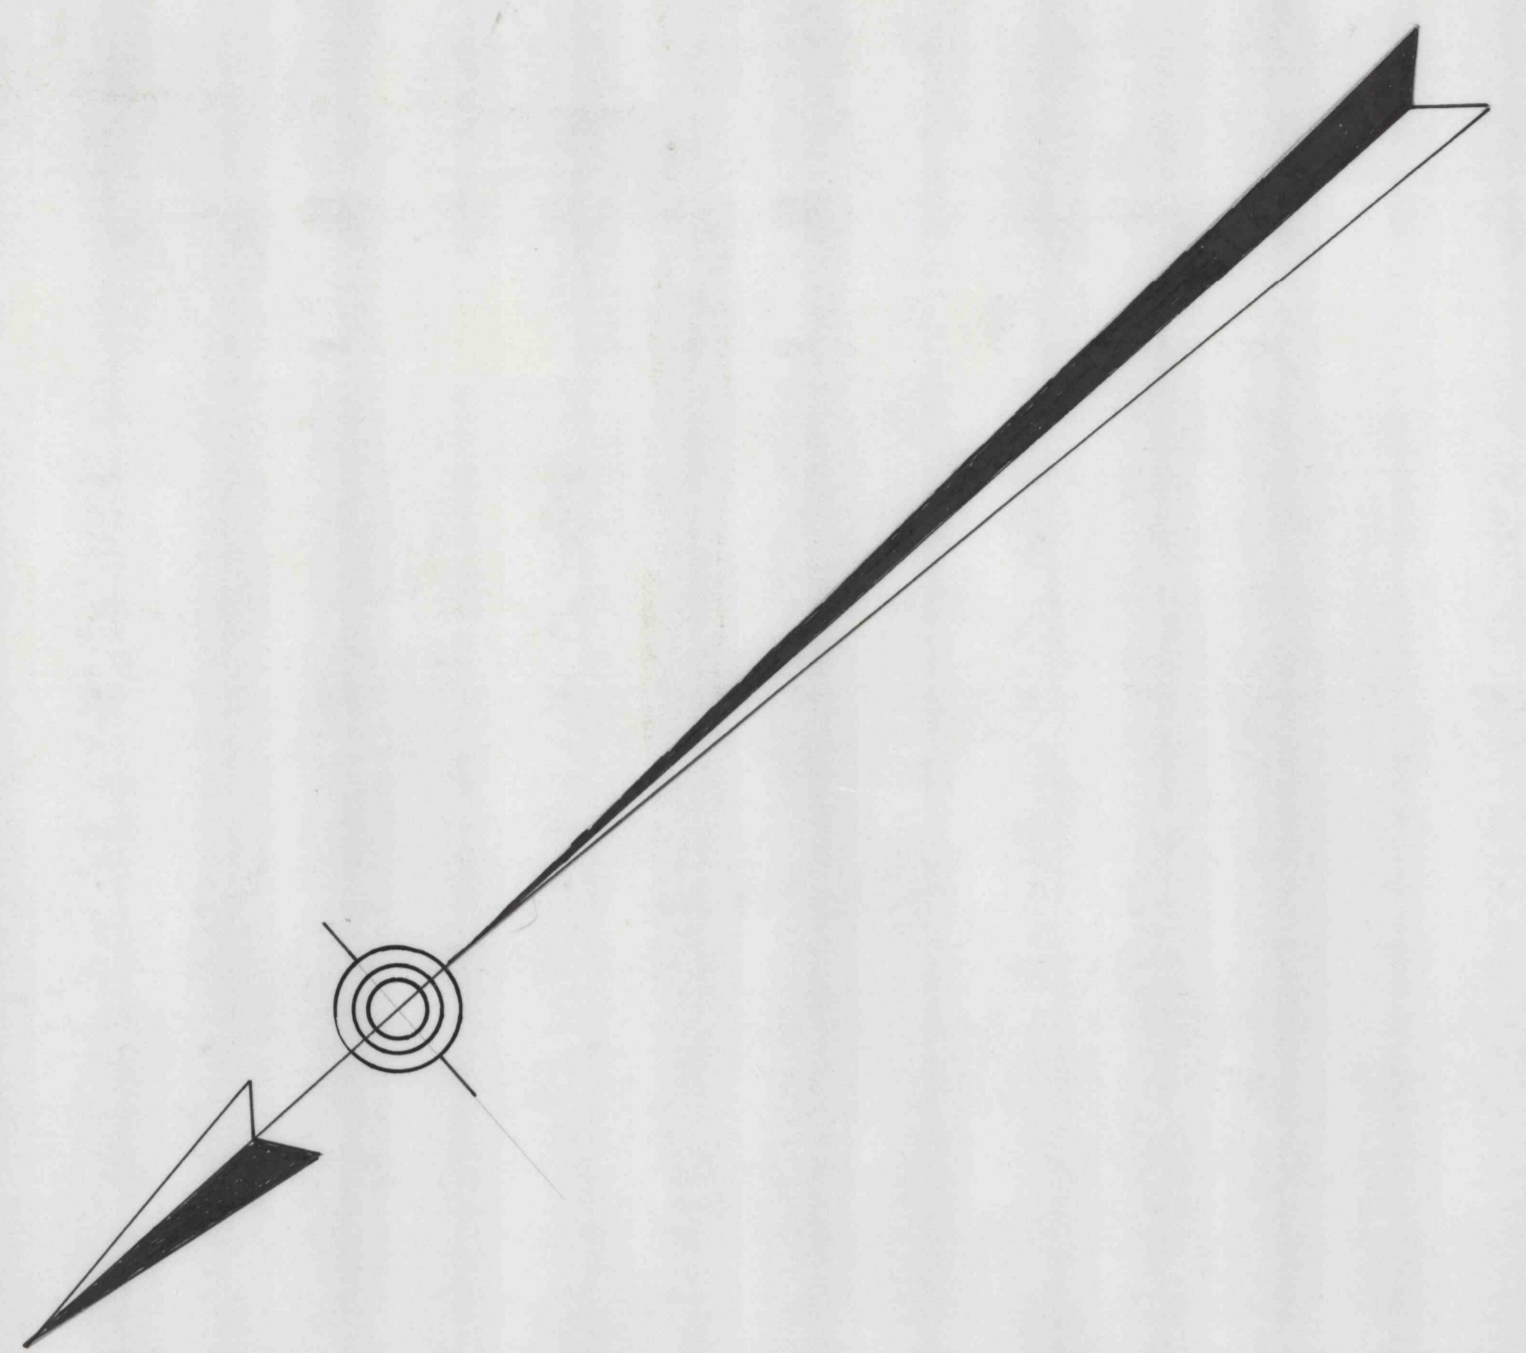

MINE MAP
AXELINA COAL CO.
MOSHANNON BR. TYRONE DIV. P. RR.
RUSH TWP. CENTRE CO.
Scale 1" = 100' Date 2-2-1918

OFFICE OF
H. F. VAN VALZAH
MINING ENGINEER
CLEARFIELD PA.

THIS MAP WAS TRACED FROM A ORIGINAL PRINT
BY ENGINEERING DEPARTMENT
HARMONY MINING COMPANY
DATE 3-28-1978