

Geo. R. Bigler.

Mary Woolheater. Tract.


N 1:30' E

John S. Gearheart. Tract.

Striped.

Blueball Fire Brick Co.

DS

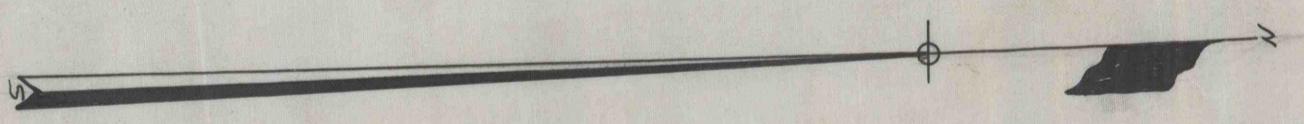

Survey for Geo Bigler.
 of
 Clay Mine, on John S. Gearheart Tract.
 Boggs Township; Clearfield County. Pa.
 Operated by The Blueball Fire Brick Co.
 Clearfield Pa. Scale 1" = 100'. E.W. Hess Engineer.
 Sept 12.03.

108

801

108

118

811

801

108

8908