


C.D.

D

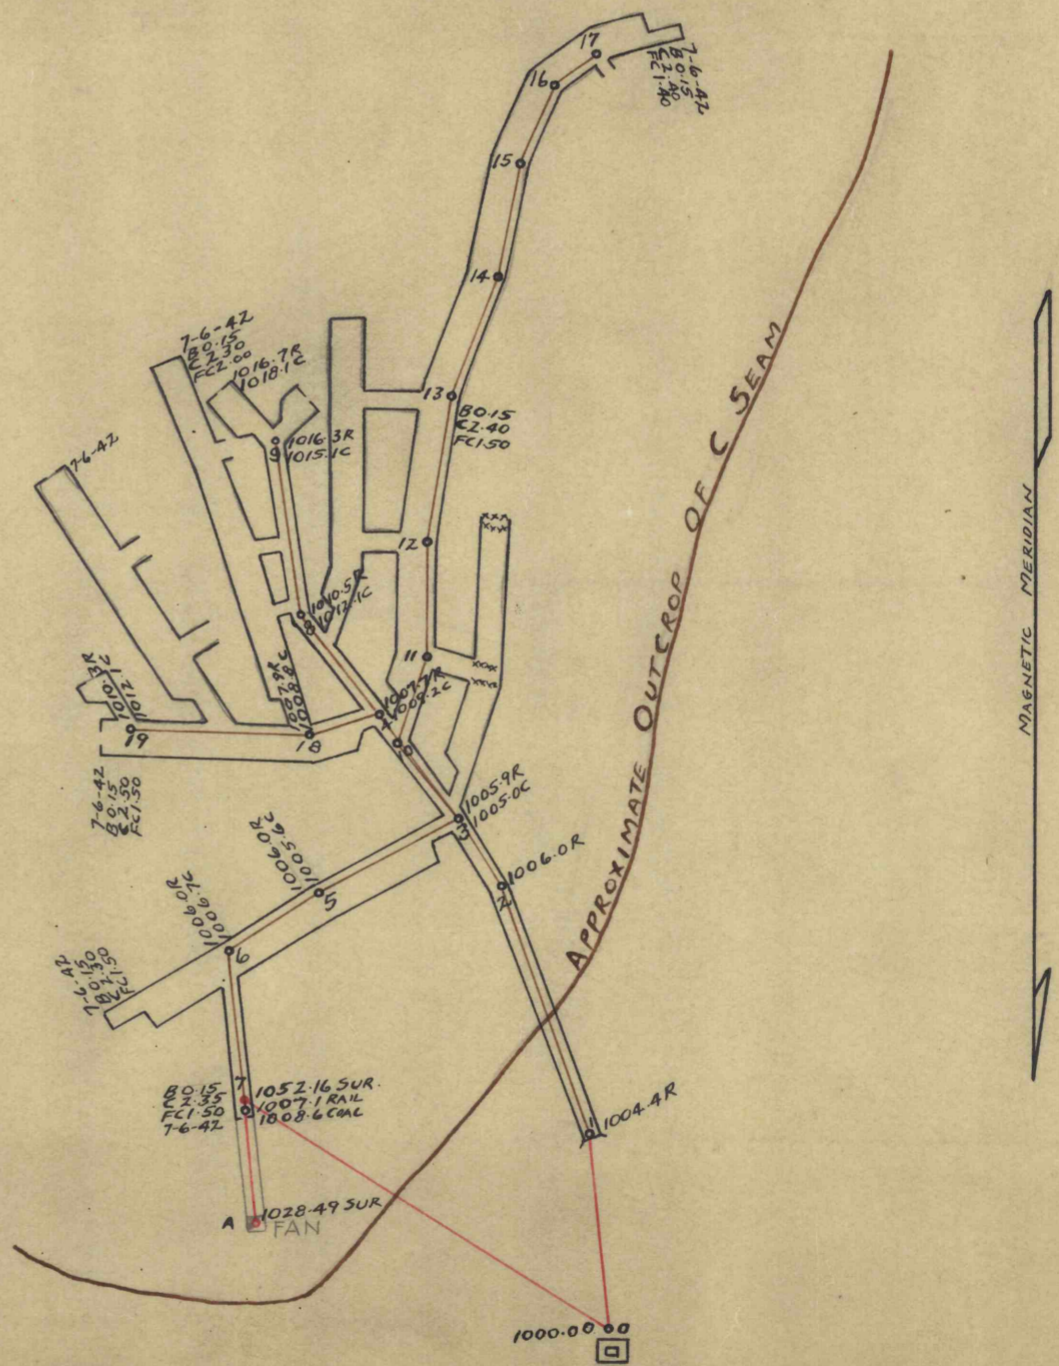

D

MAP SHOWING WORKINGS
 OF C SEAM
 AT
 BEAVER No 4 MINE
 OSCEOLA MILLS, PA
 SCALE 1"=100' JULY 6TH 1942

8394

C.D.

8244