

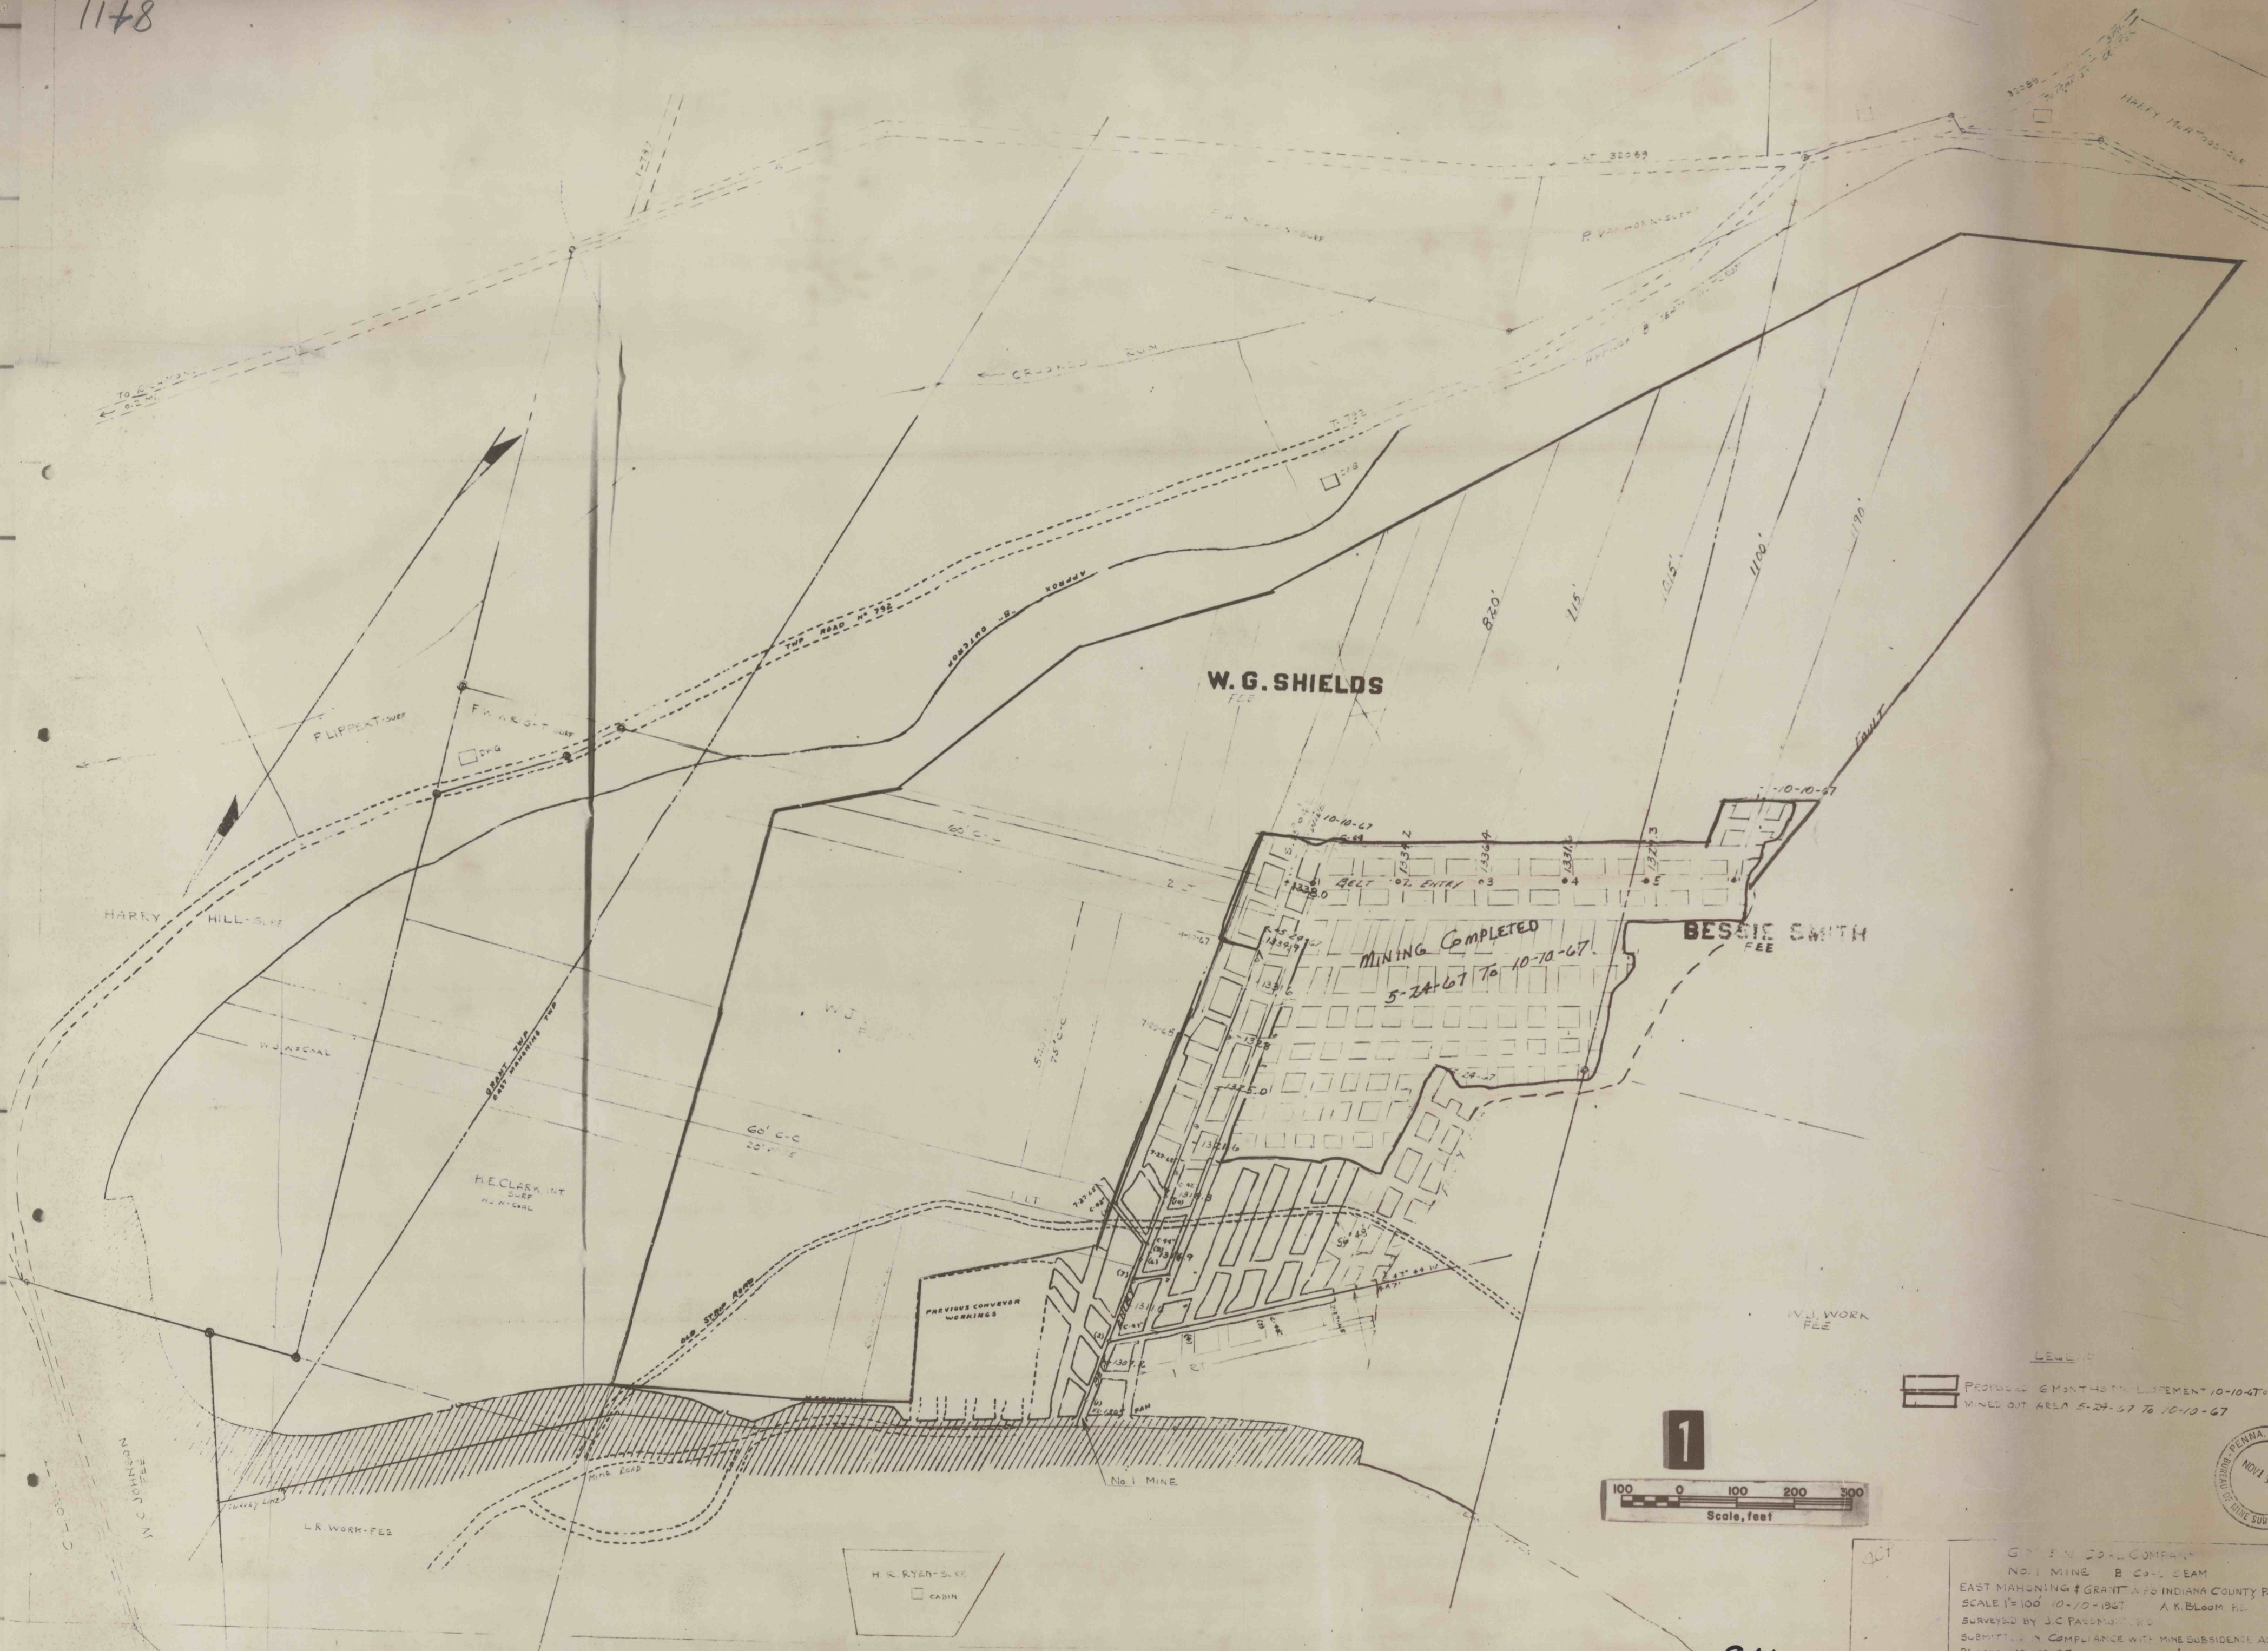


1178

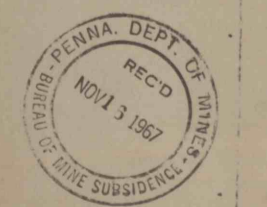

PROPOSED 6 MONTHS LIFETIME 10-10-67 to 4-10-68
   
 MINED OUT AREA 5-24-67 TO 10-10-67

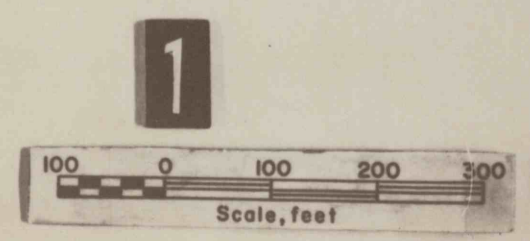

G. F. B. COAL COMPANY  
 NO. 1 MINE, B CO., SEAM  
 EAST MAHONING & GRANT APTS INDIANA COUNTY PA  
 SCALE 1"=100' 10-10-1967 A. K. BLOOM P.E.  
 SURVEYED BY J. C. PASQUINI, P.E.  
 SUBMITTED IN COMPLIANCE WITH MINE SUBSIDENCE ACT OF 30...  
 REVISED 10-10-67

8411

FIELD COPY

PVMS 03135 258 27X 351321