


W. A. BIRD
 Reservation Not
 TO BE MINED

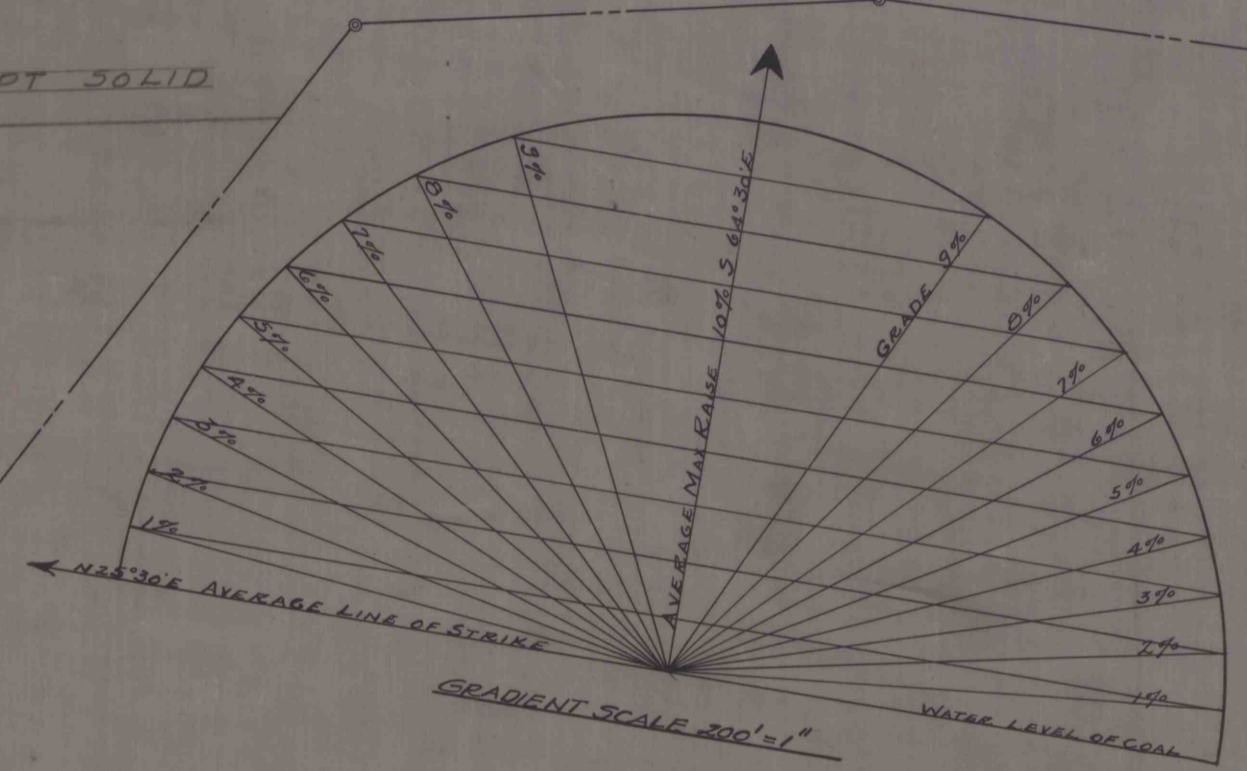

PLAN OF THE
 ANSPACH MINE No. 1.
 ADDISON TWP, SOMERSET CO, PENNA.
 ANSPACH STATION, WHITES CREEK BR, B&O R.R.
 DEC 17, 1923. SCALE-100'=1"

D
 8000

8452

8452