


Stone Post

Revised To July 28, 1900

JAMES GOSS TRACT

HILL DISPUTED GROUND 3 1/2 x 1/2 N


3453.0

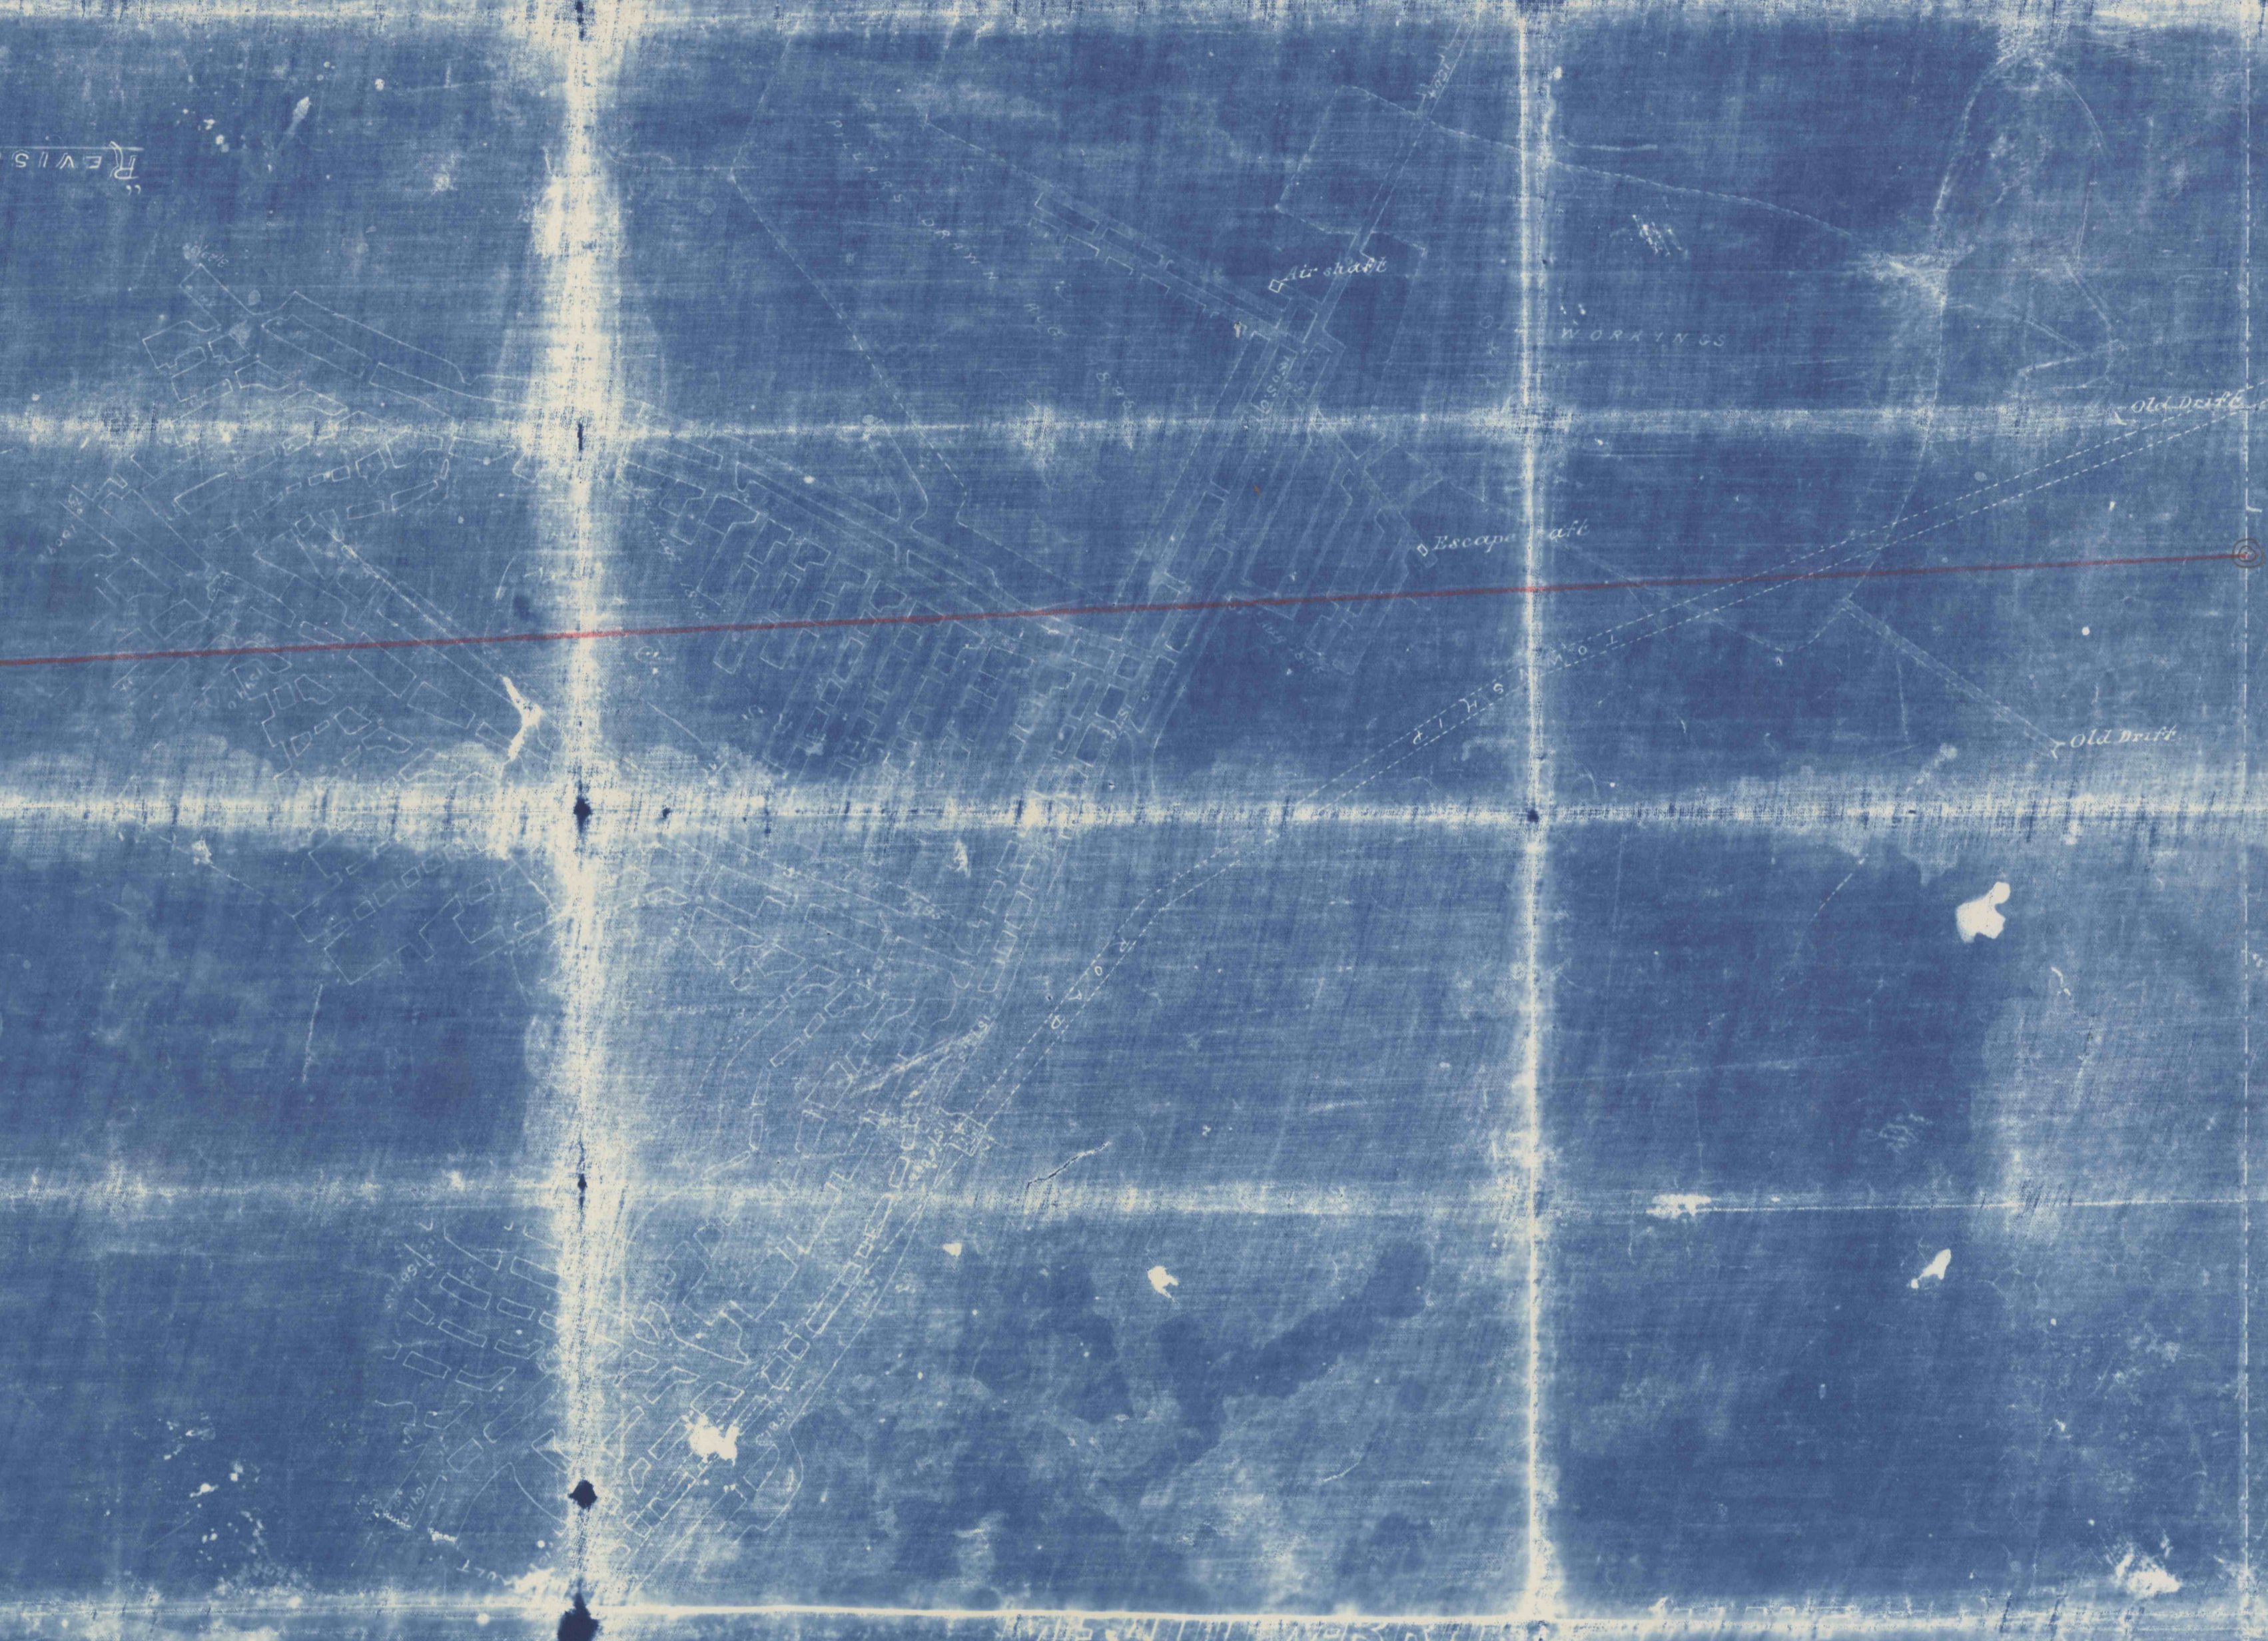

MEADOWBROOK HILL
COAL WORKINGS

Scale of Feet
 0 100 200 300 400 500 600 700 800

Situated in
 Township
 Clearfield County, Penna.
 Lessors J. D. Goss
 Lessees H.T. Coal Co.

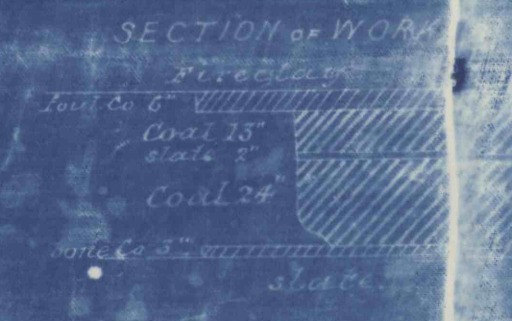

8469 PD

Published by
 J. D. Goss
 Clearfield, Penna.
 Revised July 1900

REVISED JULY 1900 P. W. MCGEE

CD