


W
H
I
T
E
D
O
U
G
A
N
C
O
A
L
C
O

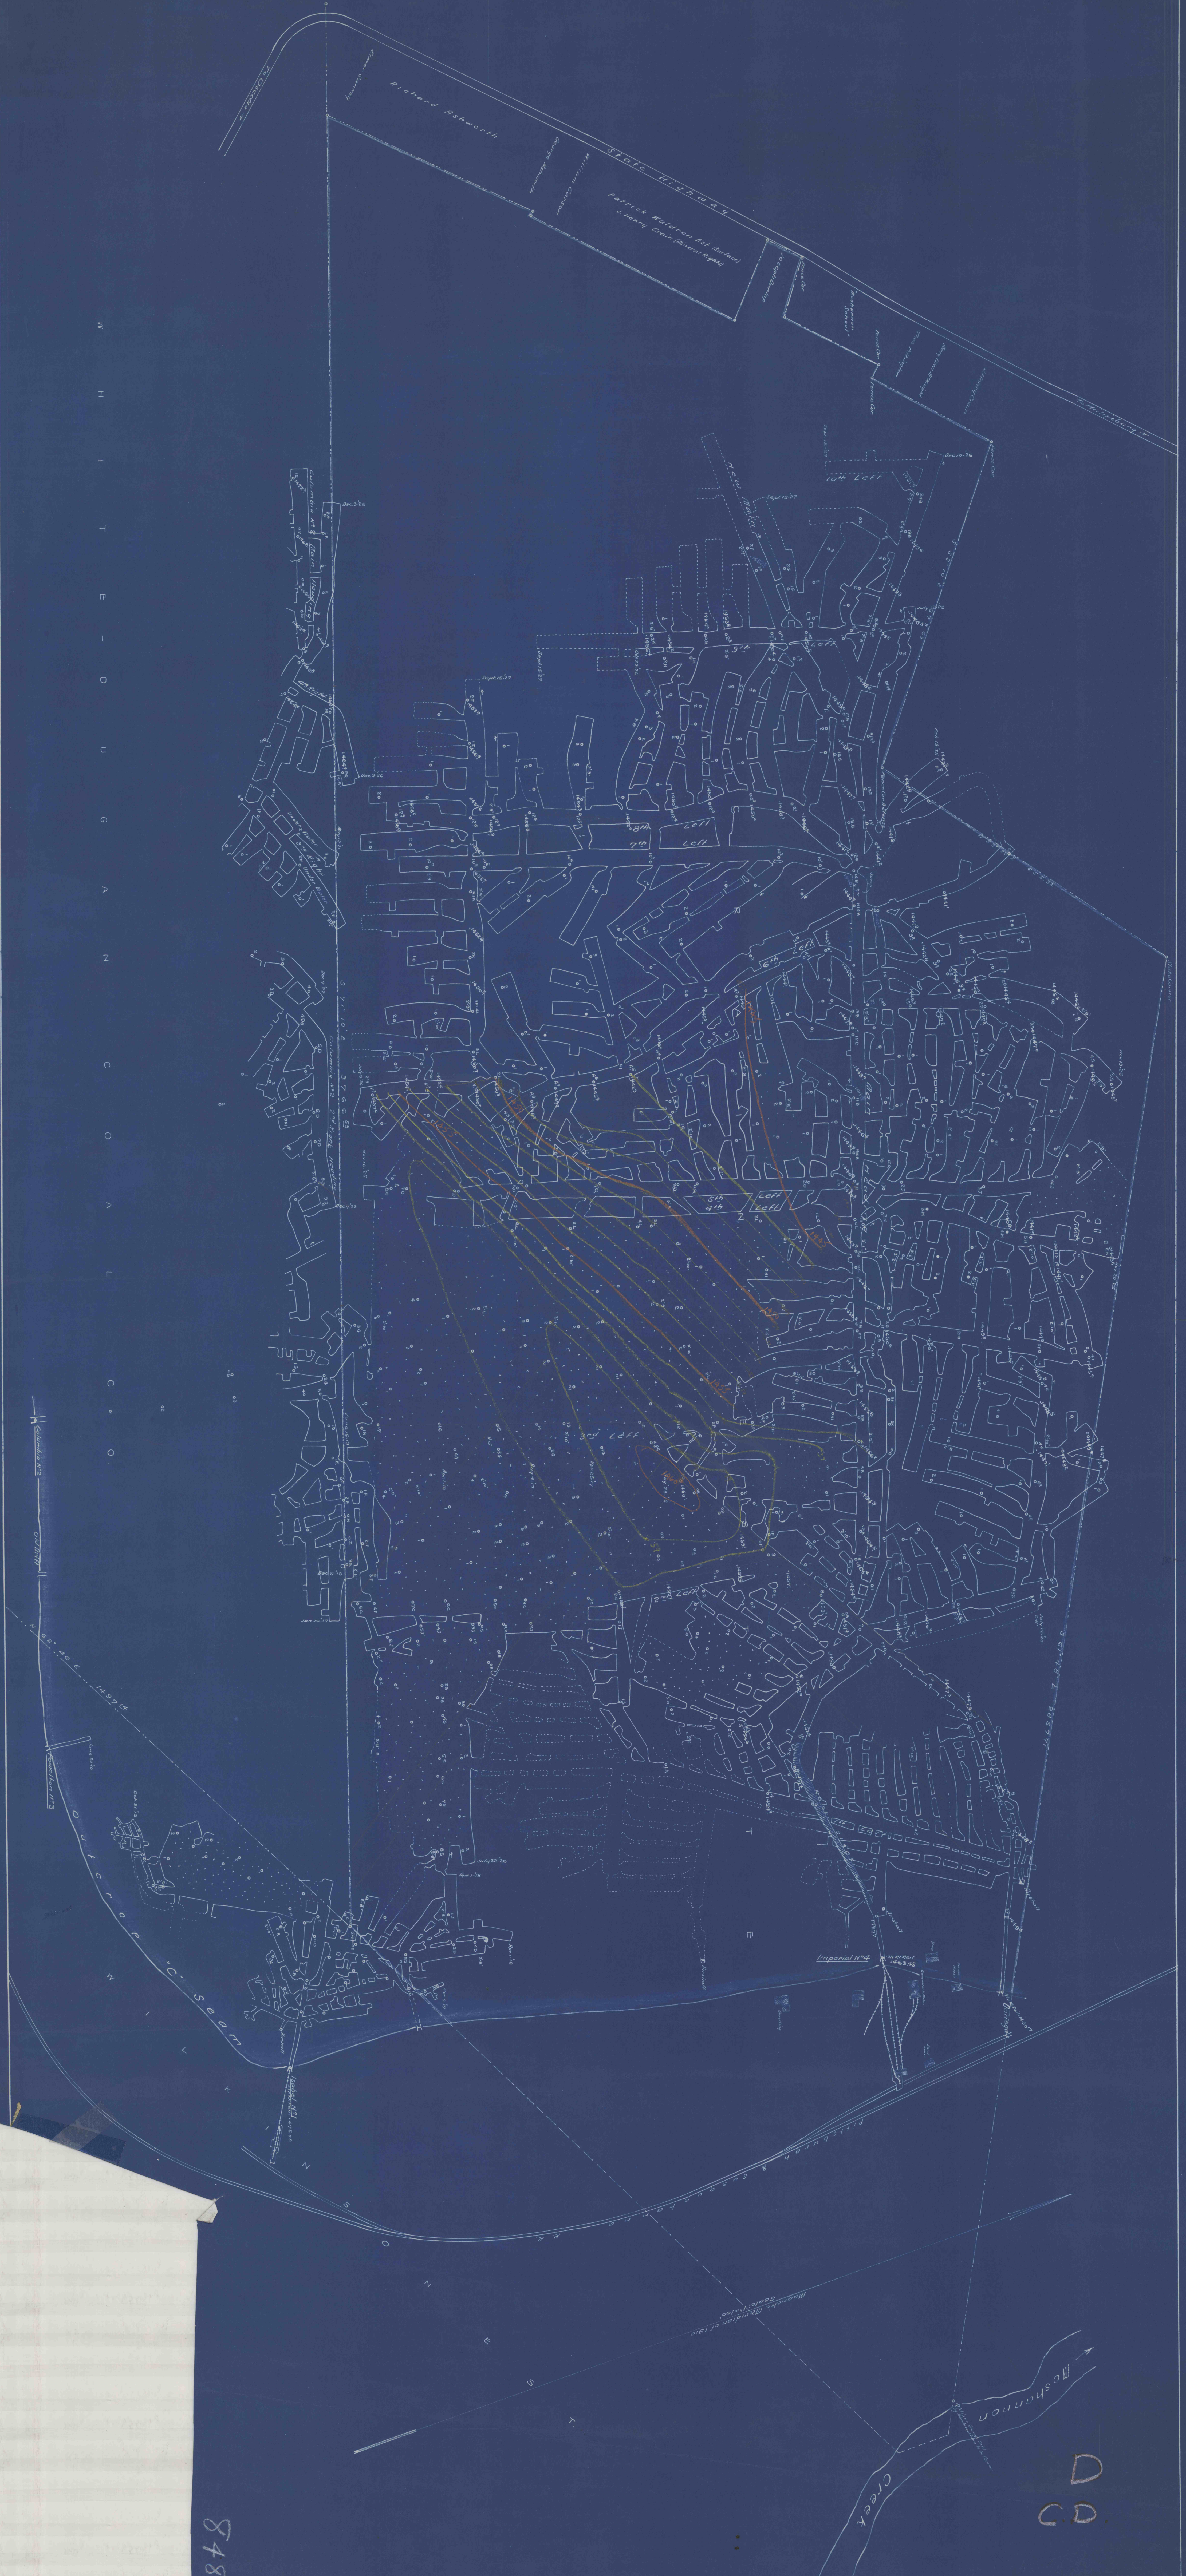

8488

CD
D