


8527

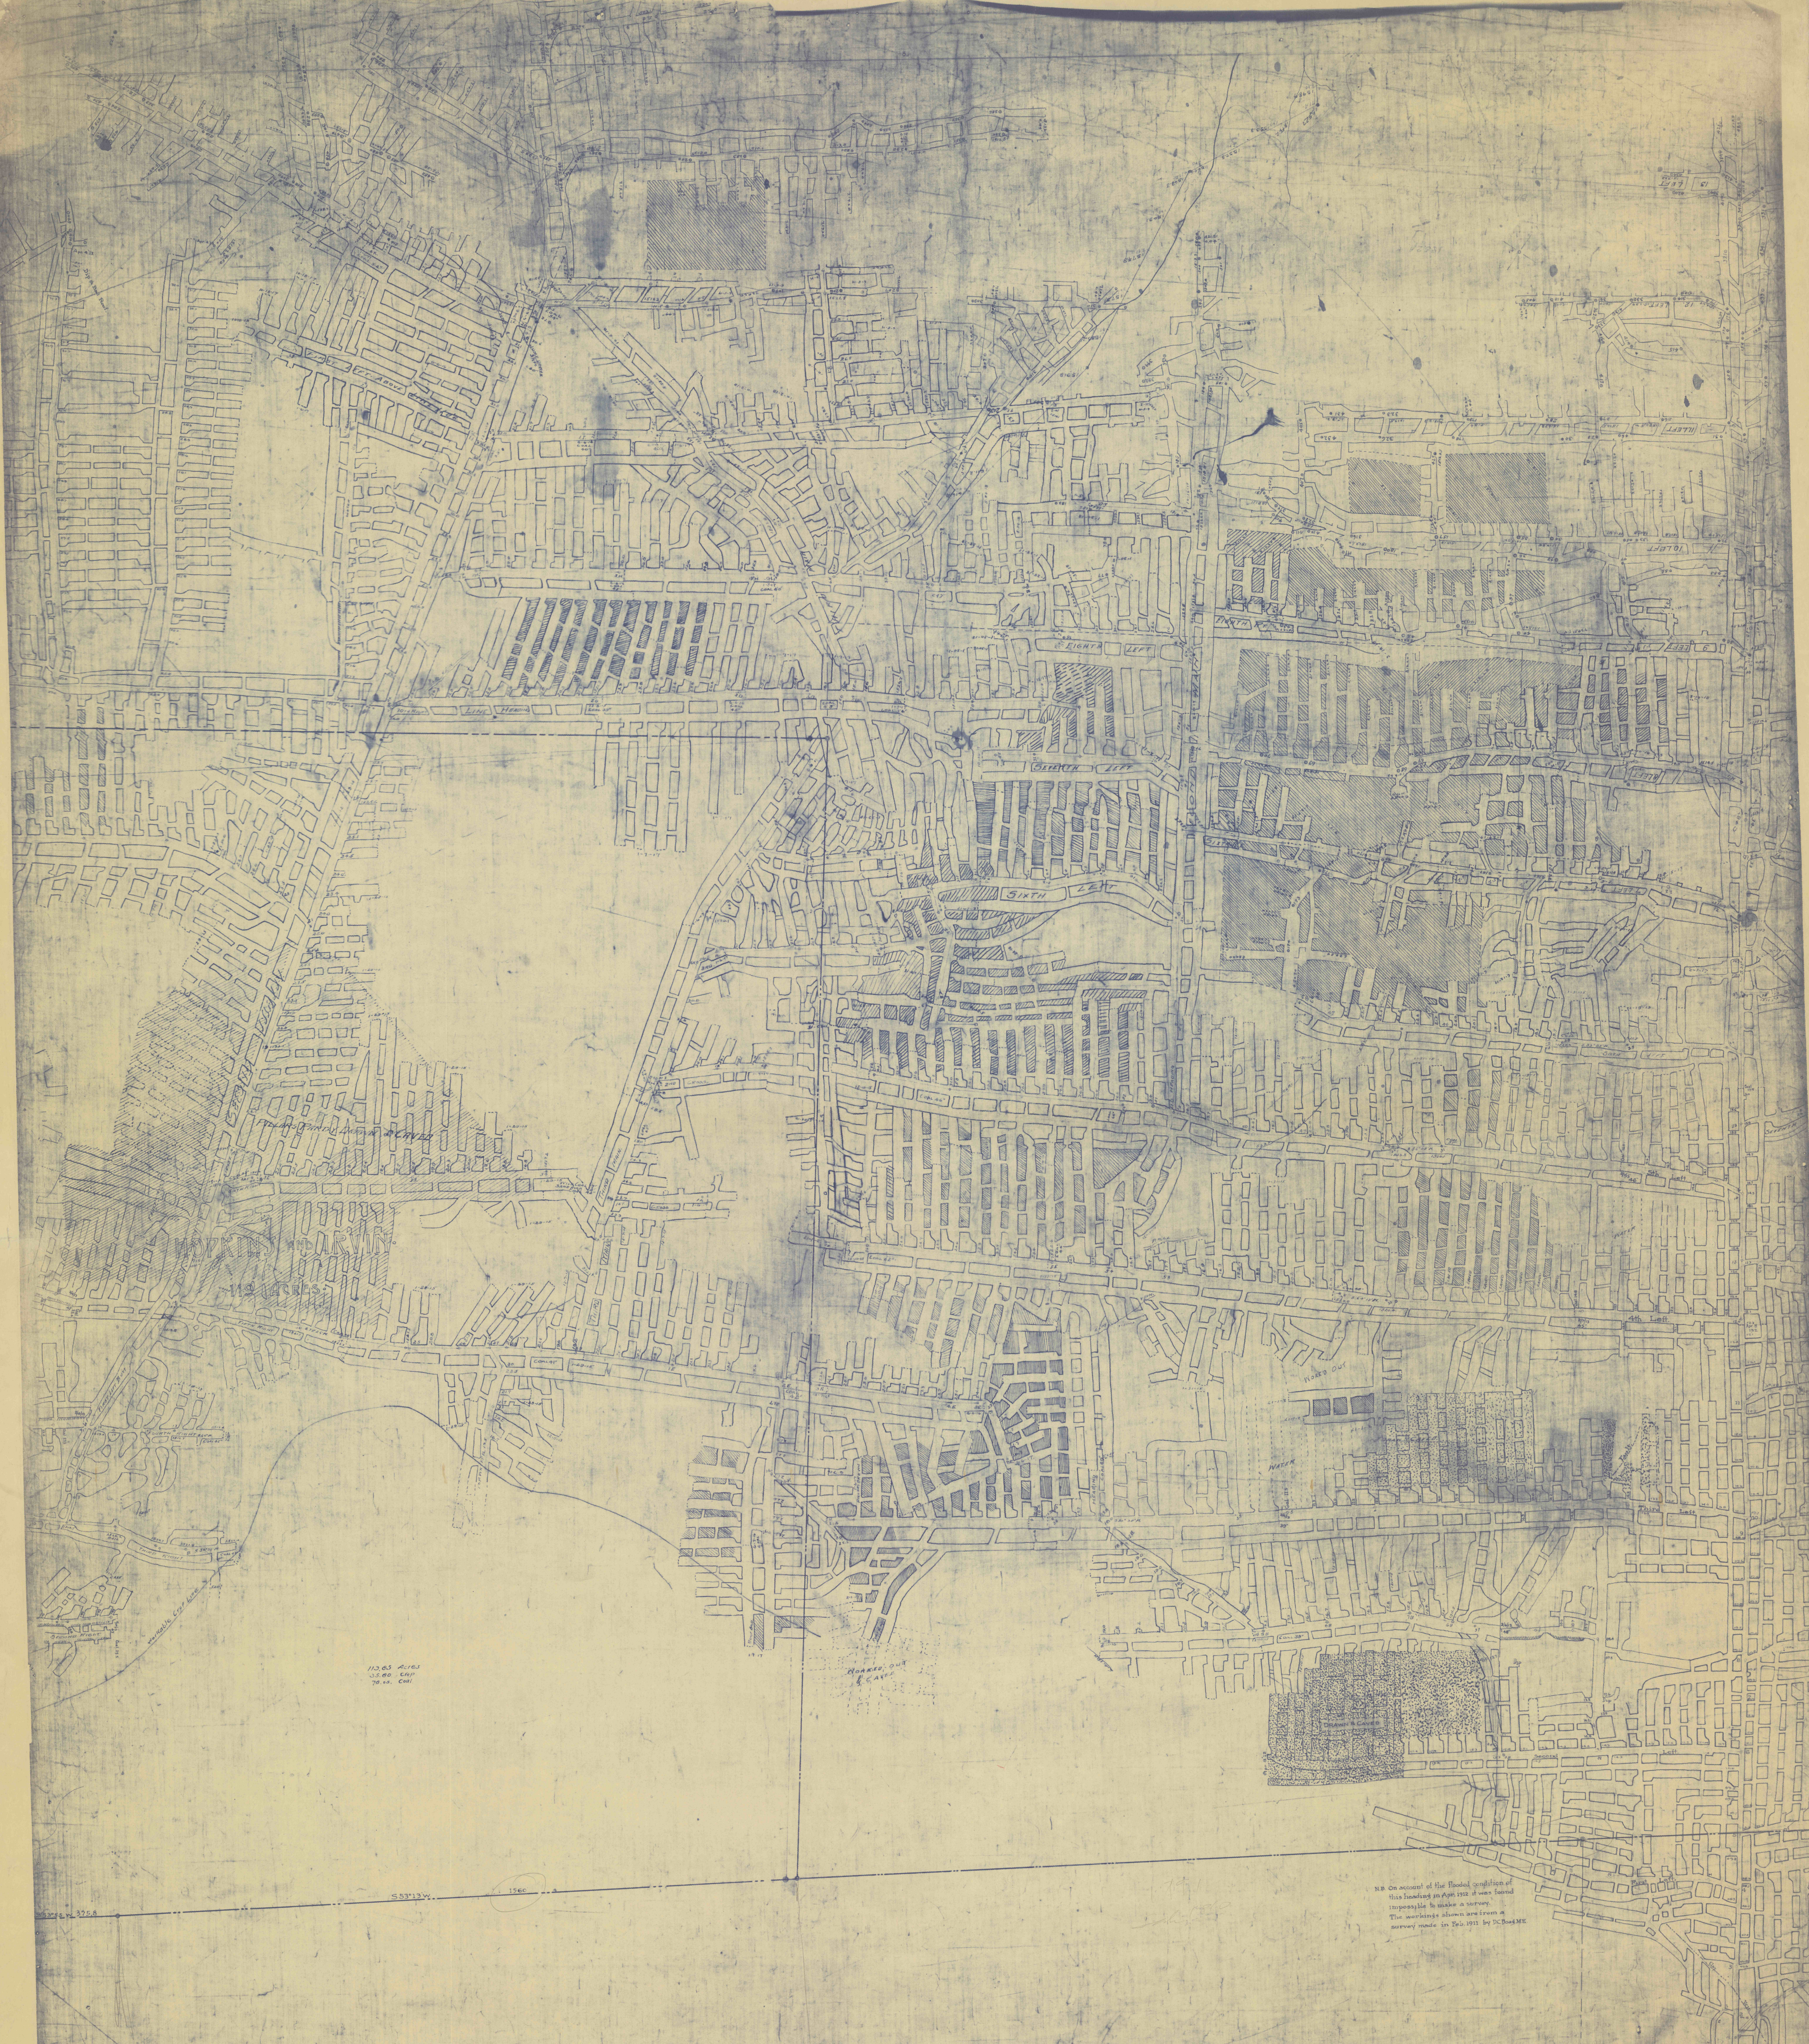

- POTTS RUN LAND CO. -
 FRED B. KERR GEN SUPT.
 JOHN BOAG SUPT.
MAP OF NO. 2 AND 3 MINES
 AT
 - BOARDMAN-CLEARFIELD CO. PA.
 SCALE 1:100
 CLEARFIELD, PA. OFFICE OF E.W. HESS
 ENGINEER

NO. 3

DATE OF SURVEYS

APRIL	24 1912	W. H. H.
MAY	2 1912	W. H. H.
DEC	19 1913	W. H. H.
JAN	29 31 1913	W. H. H.
DEC	9 10 1915	W. H. H.
JUNE	11-12 1916	W. H. H.
FEB	1-2 1917	W. H. H.
OCT	16 18 1918	W. H. H.
JAN	30 31 1918	W. H. H.
MAY	23 24 25 1918	W. H. H.
SEPT	19 20 21 1918	W. H. H.
JULY	20-21 1918	W. H. H.


8527
8526
8527