


34
32
30
28
26
24
22
20
18
16
14
12
10
8
8
10
12
14
16
18
20
22
24
26
28
30
32
34



PVMS 03135 225 36X 351309

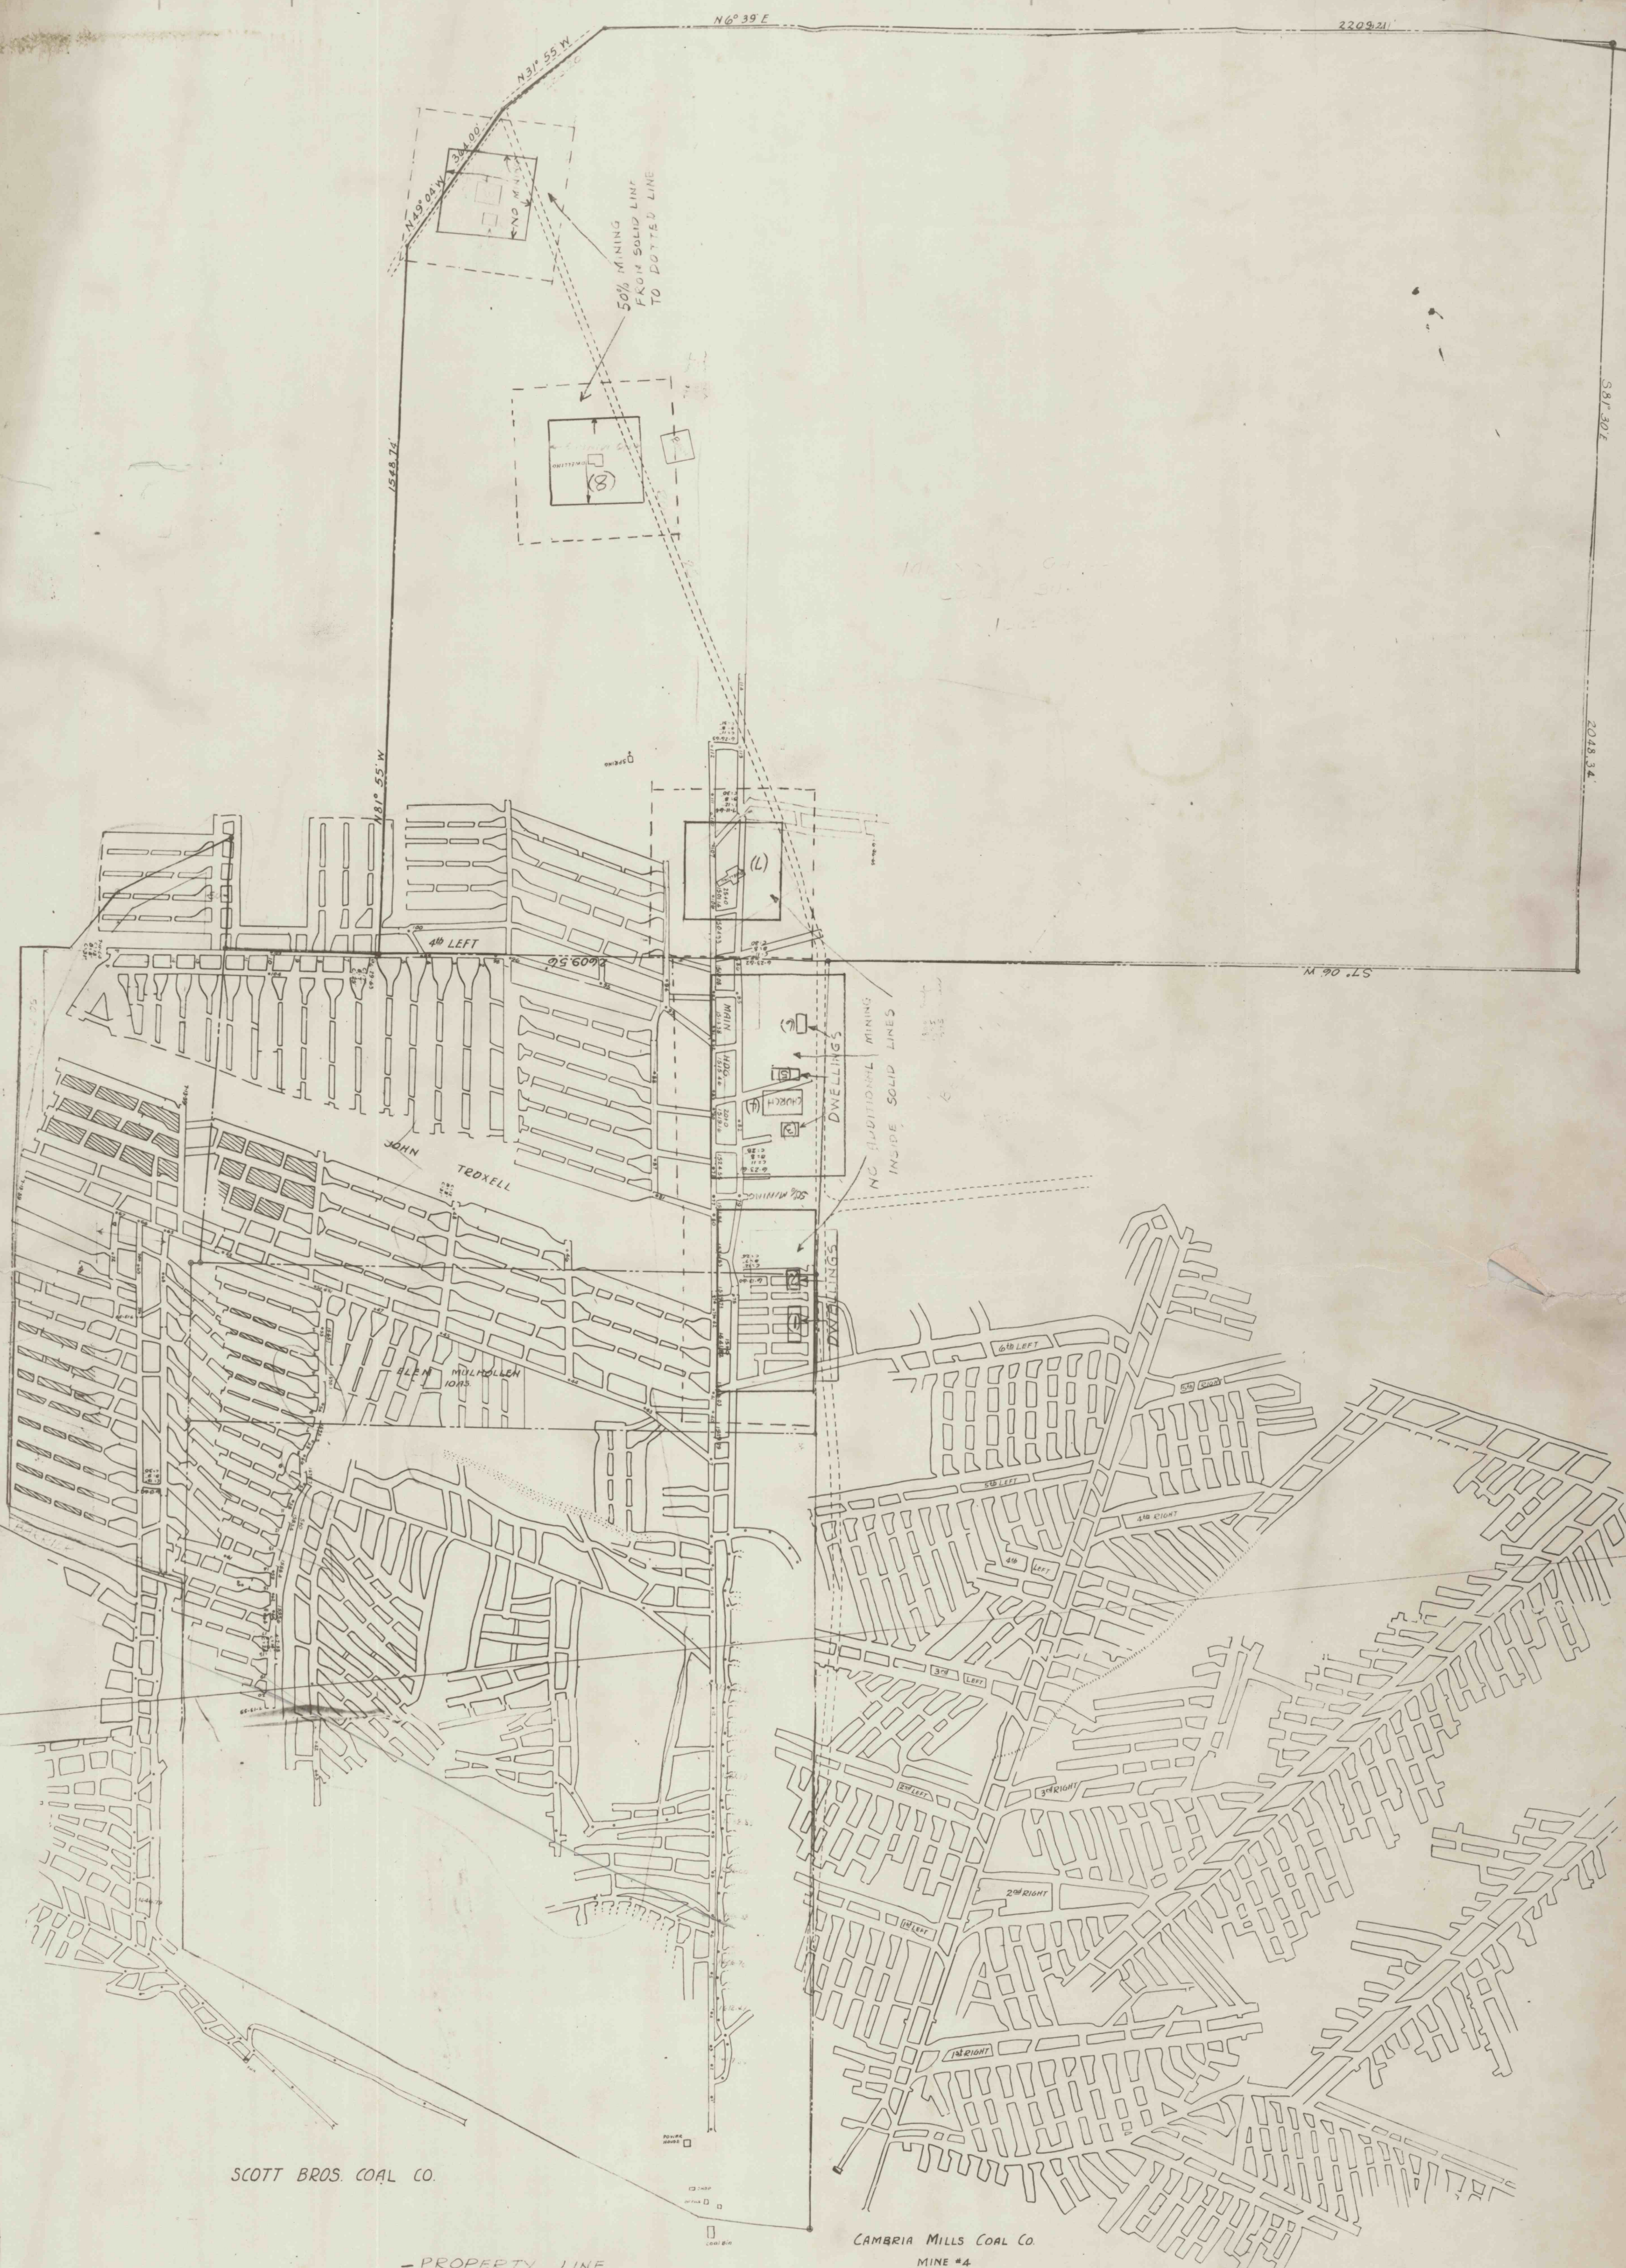

SCOTT BROS. COAL CO.

CAMBRIA MILLS COAL CO.
MINE #4

- PROPERTY LINE
- WORKED OUT
- PROPOSED WORKINGS TO FEBRUARY
- STRUCTURES AND SUPPORT AREAS

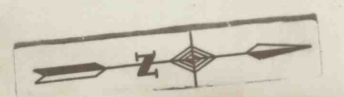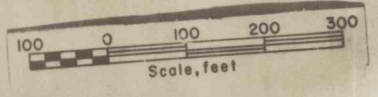

MAP
SHOWING
"B" SEAM WORKINGS
W. H. MILLER COAL CO.
READE TWP., CAMBRIA CO., PENNA.
SCALE - 1" = 100' J. L. BANFIELD, P.E. ENG.

8548