



34
32
30
28
26
24
22
20
18
16
14
12
10
8
8
10
12
14
16
18
20
22
24
26
28
30
32
34

PDVMS 03046257 36X 316589



SCOTT BROS. COAL CO.

CAMBRIA MILLS COAL CO
MINE #4

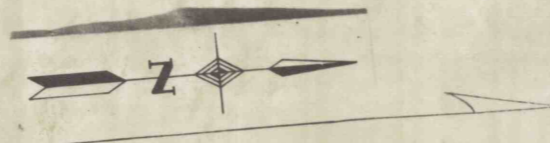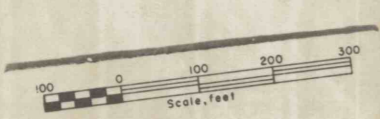

PROPERTY LINE
 CONTEMPLATED MINING
 SUPPORT AREA
 PROTECTED STRUCTURES
 MINING COMPLETED AREA

MAP
 SHOWING
 "B" SEAM WORKINGS
 W. H. MILLER COAL CO.
 READE TWP., CAMBRIA CO., PENNA.
 SCALE - 1" = 100' J. L. BANFIELD REG. ENG.

BRANDON MINE MAP
 W. H. MILLER COAL COMPANY
 READE TWP., CAMBRIA CO.
 SCALE - 1" = 100'
 DATE MINE RECONSTRUCTED - 3/31/27
 JOHN C. PENNANCE
 #8121-E
 Certificate is here by made that
 this map is a true & correct copy
 of the original mine map of the mine
 and table list of my knowledge, the
 original map is true, complete, and correct.

8549