

LEONARD KALINSKI SURFACE  
ANDREW MARGO

JOHN CHELEDNIK SURFACE

WILLIAM ARFORD SURFACE

SHIRLEY RAE SURFACE

MICHAEL GOLDEN SURFACE

JOSEPH SPYDNIK

NO. 3 CORE DRILL HOLE  
FRED KRINJEK SURFACE

MICHAEL GOLDEN SURFACE

CAMBRIA MINING & MFG. CO. FEE

NO. 1 CORE DRILL HOLE  
CORE DRILL HOLE

CAMBRIA MINING & MFG. CO. FEE

THE MINE ELEVATIONS WAS ESTABLISHED FROM U.S.S. BENCH MARK IN MARTINDALE

### HARMONY MINING COMPANY


MINE NO. 1

LOWER FREEPORT COAL SEAM

PORTAGE & SUMMERHILL TWP. CAMBRIA COUNTY PENN.

SCALE 1" = 100'

DATE

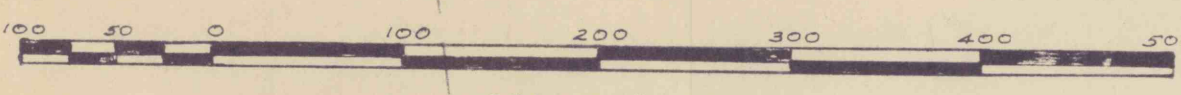

MINE I.D. NO. 36 02655