


8630

8629

800 D

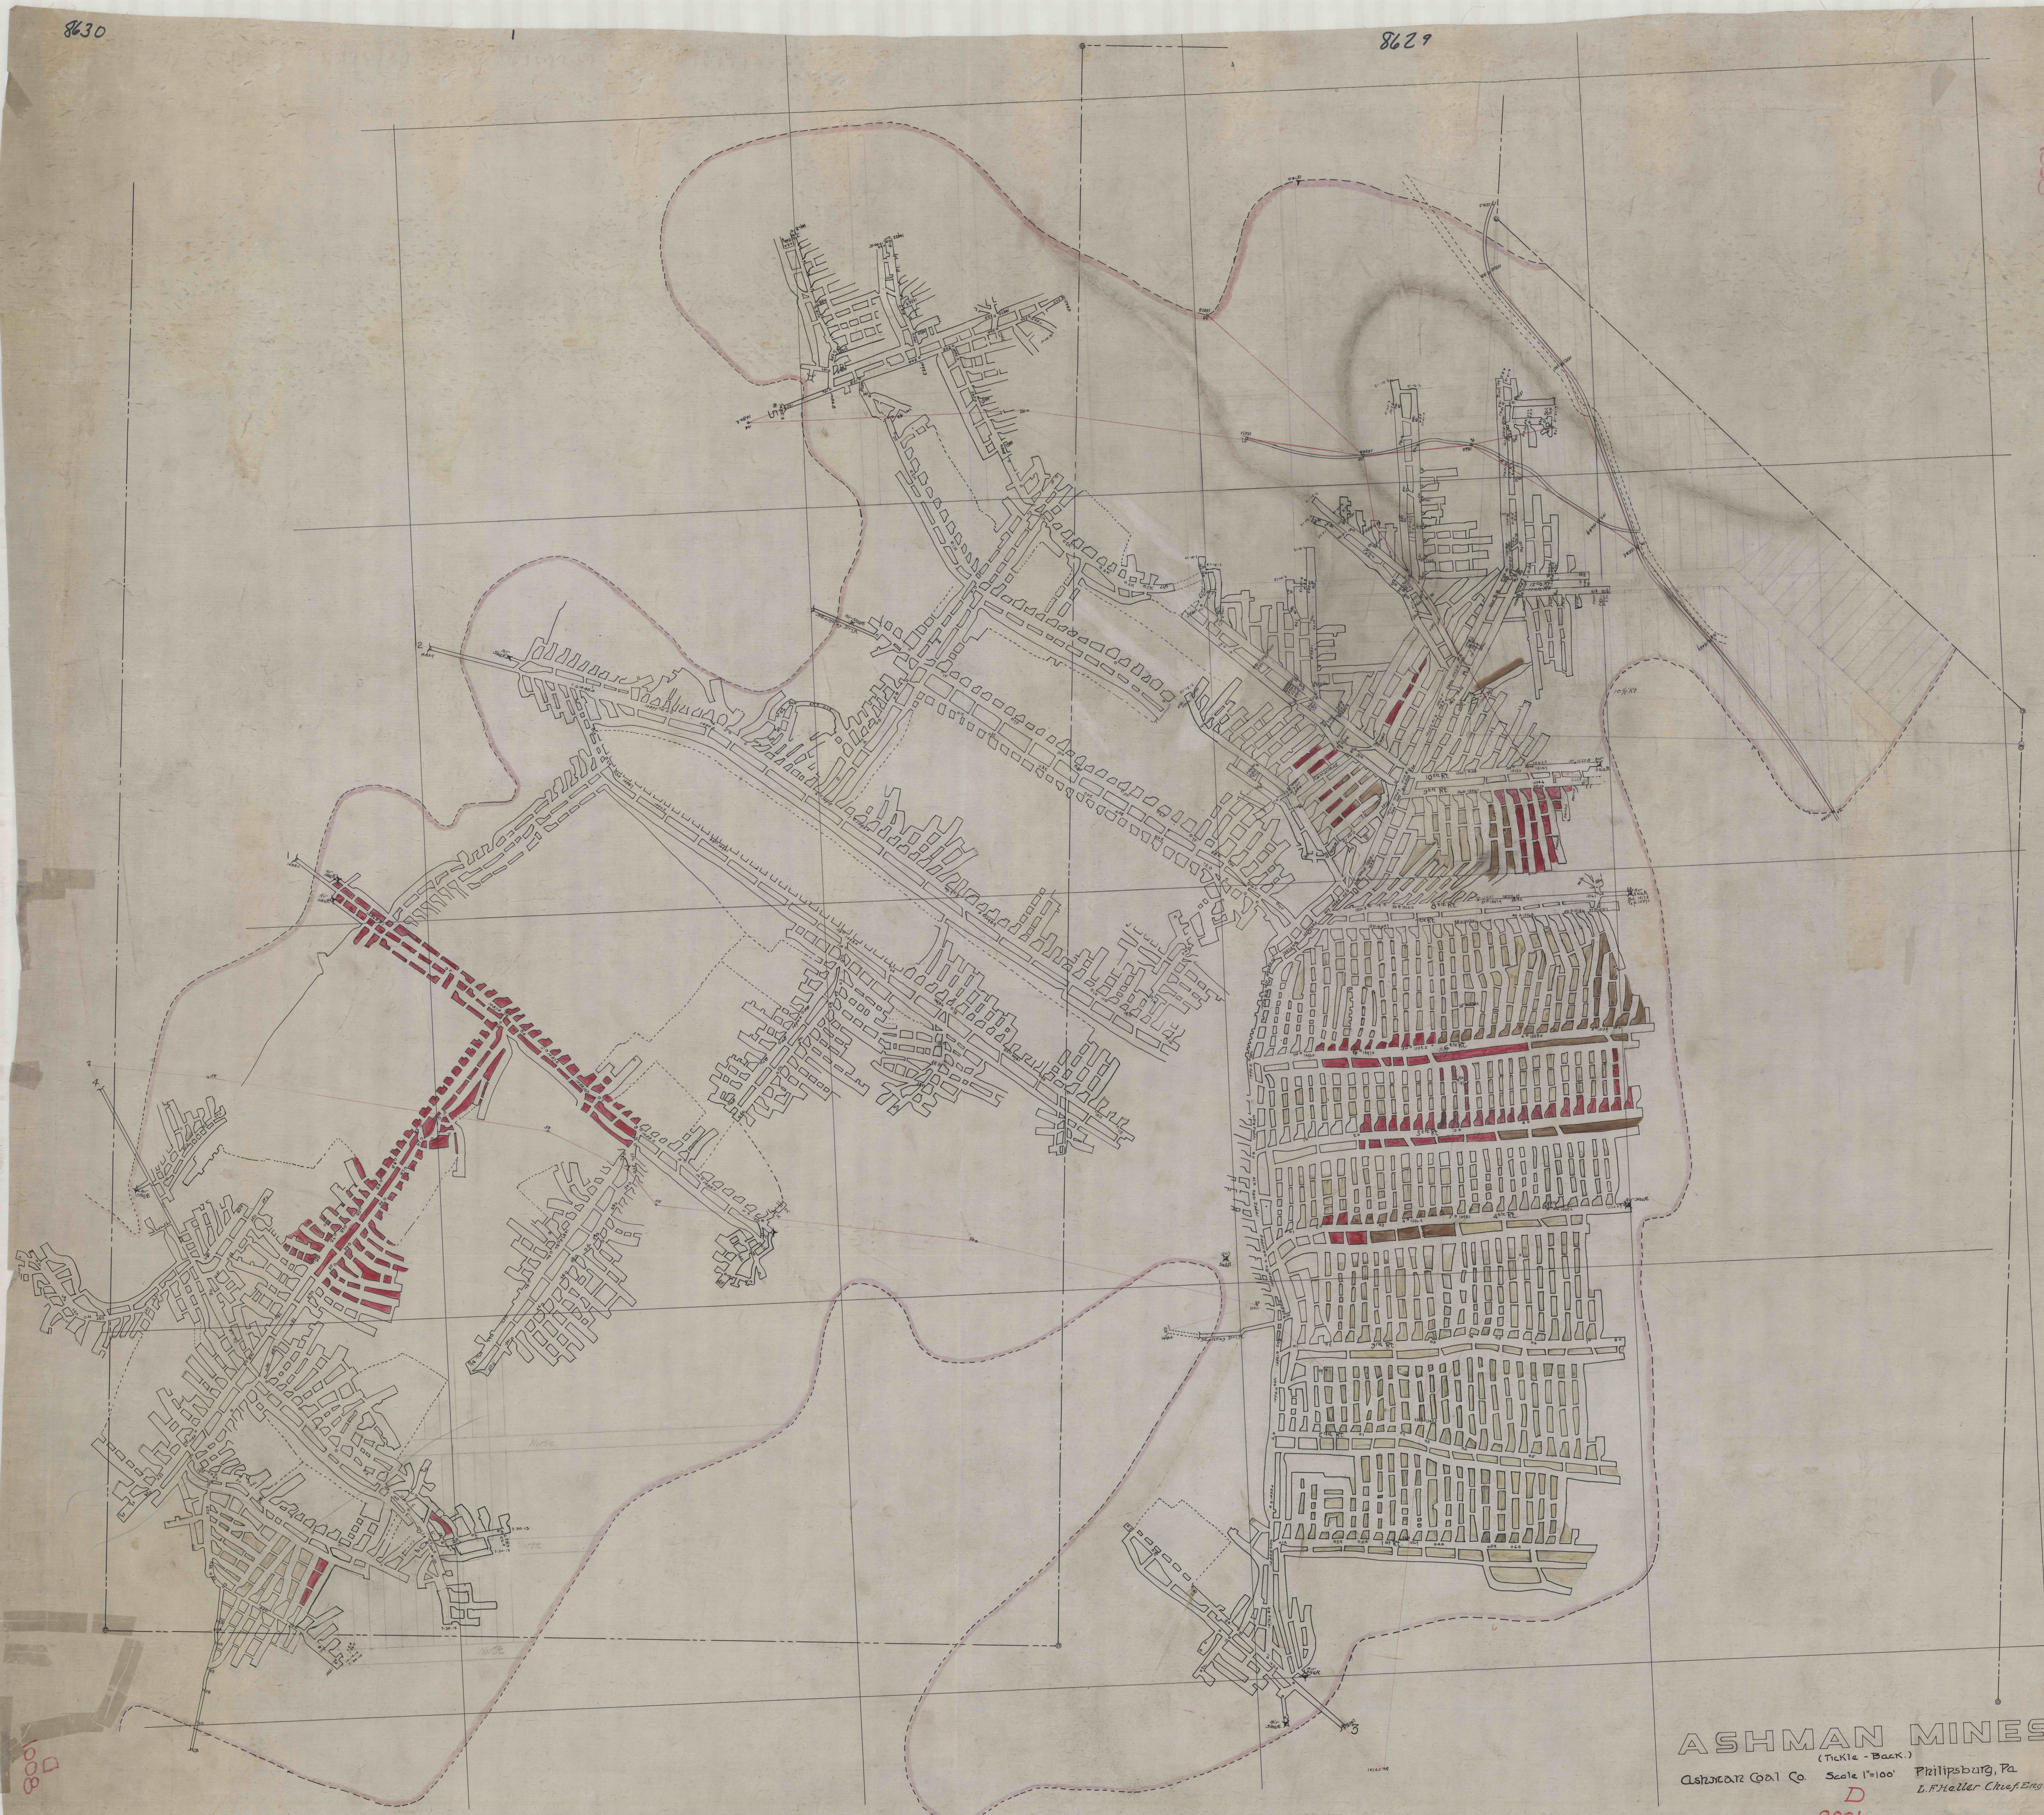

**ASHMAN MINES.**  
 (TICKLE - BACK.)

Ashman Coal Co. Scale 1"=100' Phillipsburg, Pa.  
 L. F. Heller Chief Eng.

D  
 8001

8629

800 D