


868
This is a duplicate of
Bears deep mine maps
map nos 501, 501

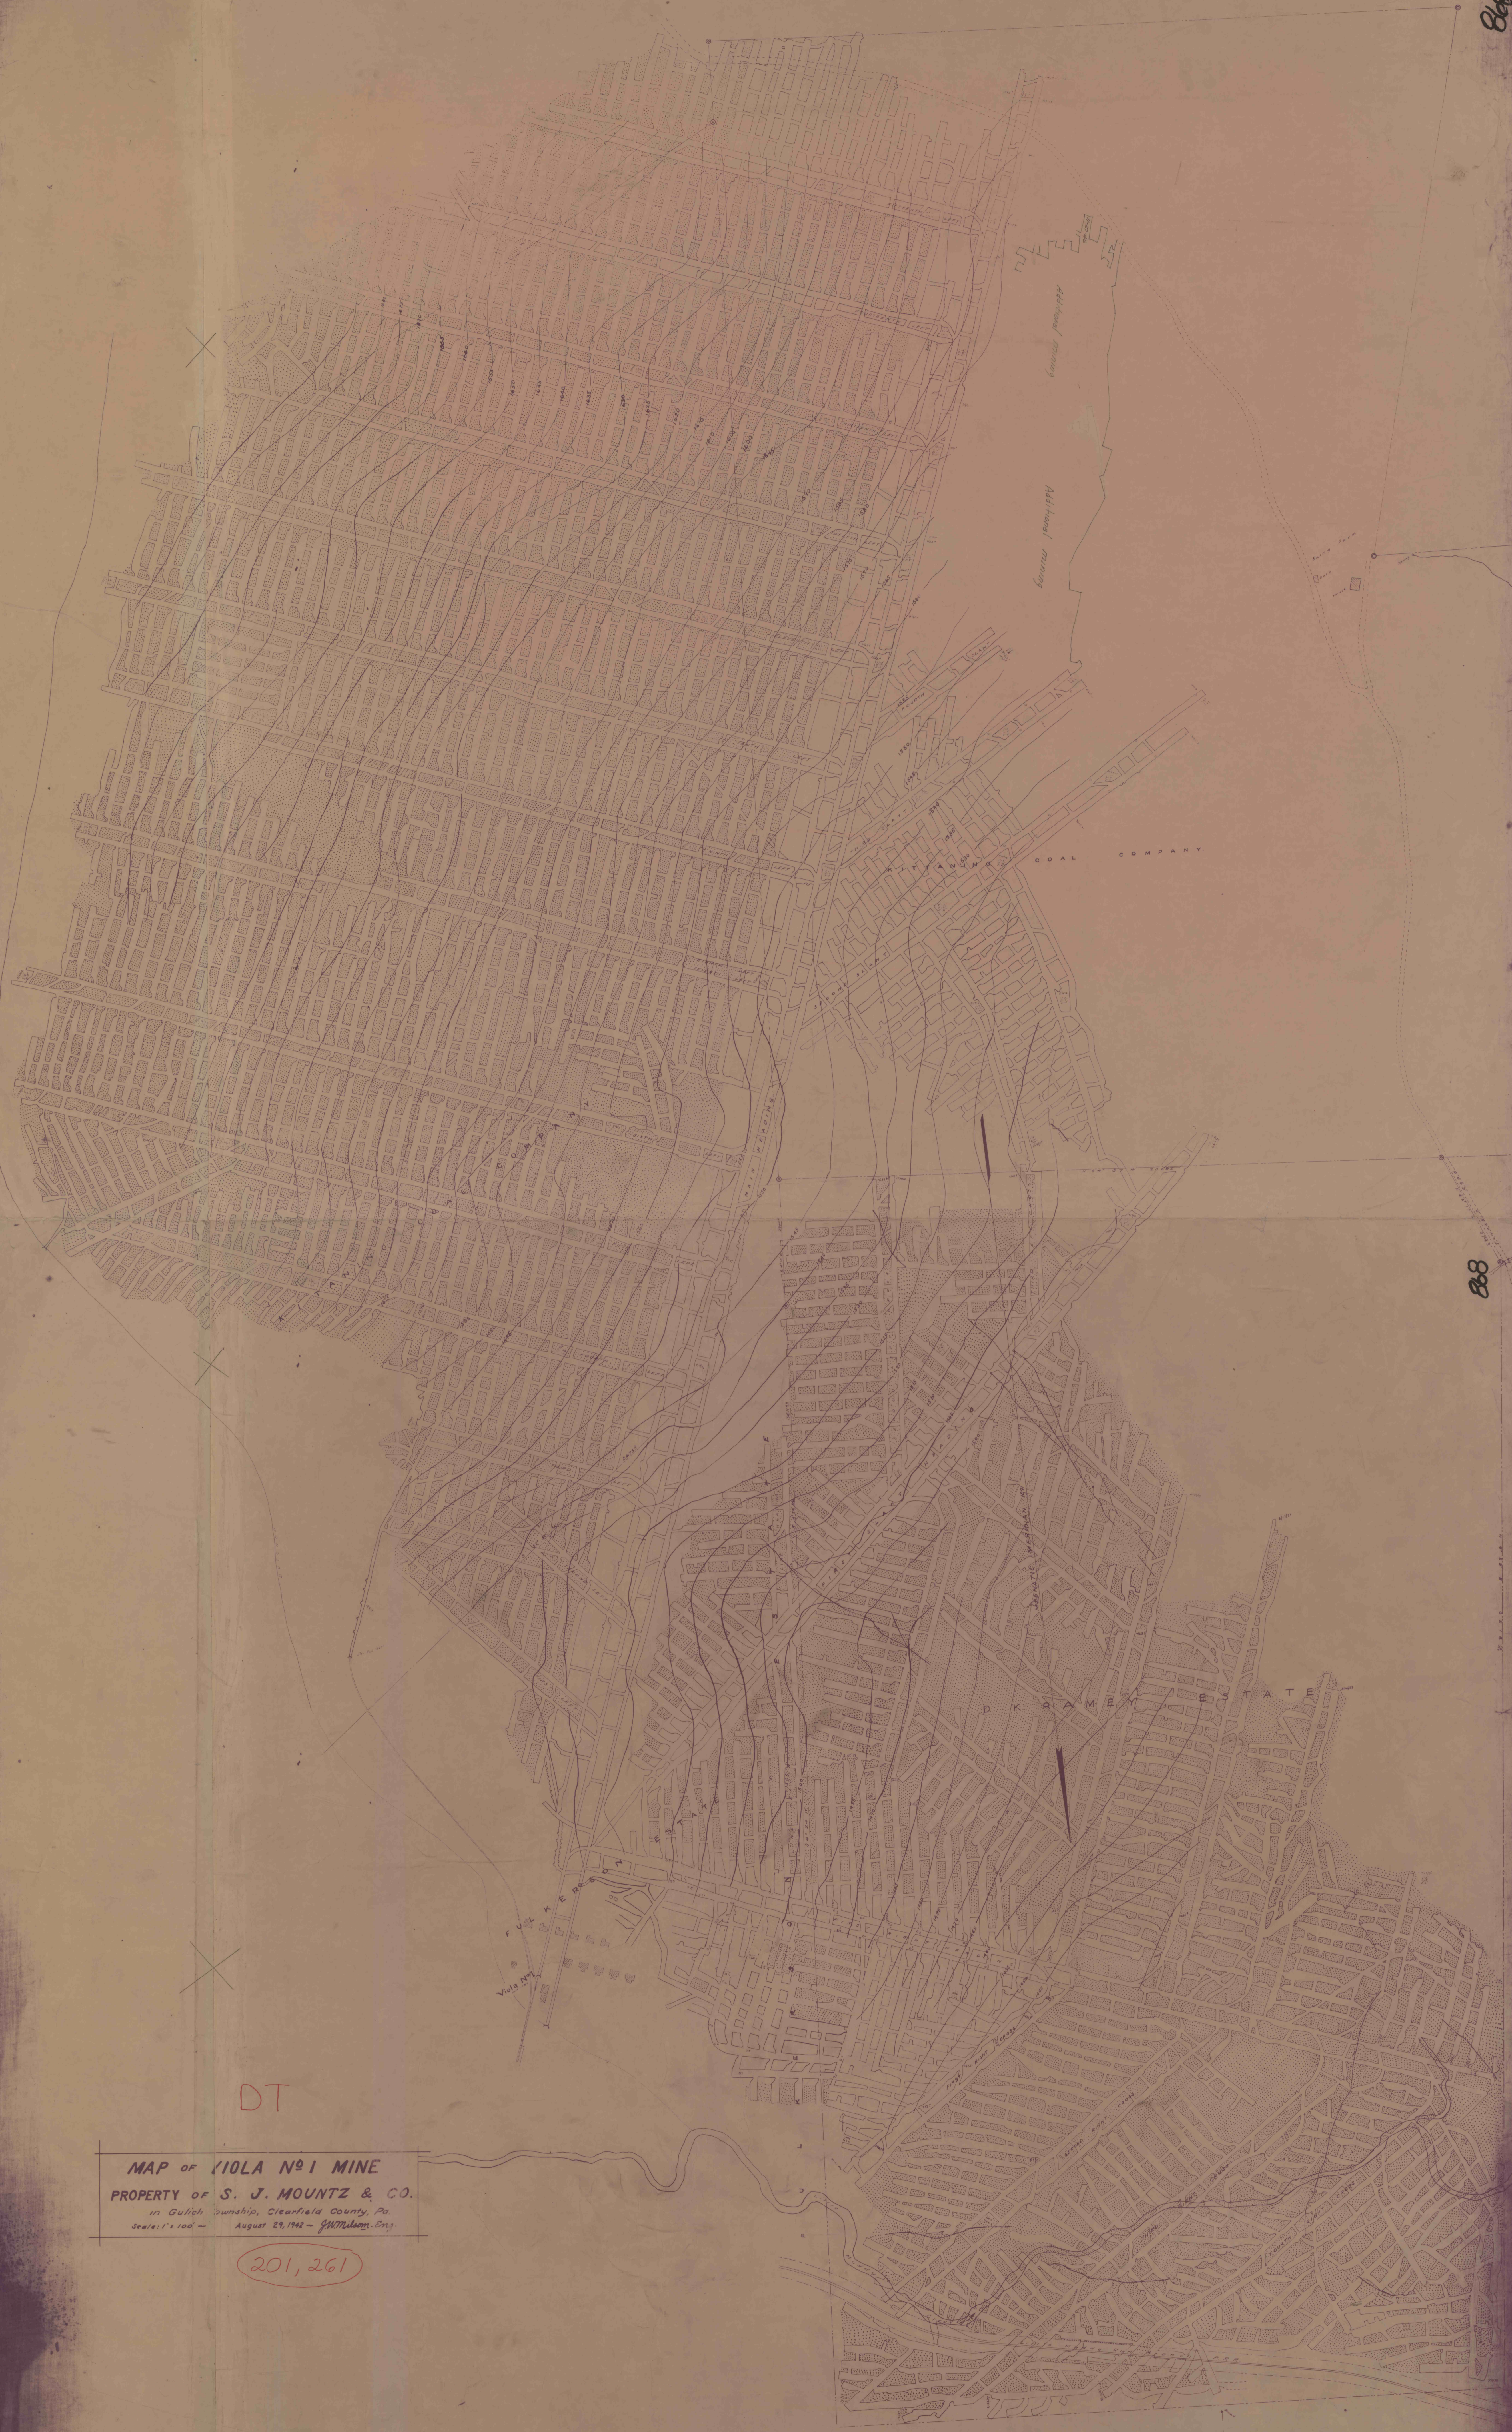

DT

MAP OF VIOLA No 1 MINE
PROPERTY OF S. J. MOUNTZ & CO.
in Gulich Township, Clearfield County, Pa.
Scale: 1" = 100' - August 29, 1942 - G. M. Wilson, Eng.

201, 261