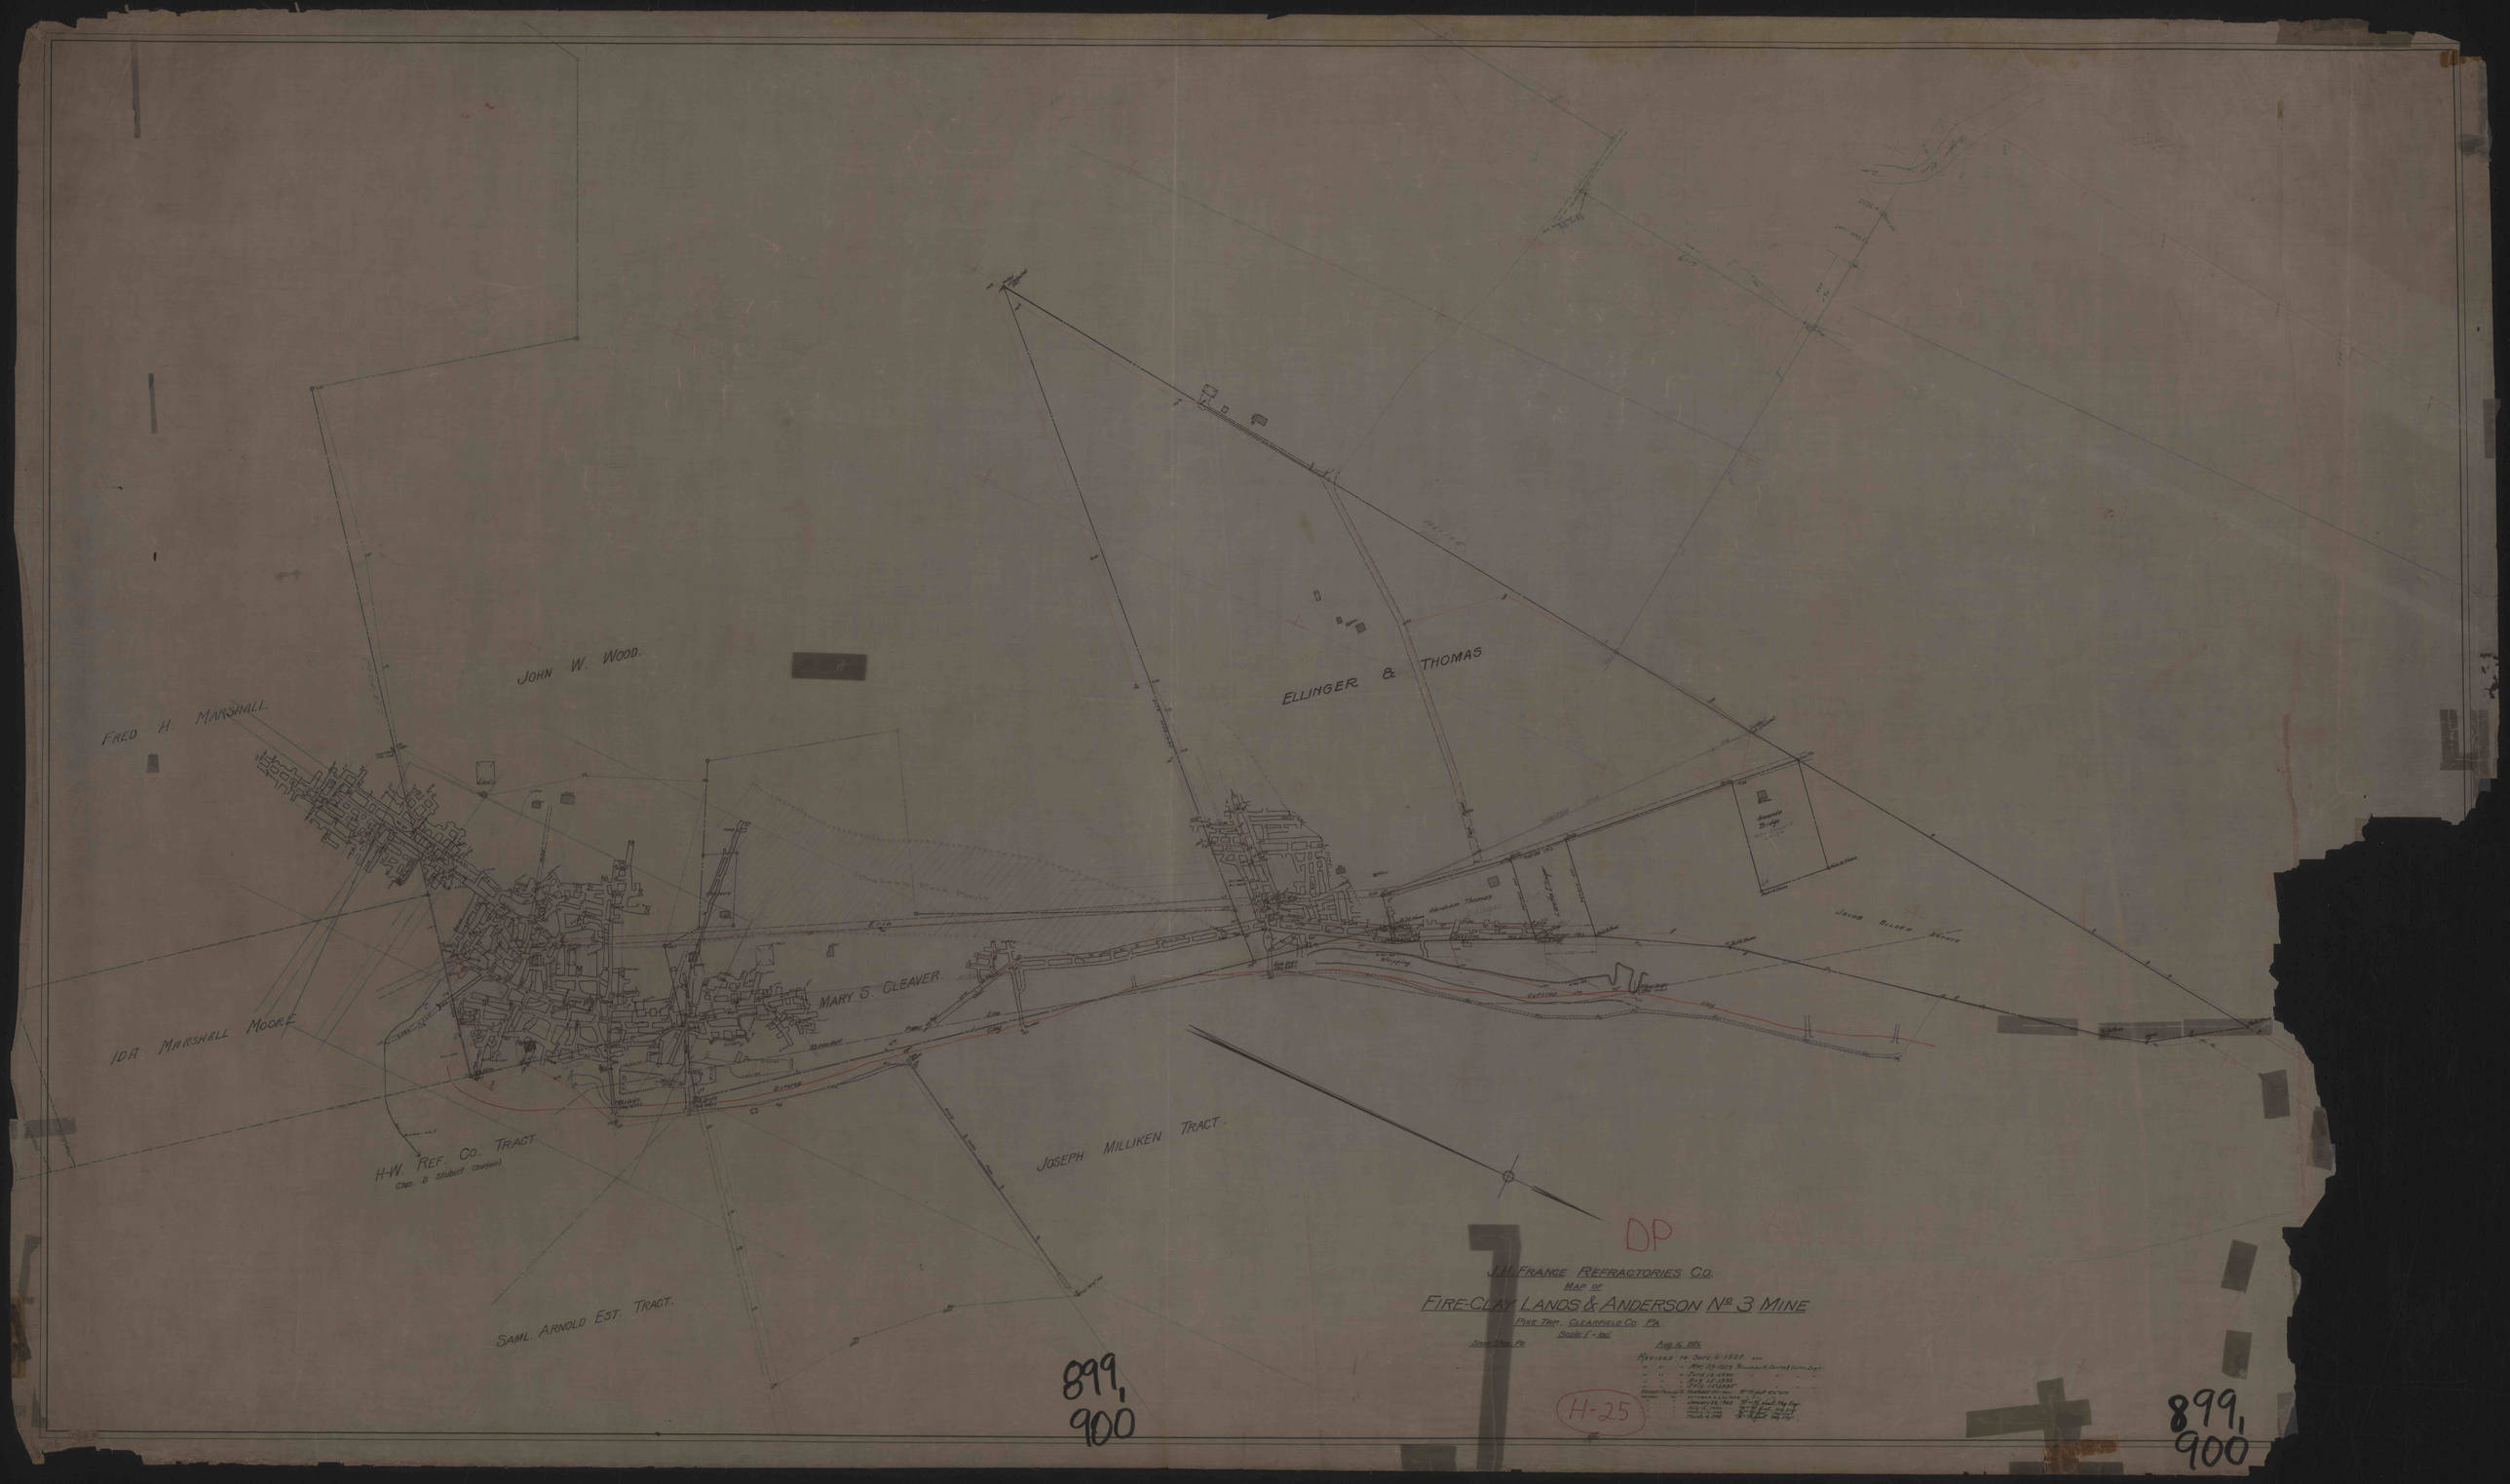

FRED H. MARSHALL
JOHN W. WOOD.
ELLINGER & THOMAS
IDA MARSHALL MOORE
MARY S. CLEAVER.
JACOB BILGER ESTATE
H-W. REF. CO. TRACT
Chas. D. Shubert (Surface)
JOSEPH MILLIKEN TRACT.
SAML. ARNOLD EST. TRACT.
DP
J.H. FRANCE REFRACTORIES CO.
MAP OF
FIRE-CLAY LANDS & ANDERSON Nº 3 MINE
PIKE TWP. CLEARFIELD CO. PA.
Scale: 1" = 100'
Snow Shoe, Pa.
Aug. 16. 1926
REVISED TO SEPT. 6. 1928
H-25
899,
900
899,
900