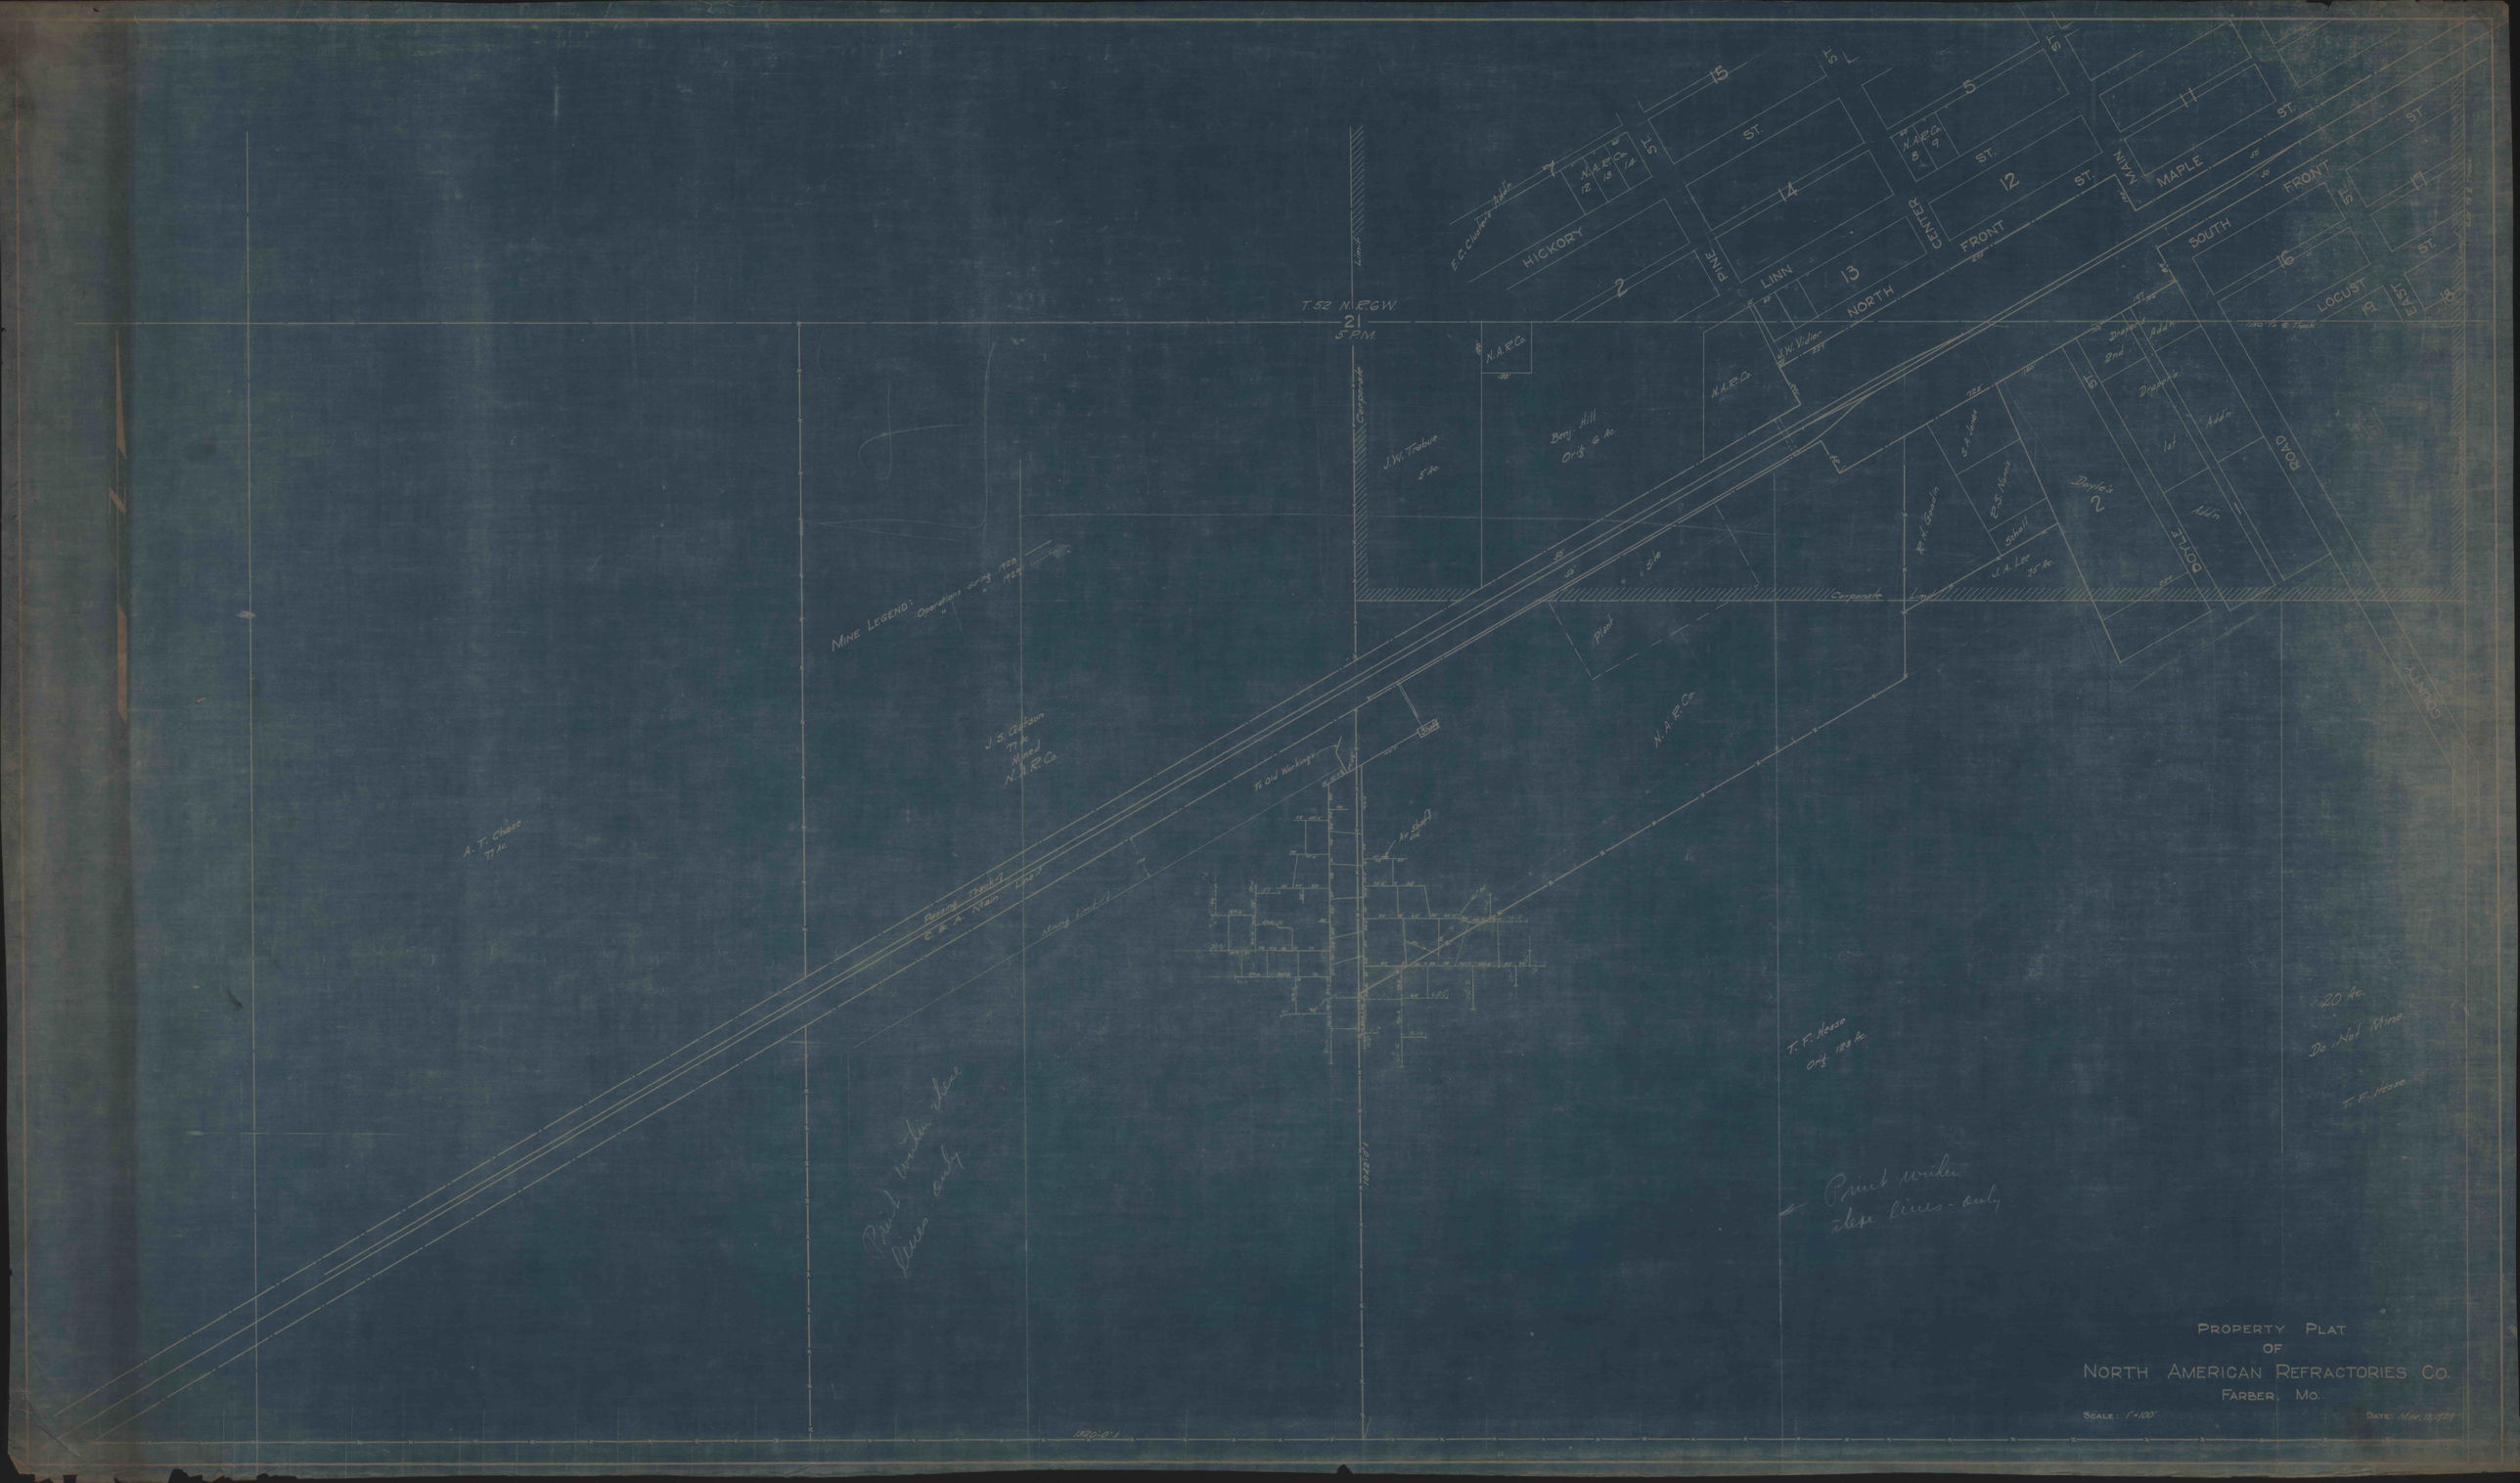


PROPERTY PLAT
OF
NORTH AMERICAN REFRACTORIES CO.
FARBER, MO.

SCALE: 1" = 100'

DATE: Mar. 13, 1929