



Make 2 of these (entire tracing)

MATCH LINE

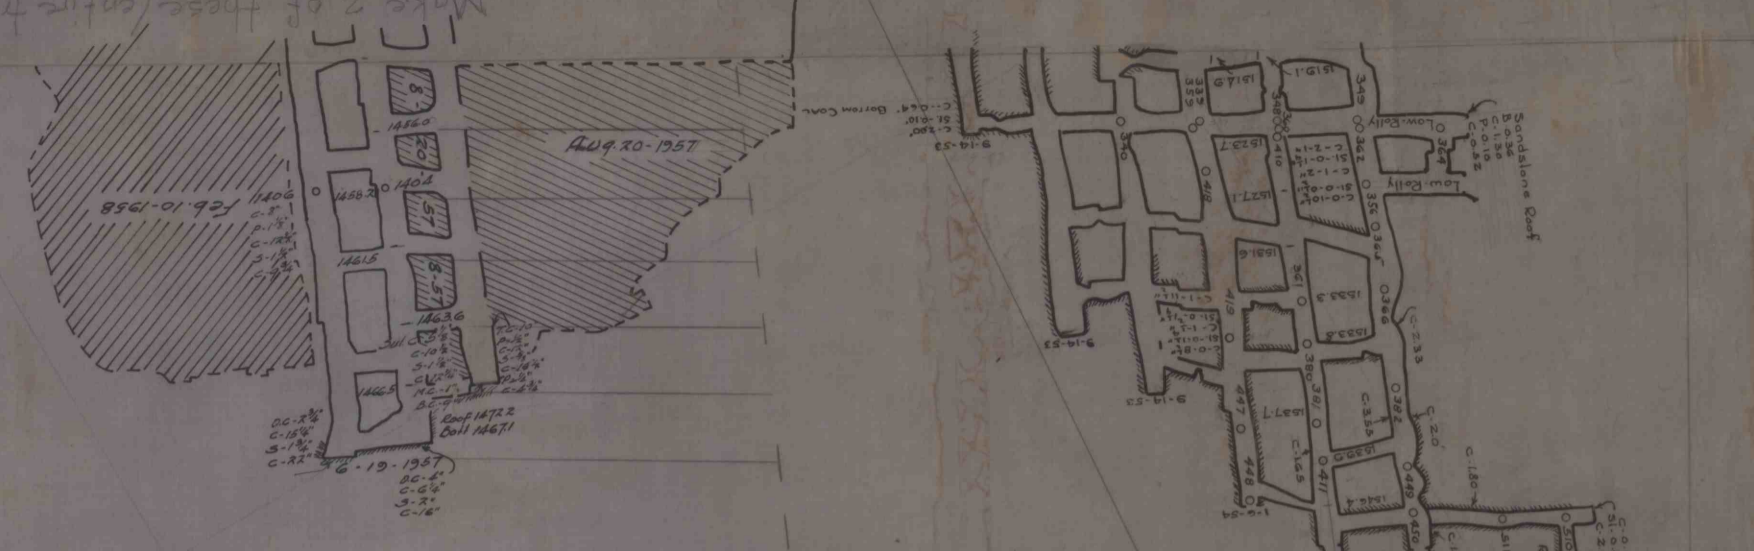

© D.D.H.'H

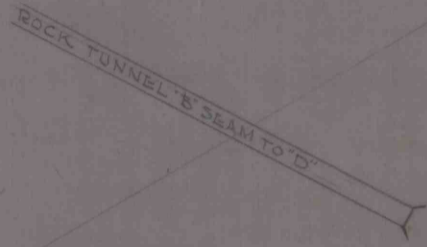

© D.D.H.'H

© © Logon No. 4
 © © Water Discharge Holes
 © Logon No. 4 Power Core Holes

