


947  
948  
949

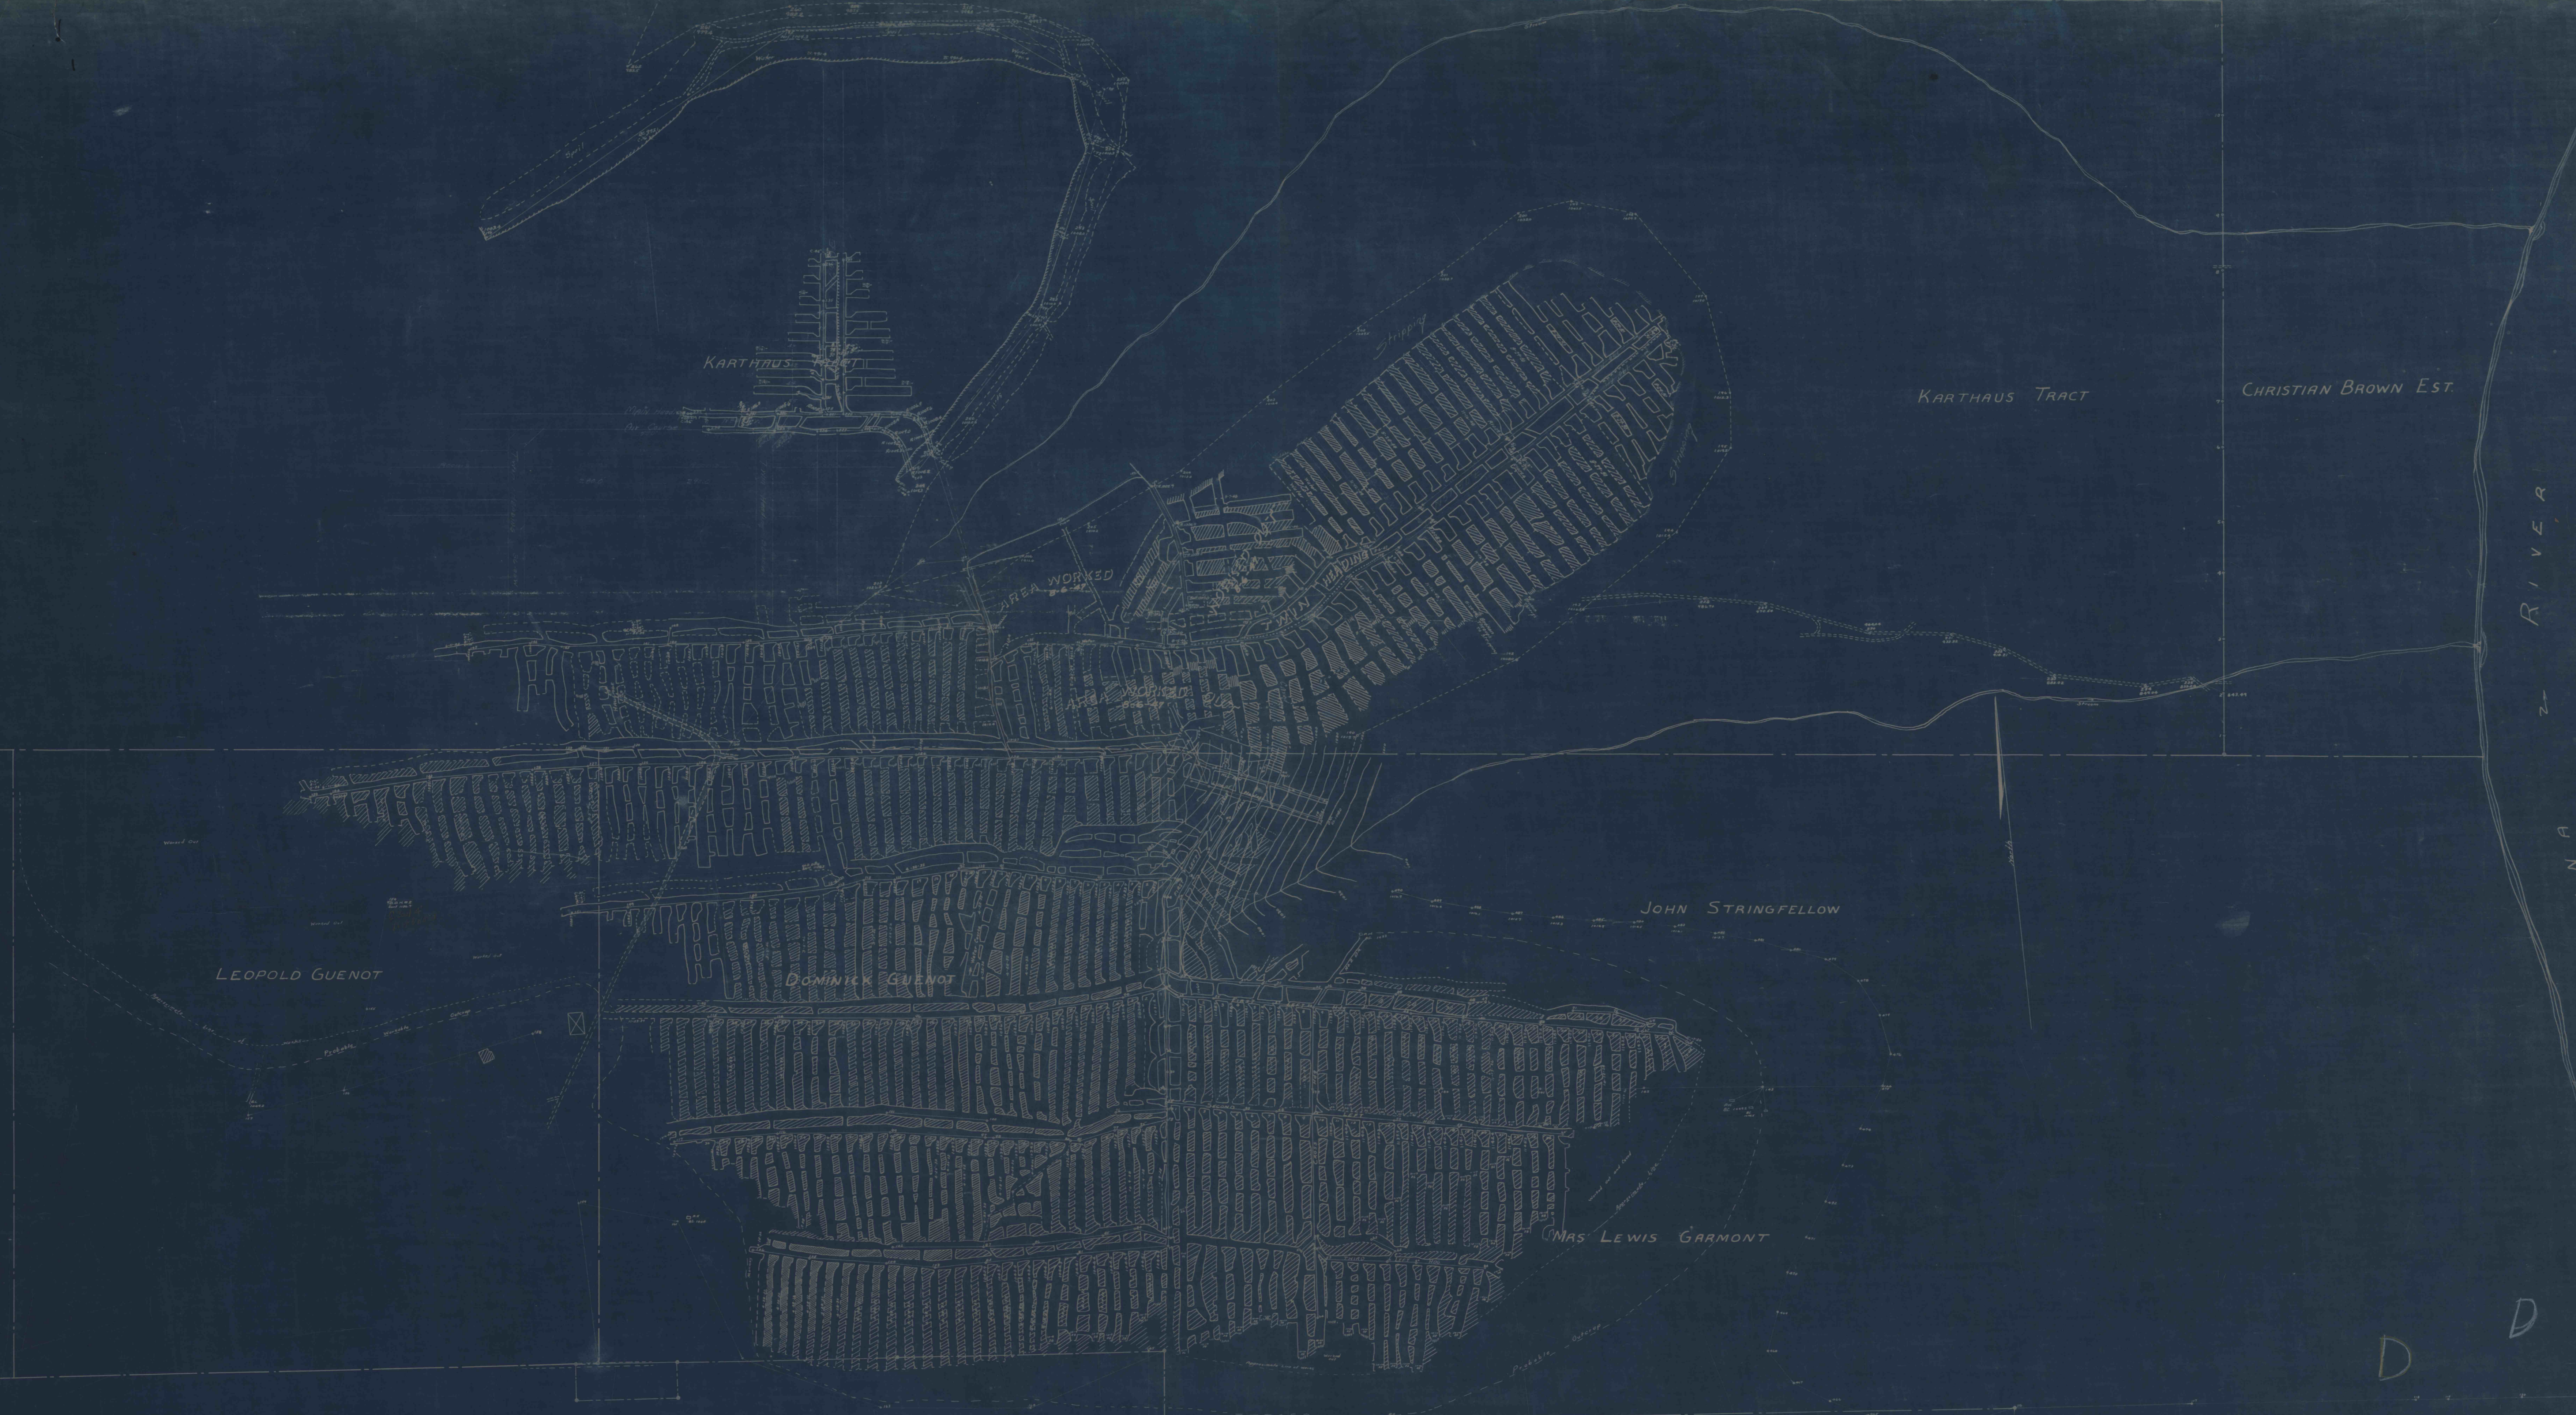

F.R. & H.L. HARRINGTON  
 ADAMS, MASS.  
 COAL LANDS 49-A

IN  
 KARTHUS TWP., CLEARFIELD CO. PA.  
 SCALE 1"=100'  
 CLEARFIELD, PA. OFFICE OF THE ENGINEER  
 DEC. 16, 1881

47A

FRANK GUENOT

COVINGTON TWP

KARTHUS TWP

JB VALLIMONT

947  
948  
949