

Beaver Run Coal Company.

MAP SHOWING

Logan Coal Company Workings


ON "D" SEAM

IN RELATION TO HEADINGS ON "E" SEAM

SCALE - 1" = 100'

ENGINEERING OFFICES
GARDNER-MSTOKER
JOHNSTOWN - PENNA.

SEPT-1920

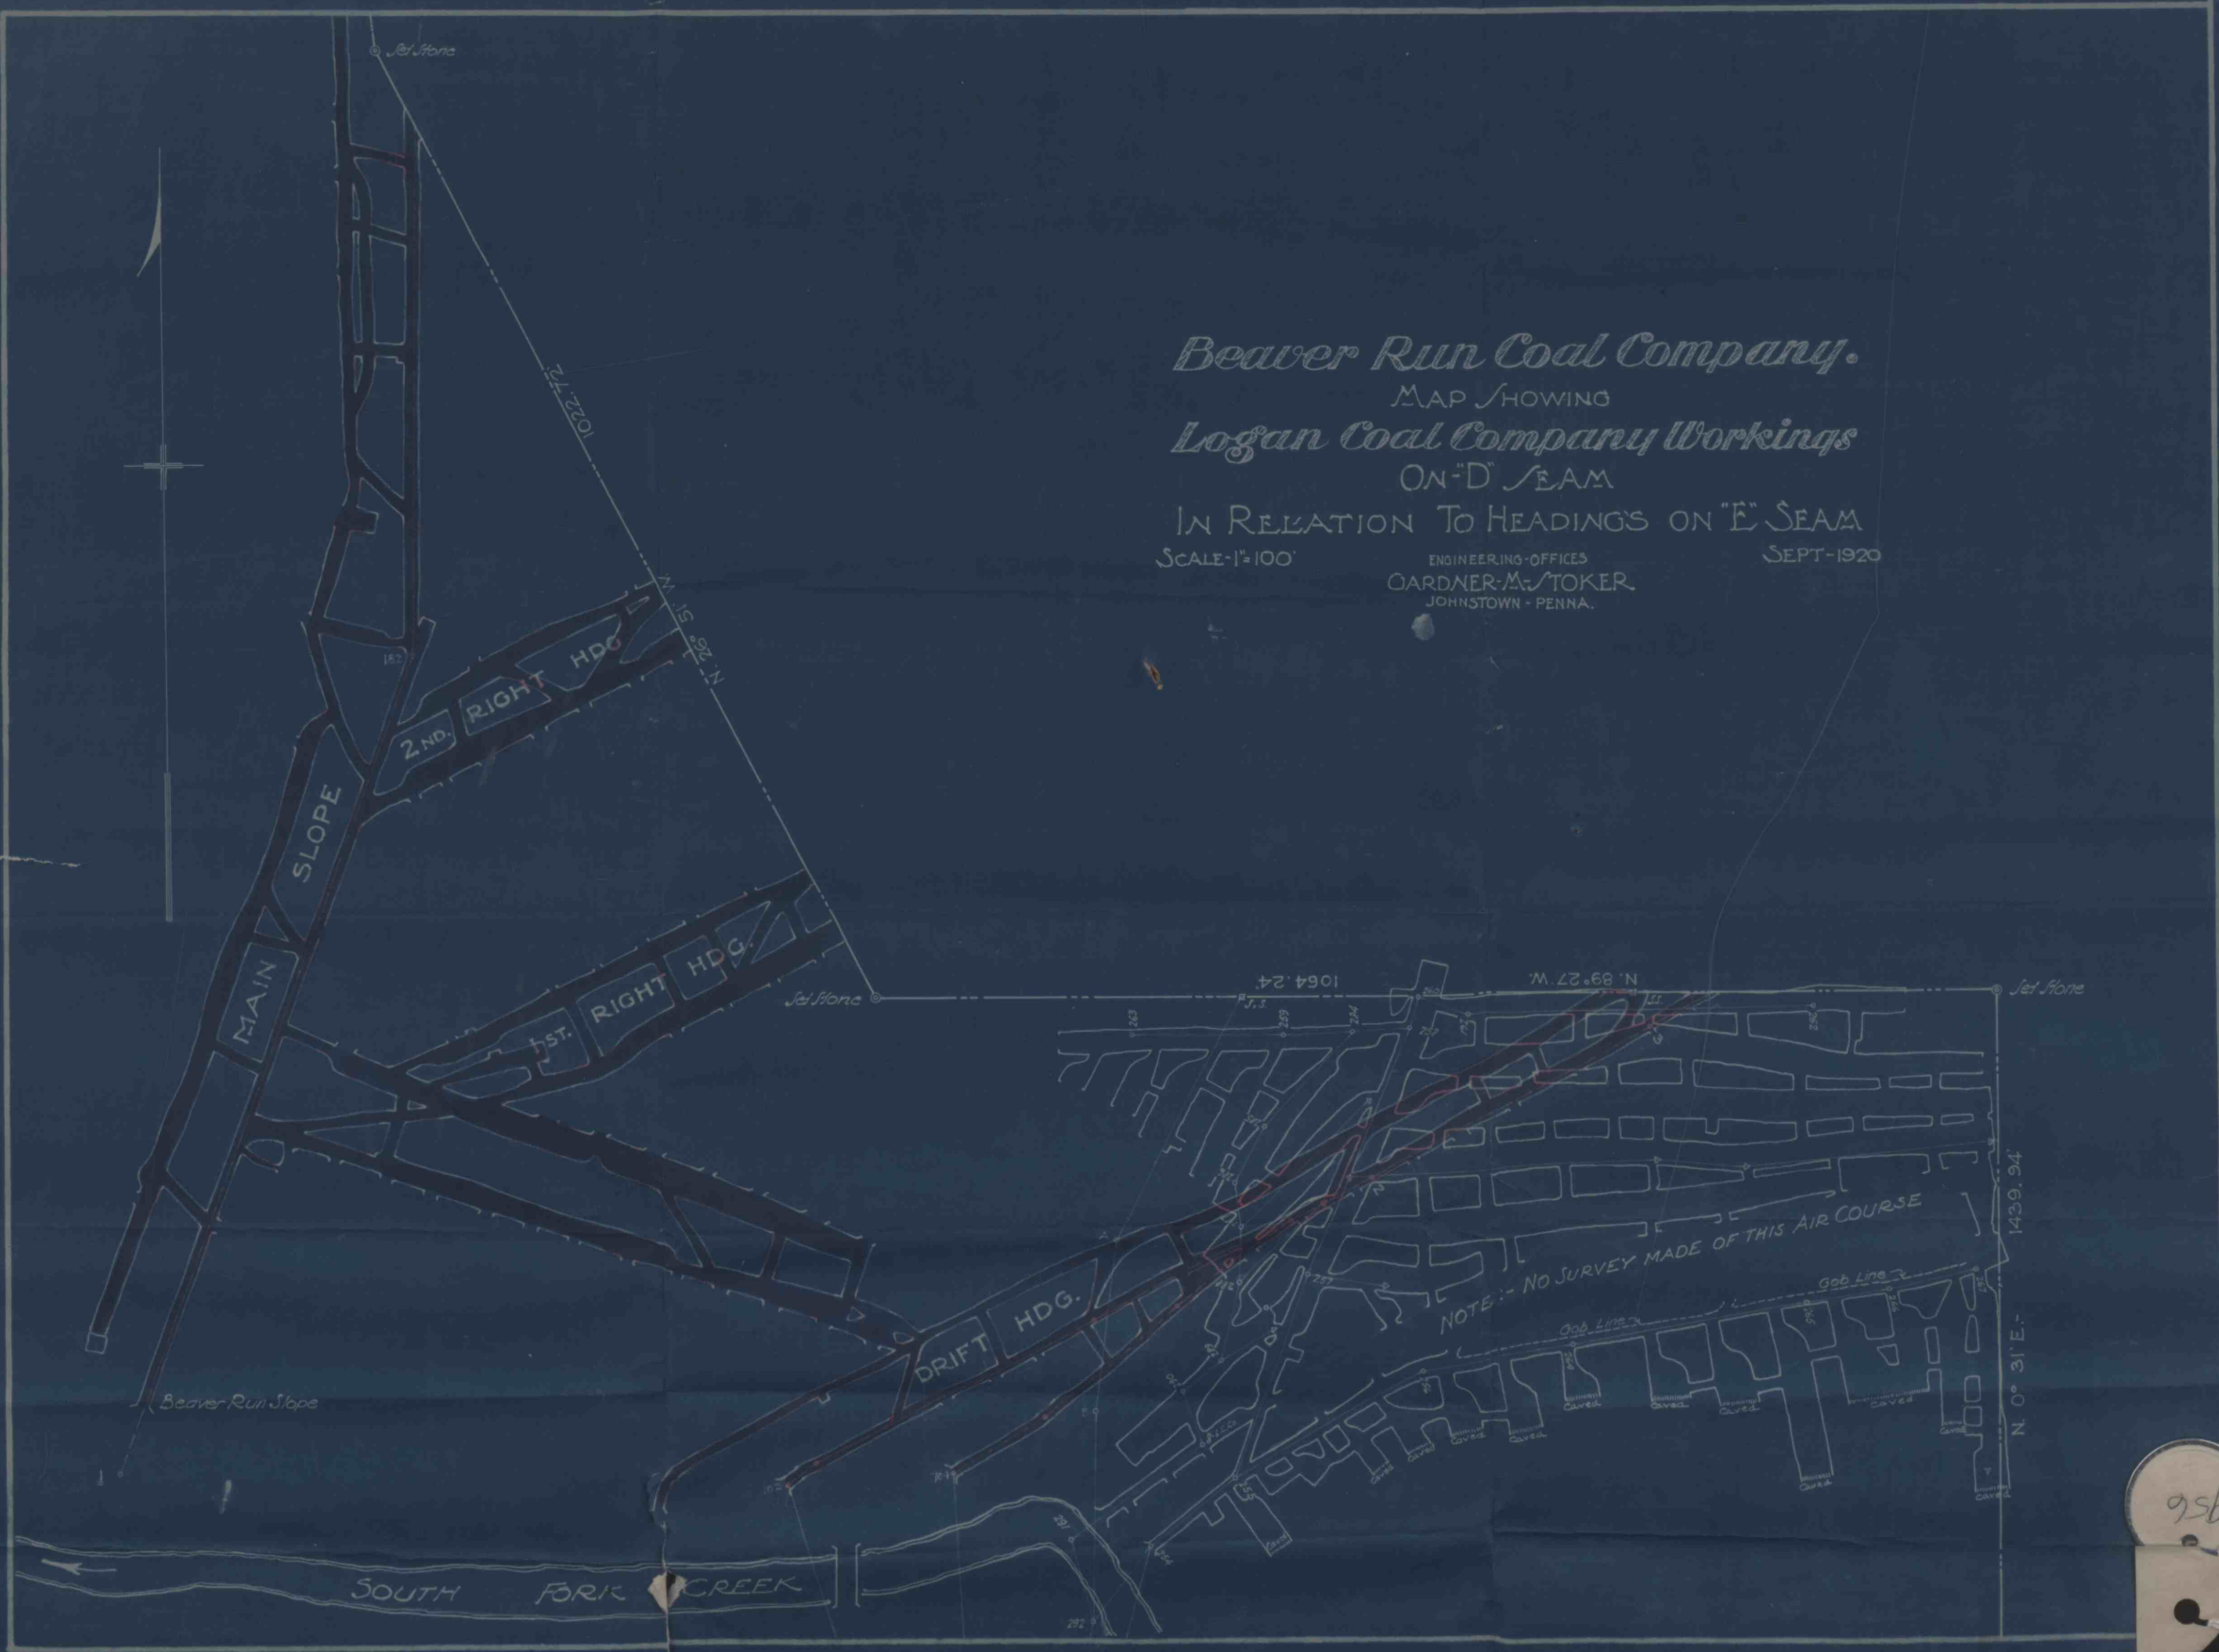

956