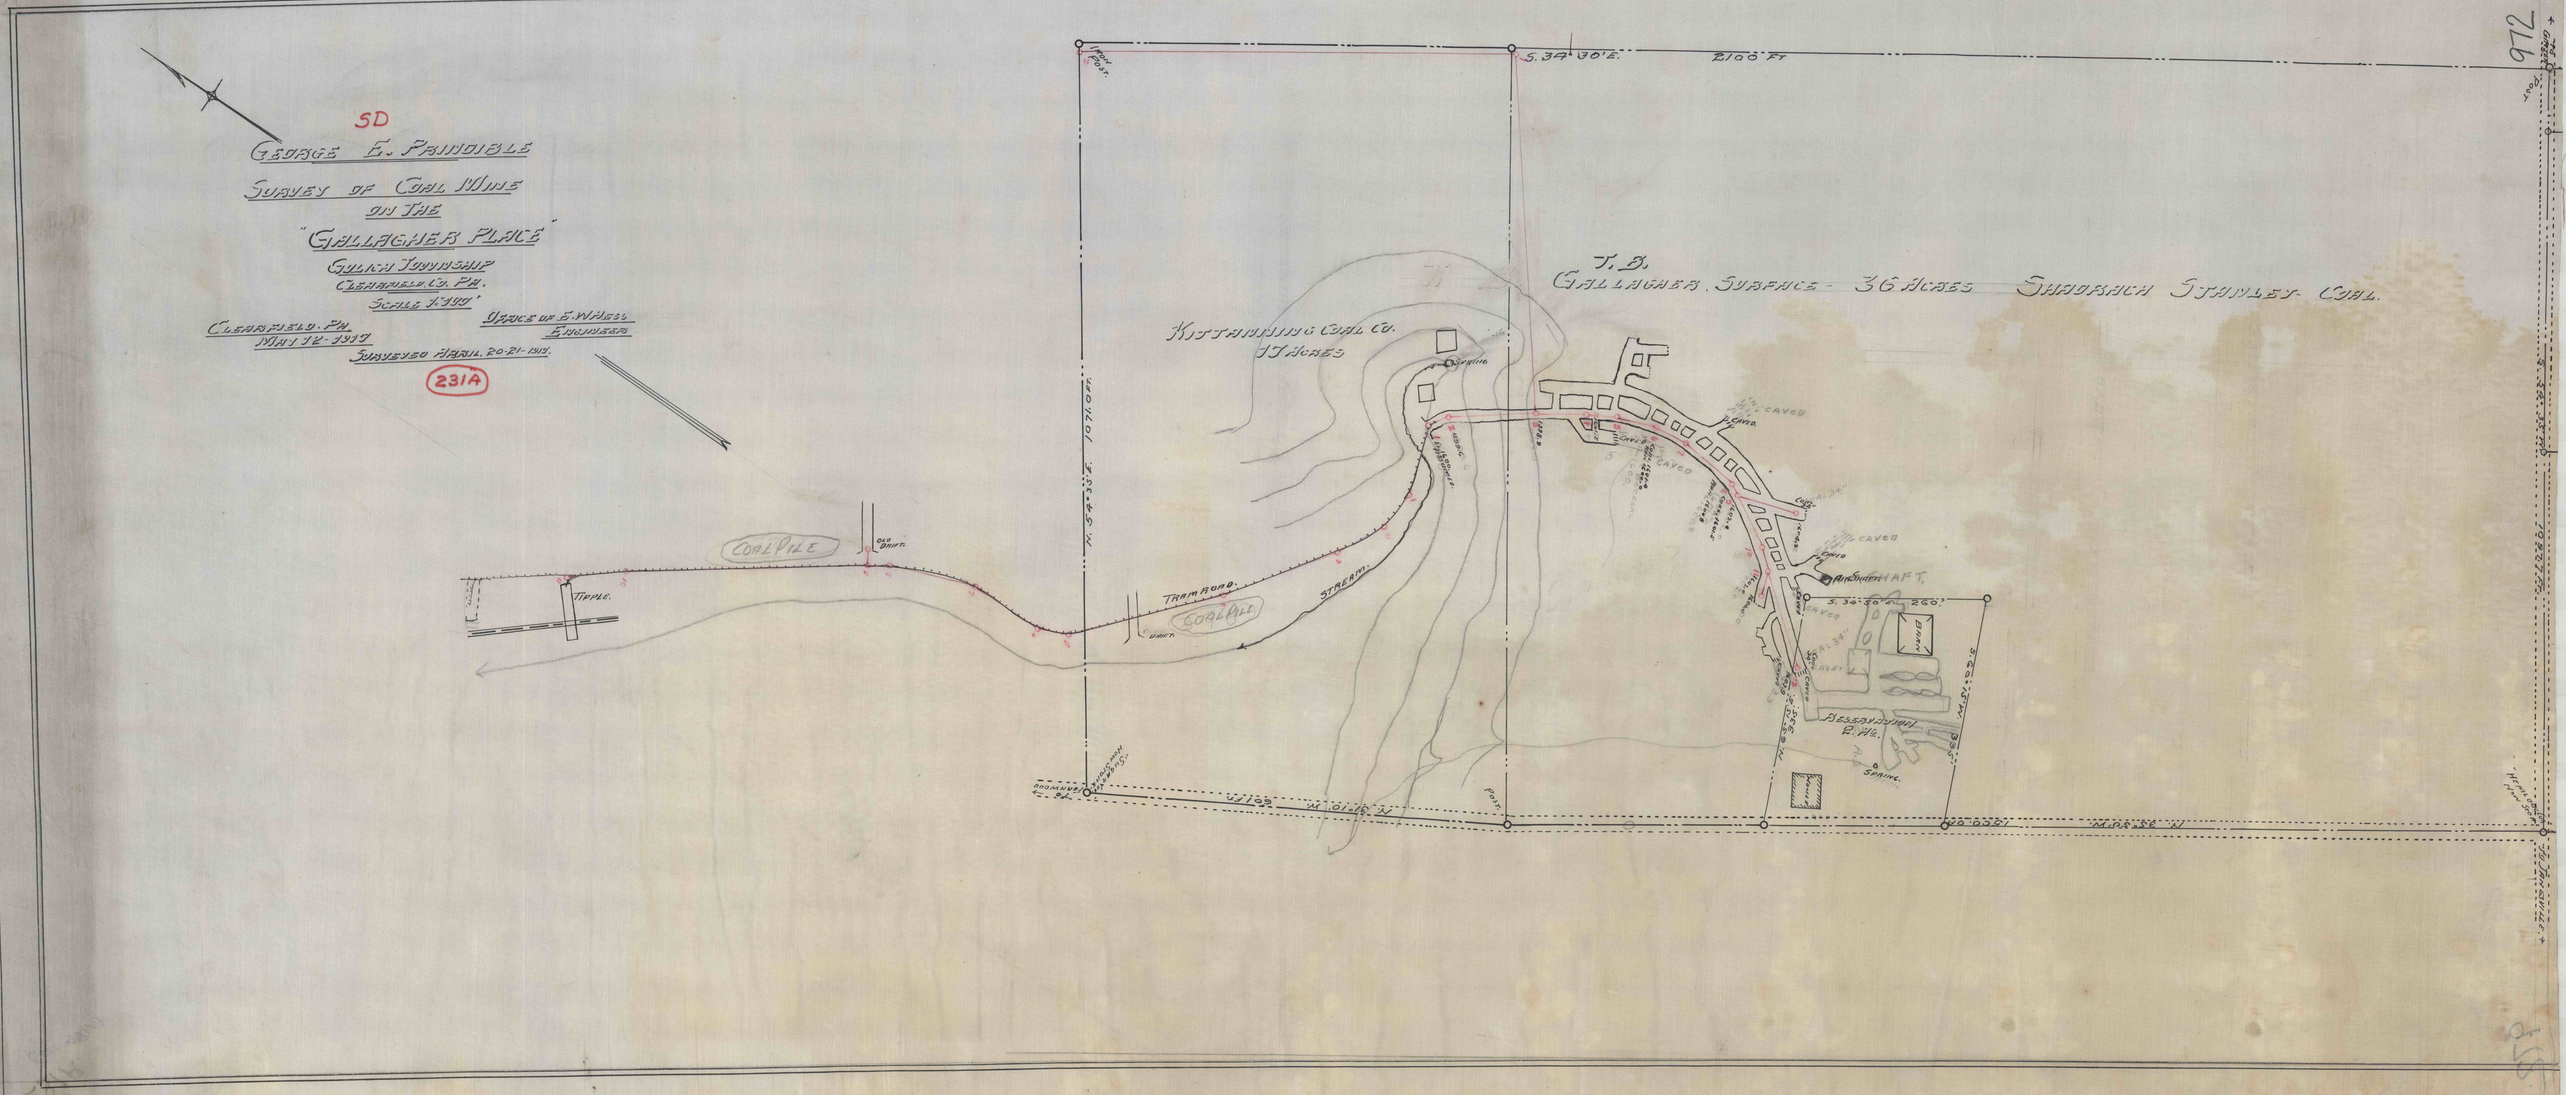
SD
GEORGE E. PRINDIBLE
SURVEY OF COAL MINE
ON THE
"GALLAGHER PLACE"
GULICH TOWNSHIP
CLEARFIELD CO. PA.
SCALE 1"=100'
CLEARFIELD. PA.
MAY 12-1917
OFFICE OF E. WHESS
ENGINEER
SURVEYED APRIL 20-21-1917.
231A
T. B.
GALLAGHER. SURFACE - 36 ACRES SHADRACH STANLEY COAL.
KITTANNING COAL CO.
17 ACRES
S. 34° 30' E.
2100 FT
N. 54° 35' E. 1071.0 FT.
COAL PILE
TIPPLE.
TRAMROAD.
STREAM.
CAVED
SHAFT.
BARN
RESERVATION
2 AC.
SPRING.
POST.
972