


BEVERDALE - #15

MAP SHOWING INSIDE WORKINGS, ELEVATIONS OF SAME, BEAVER RUN,  
OUTSIDE WORKINGS OF #15 AND 5 FT. CONTOURS OF SURFACE ALONG  
BEAVER RUN. (R-47)

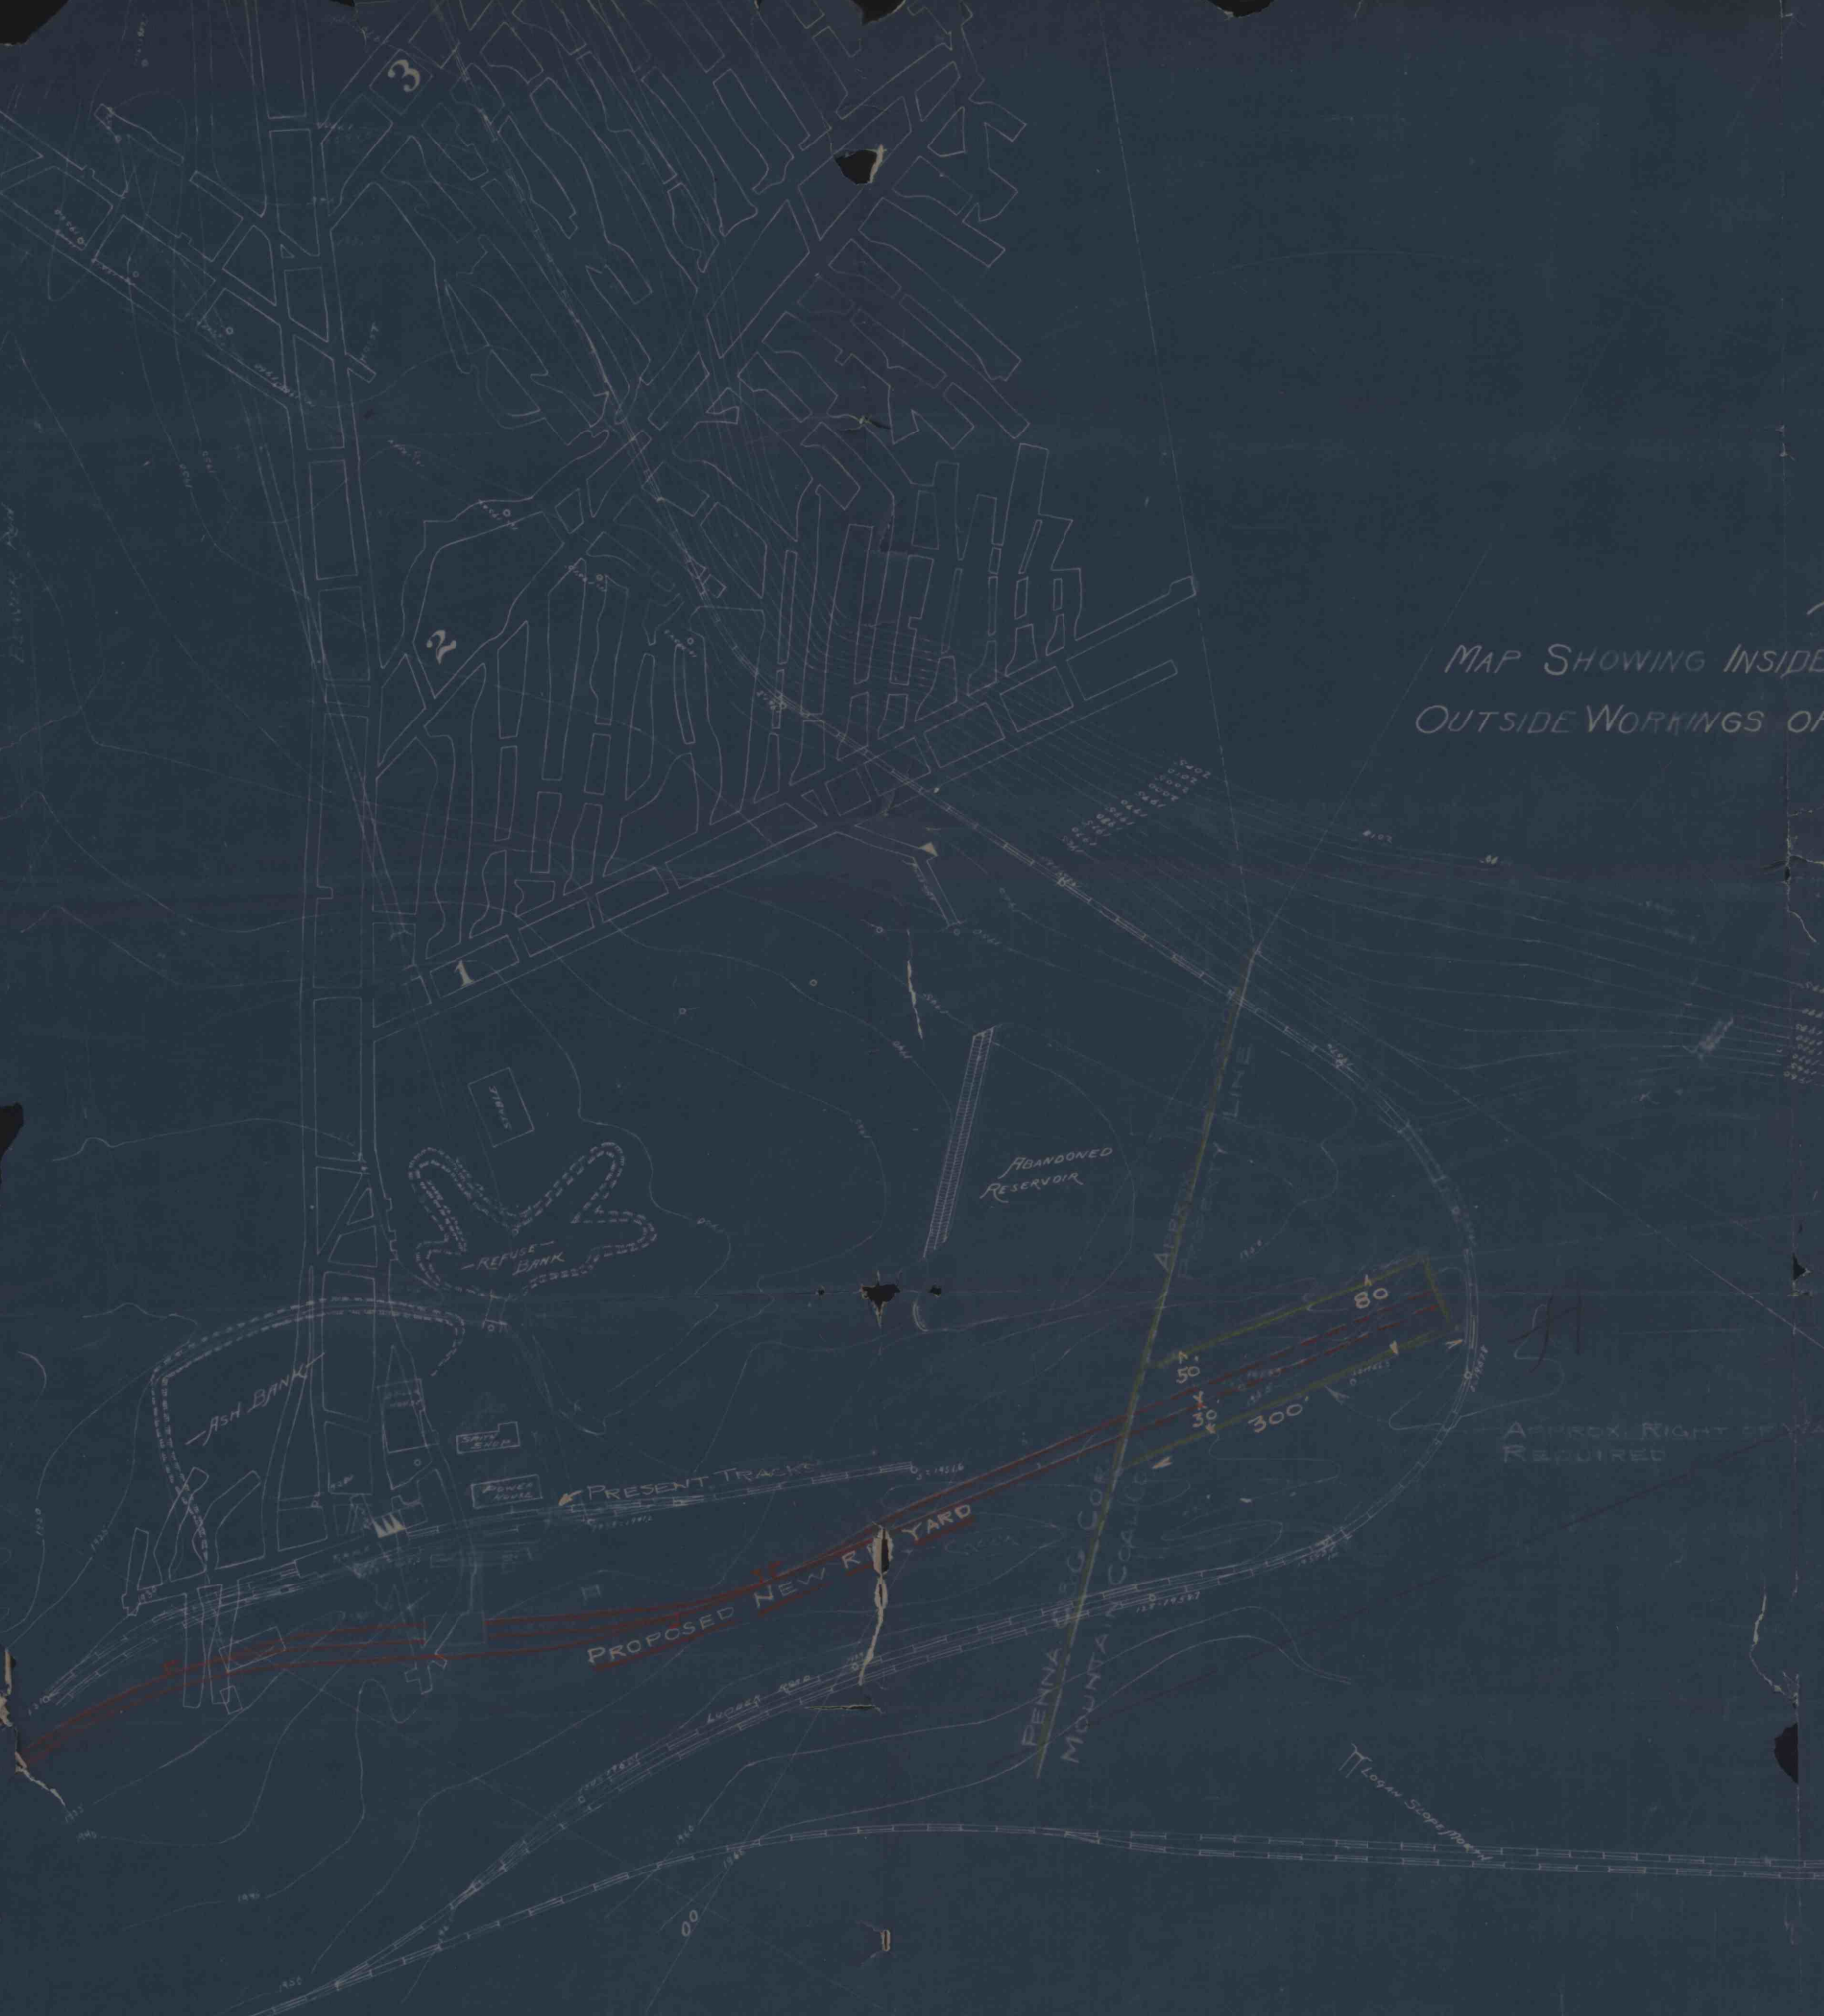

SKETCH SHOWING APPROX.  
EXTENT & LOCATION OF RIGHT-  
OF-WAY REQUIRED FOR PROPOSED  
EXTENSION OF RAILROAD TRACKS  
FROM BEAVERDALE NO. 15 MINE  
APRIL 19TH, 1916. SCALE - 1" = 100'

Map showing  
#15 workings  
Beaverdale  
mine