


ABRAM PEARCE ESTATE

Geo. BARRAM Yr

PAUL COX Yr

M.P.R.

History

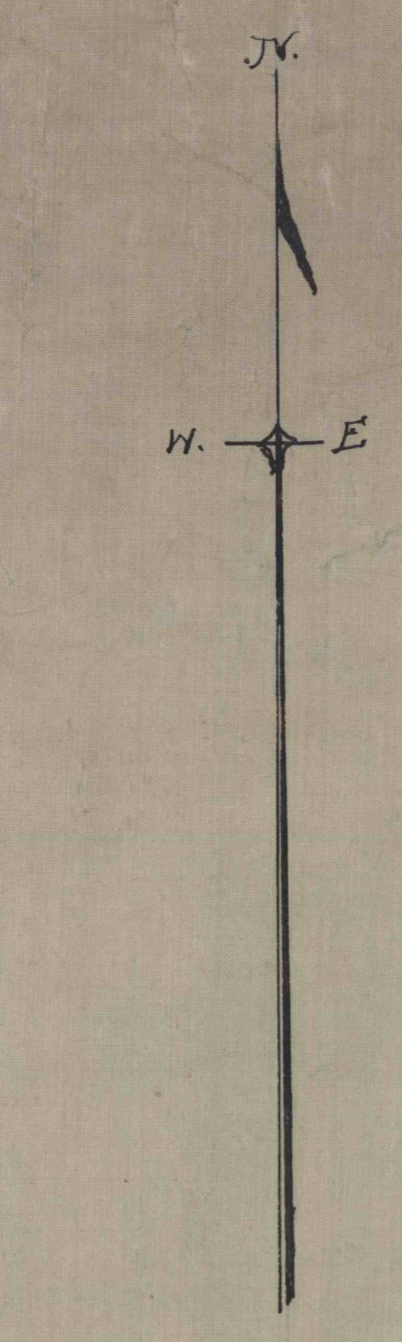

DJ
ABRAM PEARCE ESTATE
SURVEY OF
FIRE CLAY MINES.
OPERATED BY
THE WILLIAMS GROVE BRICK COMPANY.
Bless, Cleared County, Penna.
Scale 1/100'

CONVEYED TO
JULY 20, 1902
BY SURVEY OF
JULY 1, 1904
JULY 2, 1904



W. Dixon