
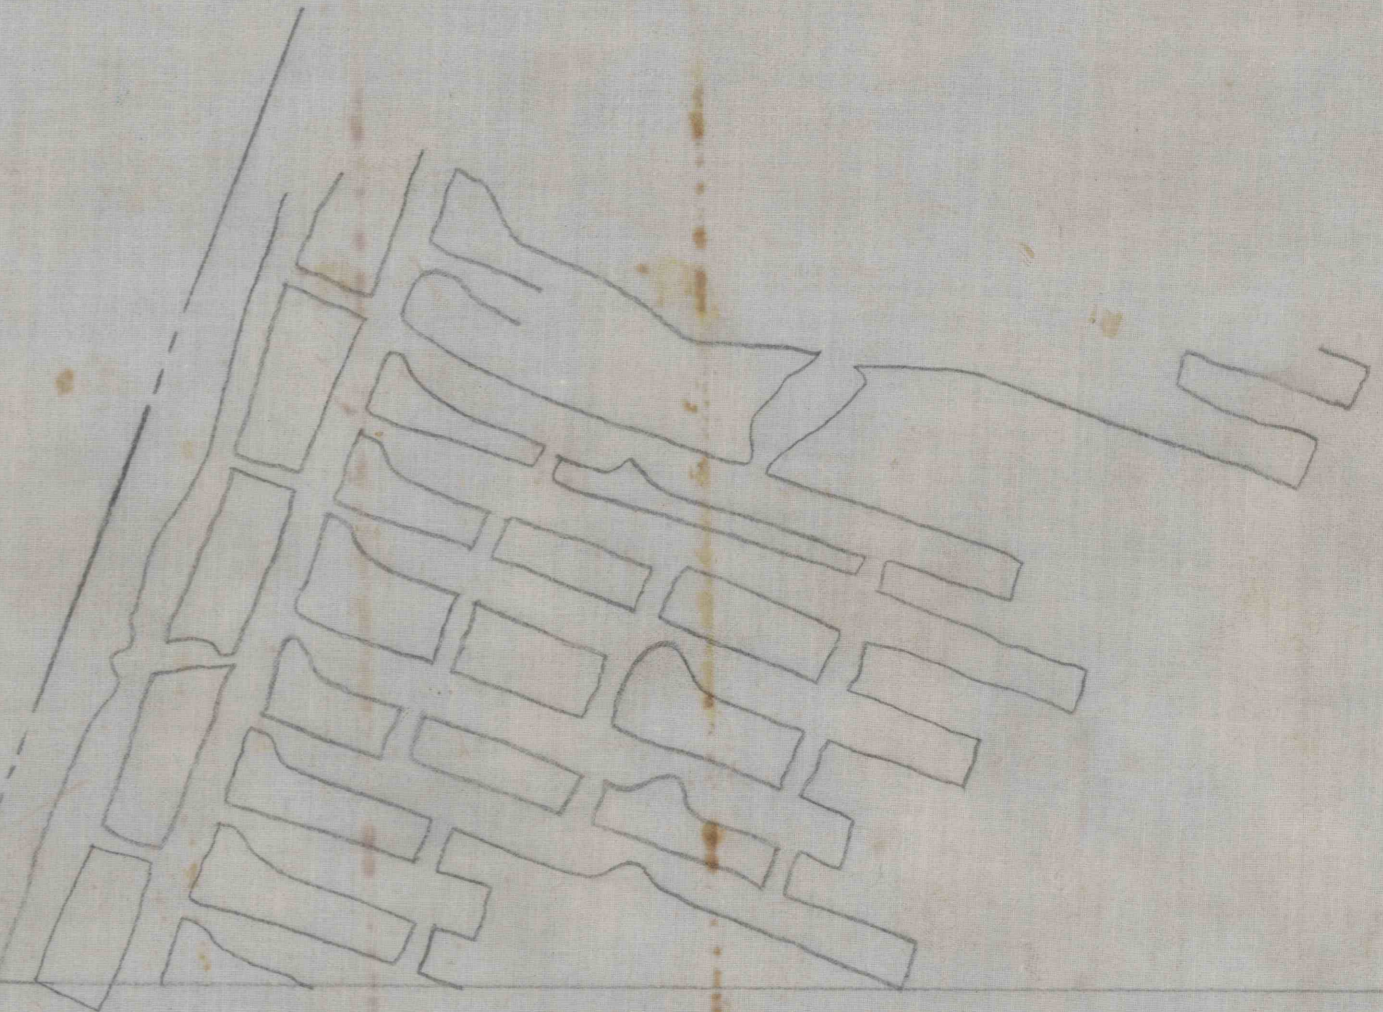


SONNMAN
SHAFT

COAL
CO.

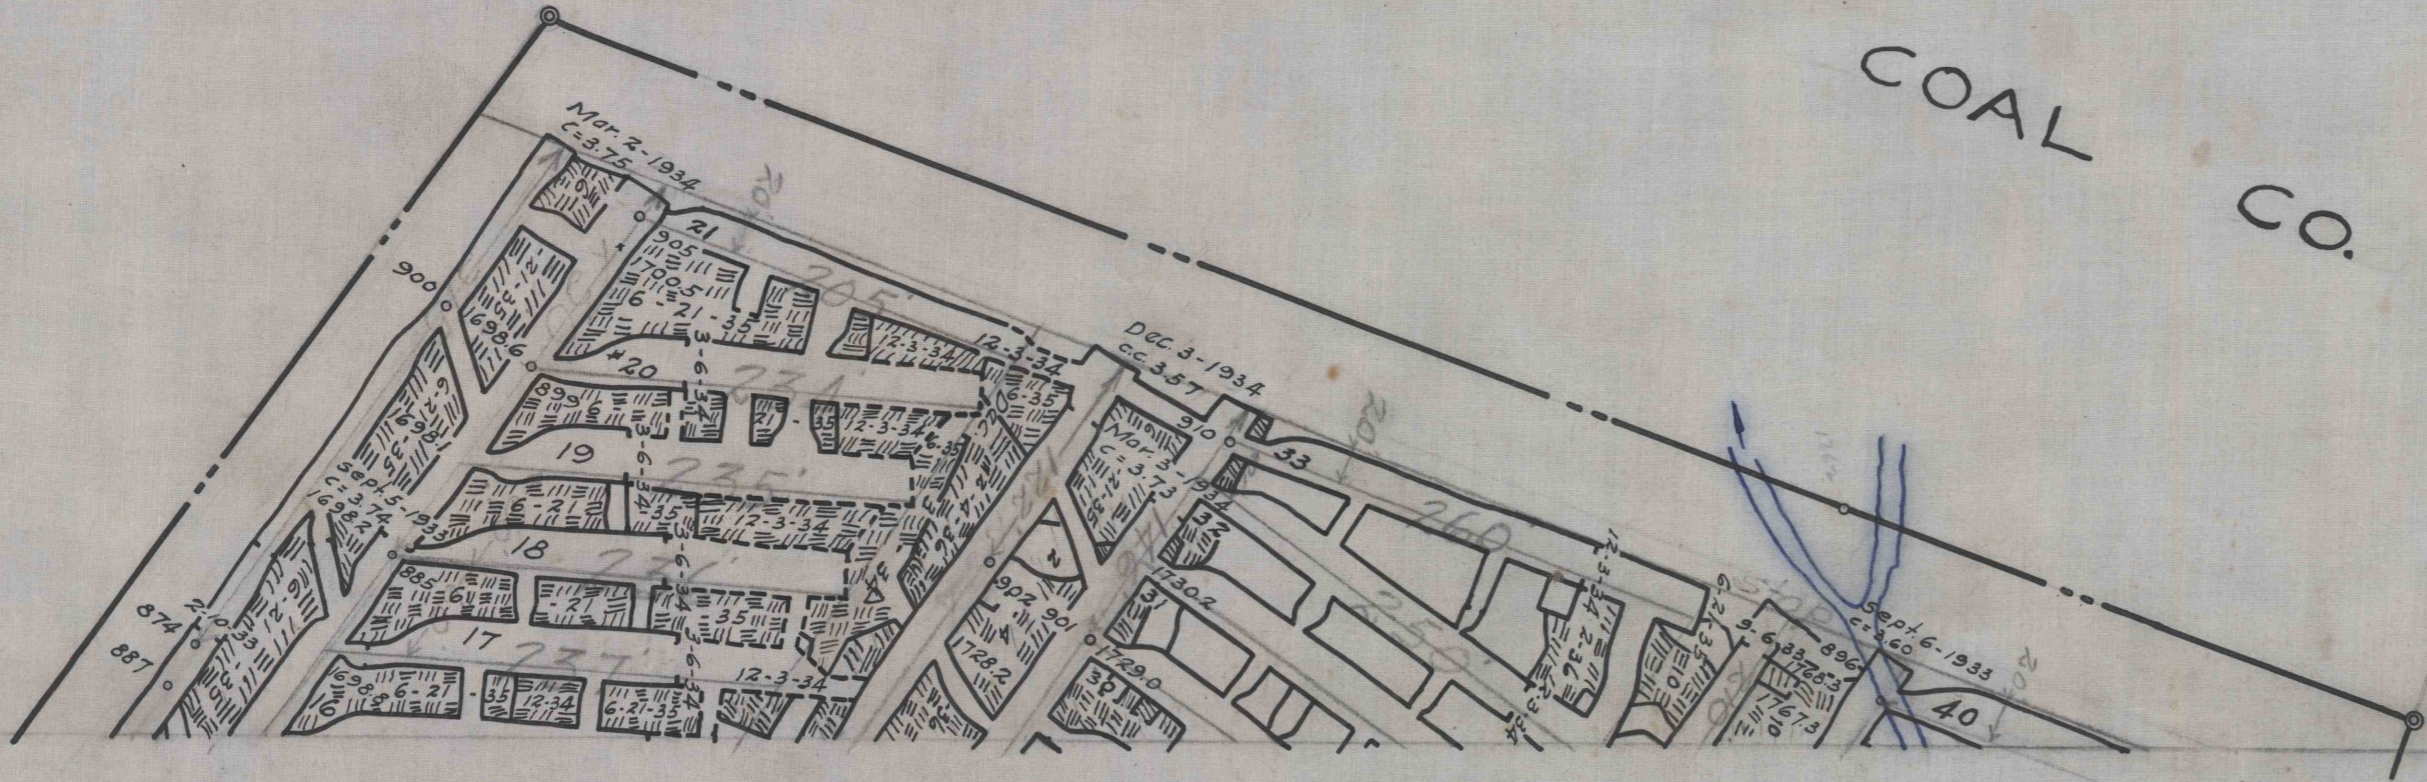

4
00