LLOYDELL FUEL CO.

MAP OF

MINE WORKINGS

LLOYDELL, CAMBRIA CO., PA.

–Scale, 1"=100'–

October-30th-1918

–Gardners M. Stoker–

Mining Engr.–Johnstown, Penna.

Note:–

All work this side of red line copied from old prints. All pillars are supposed to have been drawn

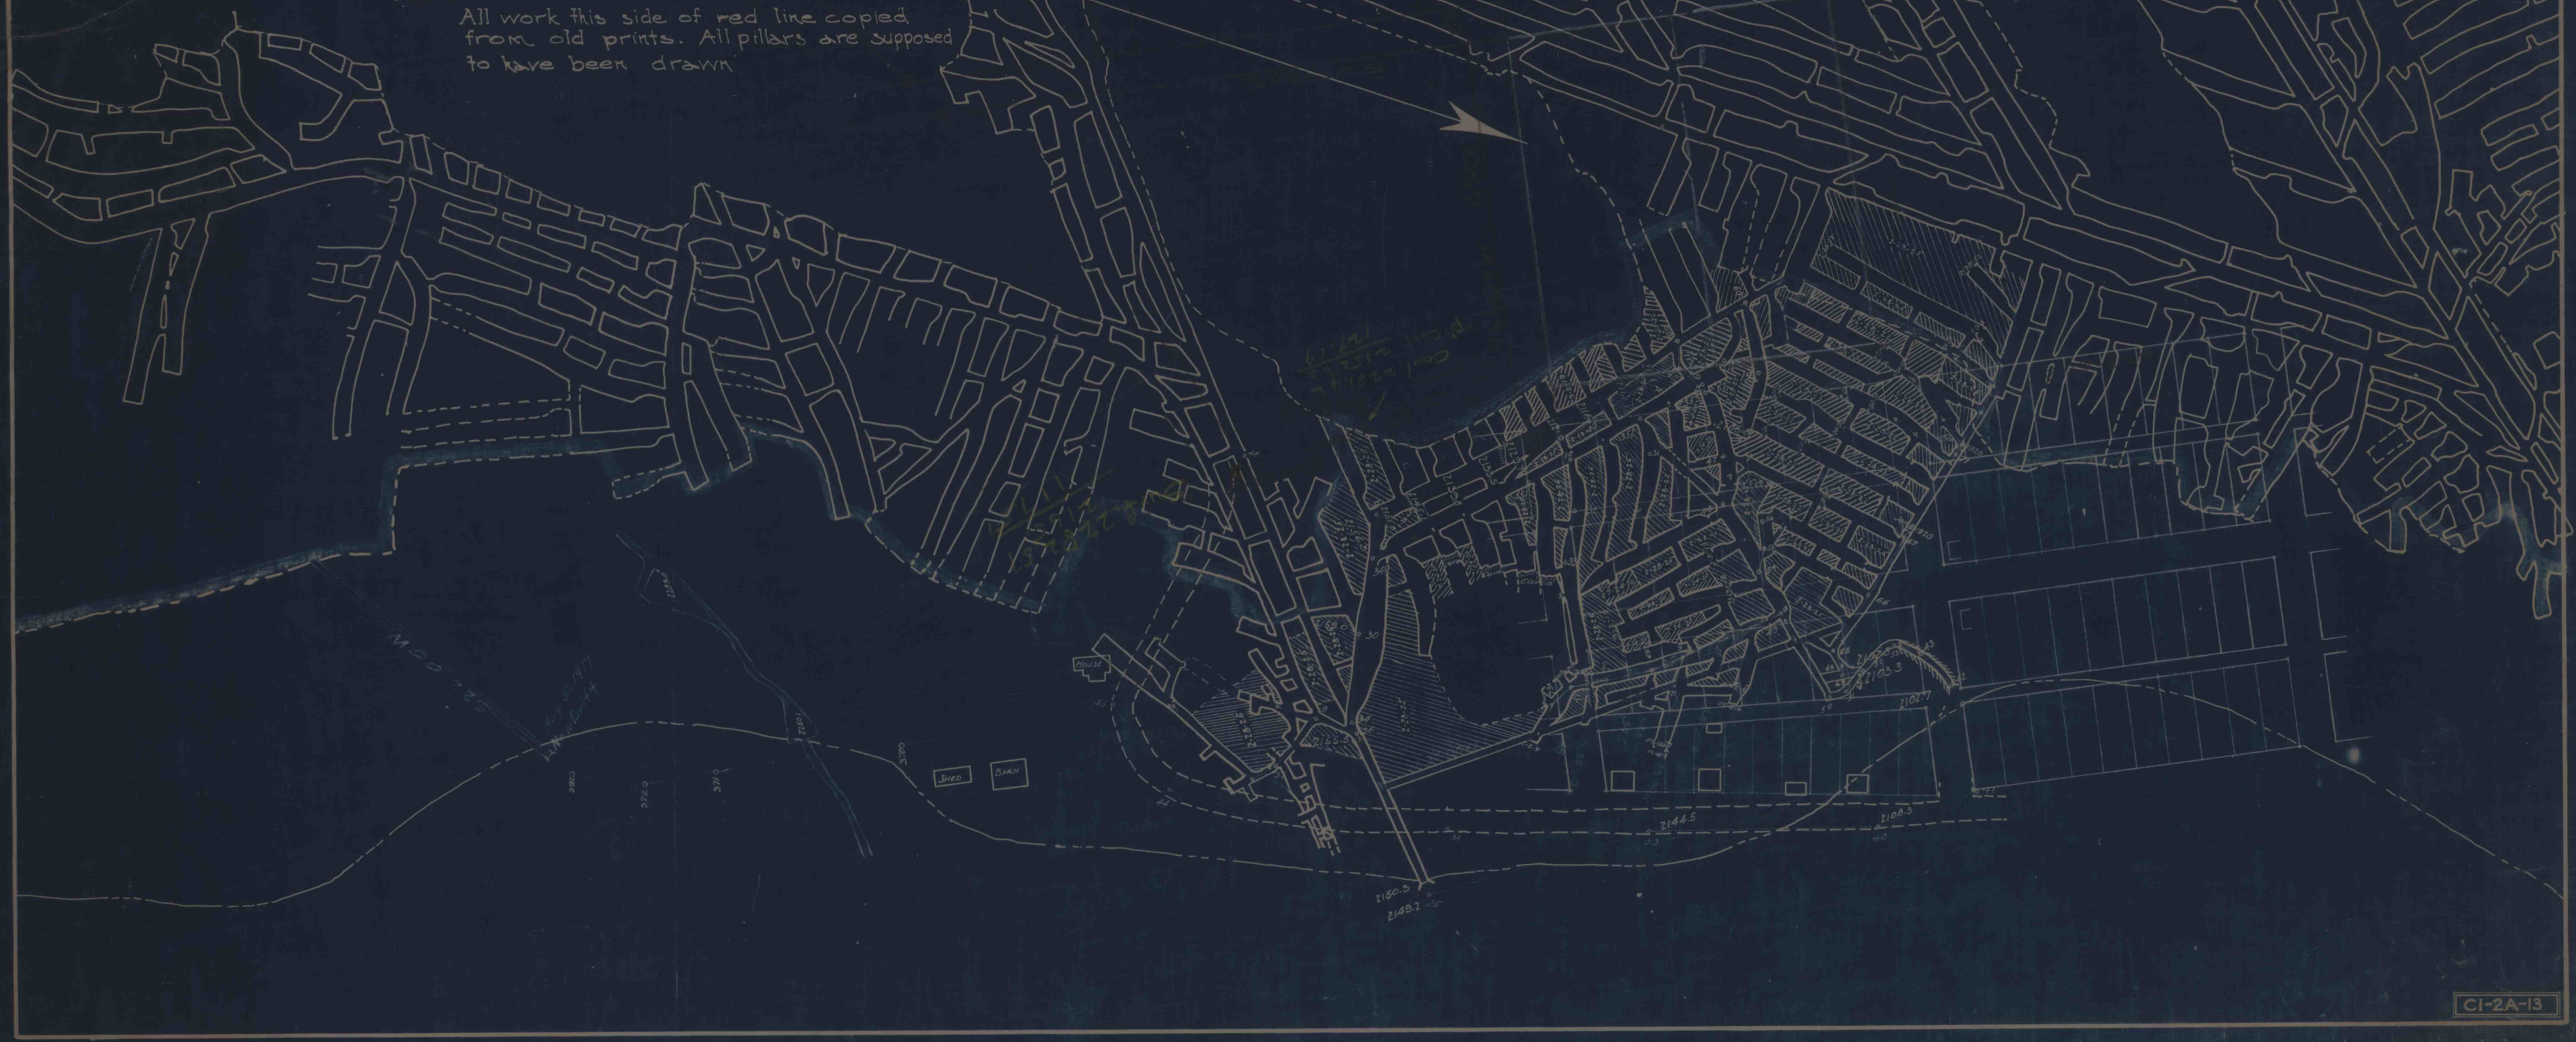

CI-2A-13