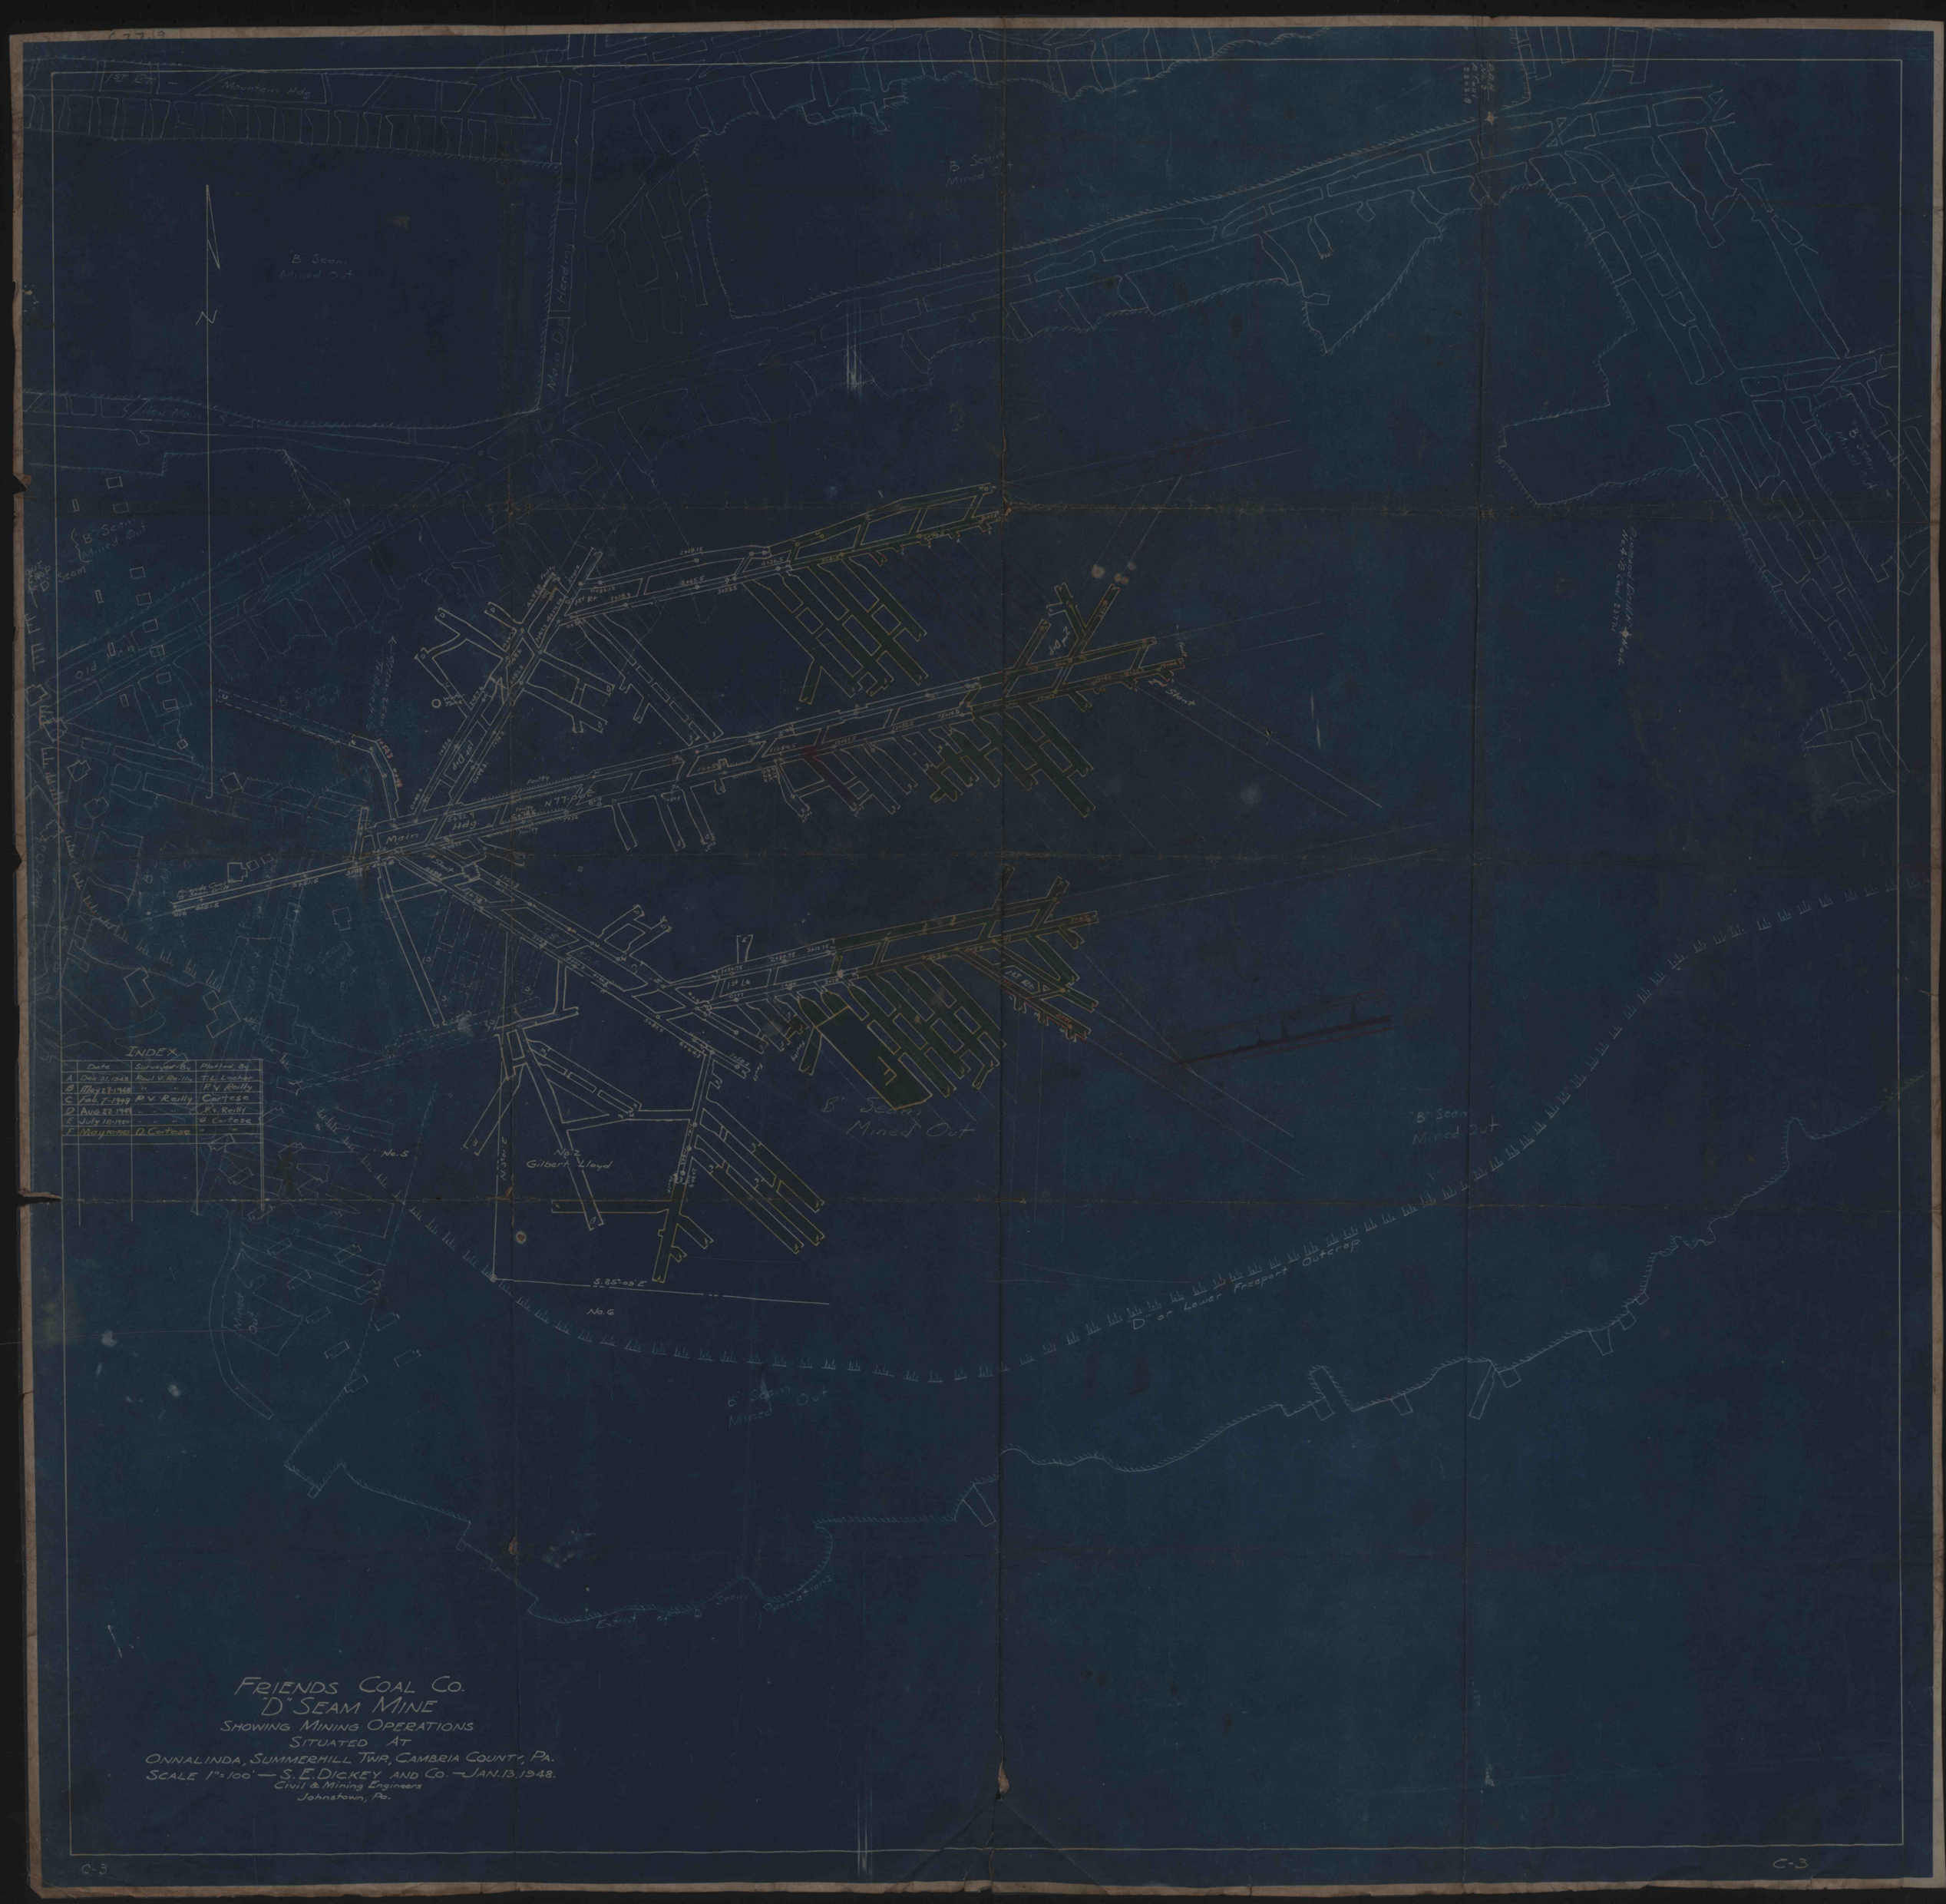

INDEX

	Date	Surveyed By	Plotted By
A	Dec. 31, 1948	Paul V. Reilly	T. L. Locher
B	May 27-1948	" "	P. V. Reilly
C	Feb. 7-1949	P. V. Reilly	Cortese
D	Aug. 22-1949	" "	P. V. Reilly
E	July 18-1950	" "	D. Cortese
F	May 10-1951	D. Cortese	" "

FRIENDS COAL CO.
"D" SEAM MINE
SHOWING MINING OPERATIONS
SITUATED AT
ONNALINDA, SUMMERHILL TWP., CAMBRIA COUNTY, PA.
SCALE 1" = 100' — S. E. DICKEY AND CO. — JAN. 13, 1948.
Civil & Mining Engineers
Johnstown, Pa.

C-3

C-3