
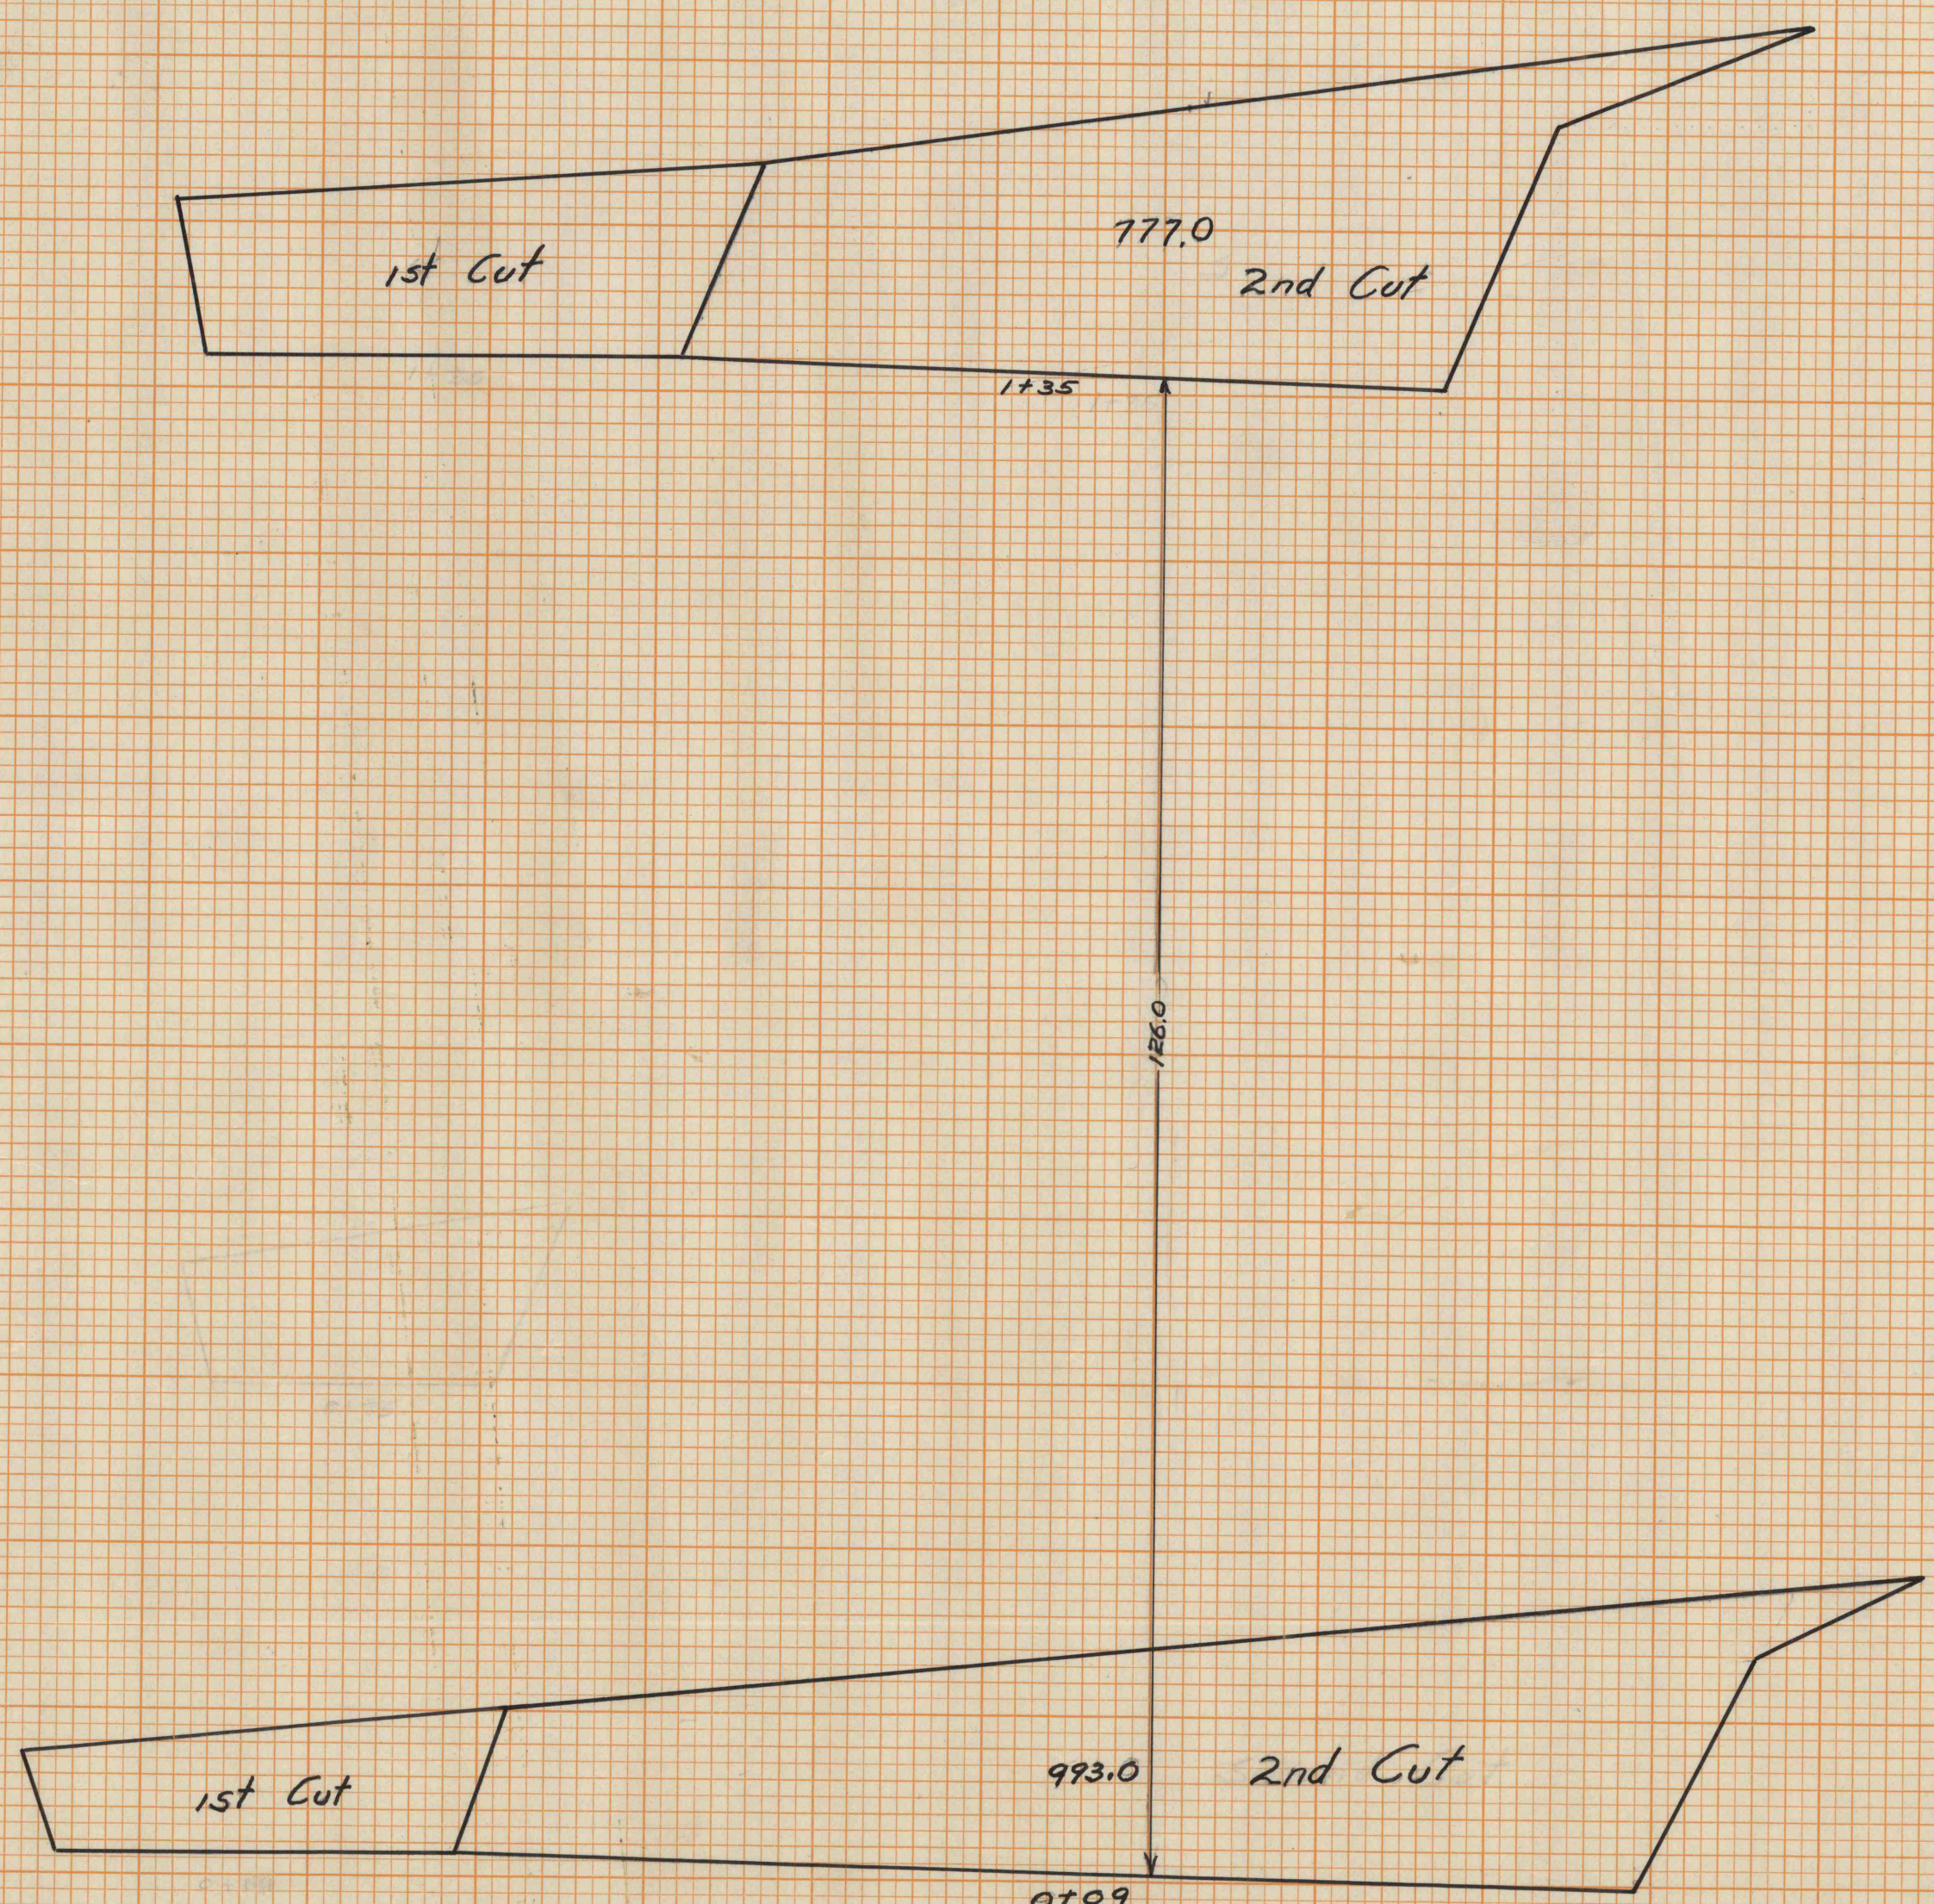


FINAL SURVEY SURVEYED, PLOTTED, NOTE BOOK, TEMPLATE, AREAS CHECKED, NO.

ORIGINAL SURVEY SURVEYED, PLOTTED, NOTE BOOK, TEMPLATE, AREAS CHECKED, NO.

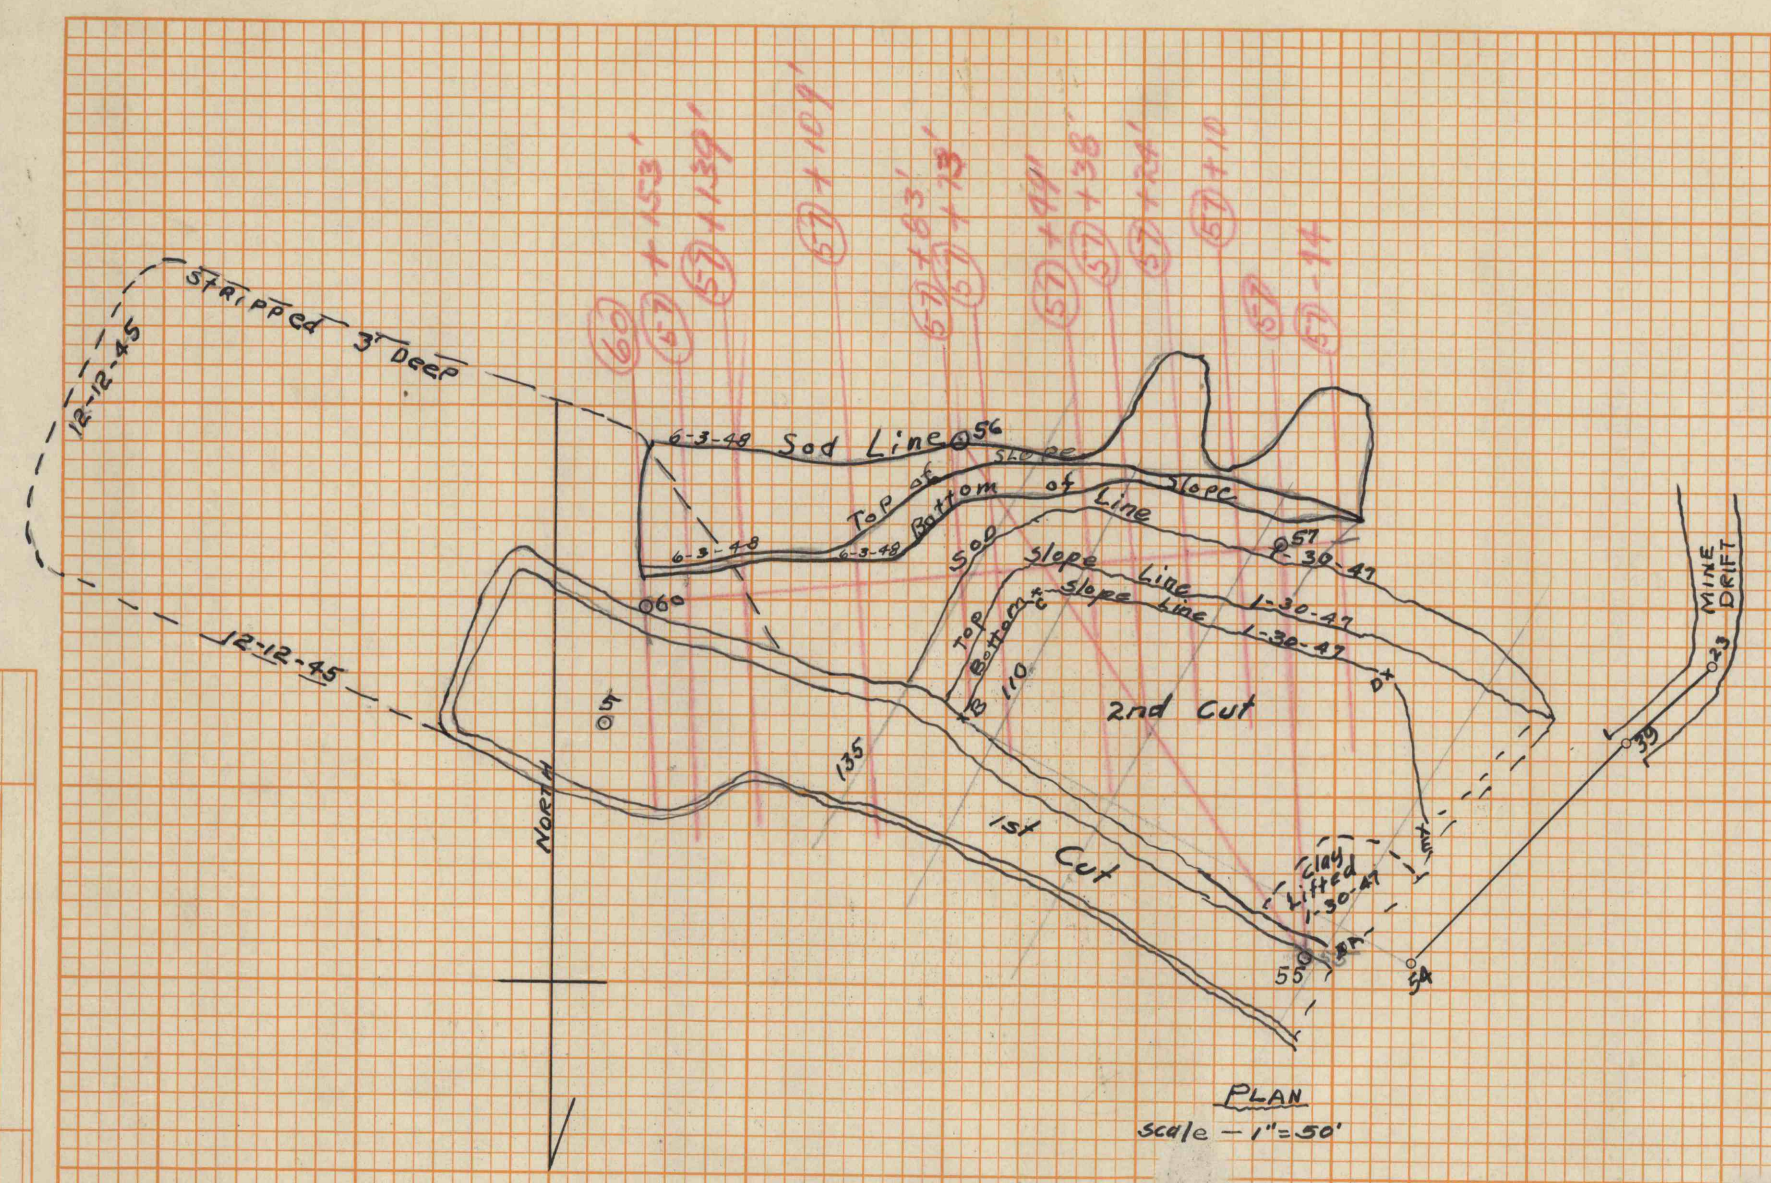

X Sections

BEECHER CLAY STRIPPING - LOCK HAVEN

NORTH EAST OF DRIFT - SECOND CUT

SURVEYED 1-30-47
 CALCULATED 2-4-47 AEH
 CHECKED JONGH
 Scale Horizontal 1" = 10'
 Vertical 1" = 10'

OVERBURDEN REMOVED - 4150 Cubic Yards

INDEX # 20-3-15B SHEET # 2