


**NORTH AMERICAN REFRACTORIES CO.**  
CLEVELAND - OHIO

MAP OF STRIPPING LAYOUT ON ROSS BLOOM  
TRACT - PIKE TWP. - CLEARFIELD CO. - PA.

SCALE - 1" = 10 FT.  

56-2-16

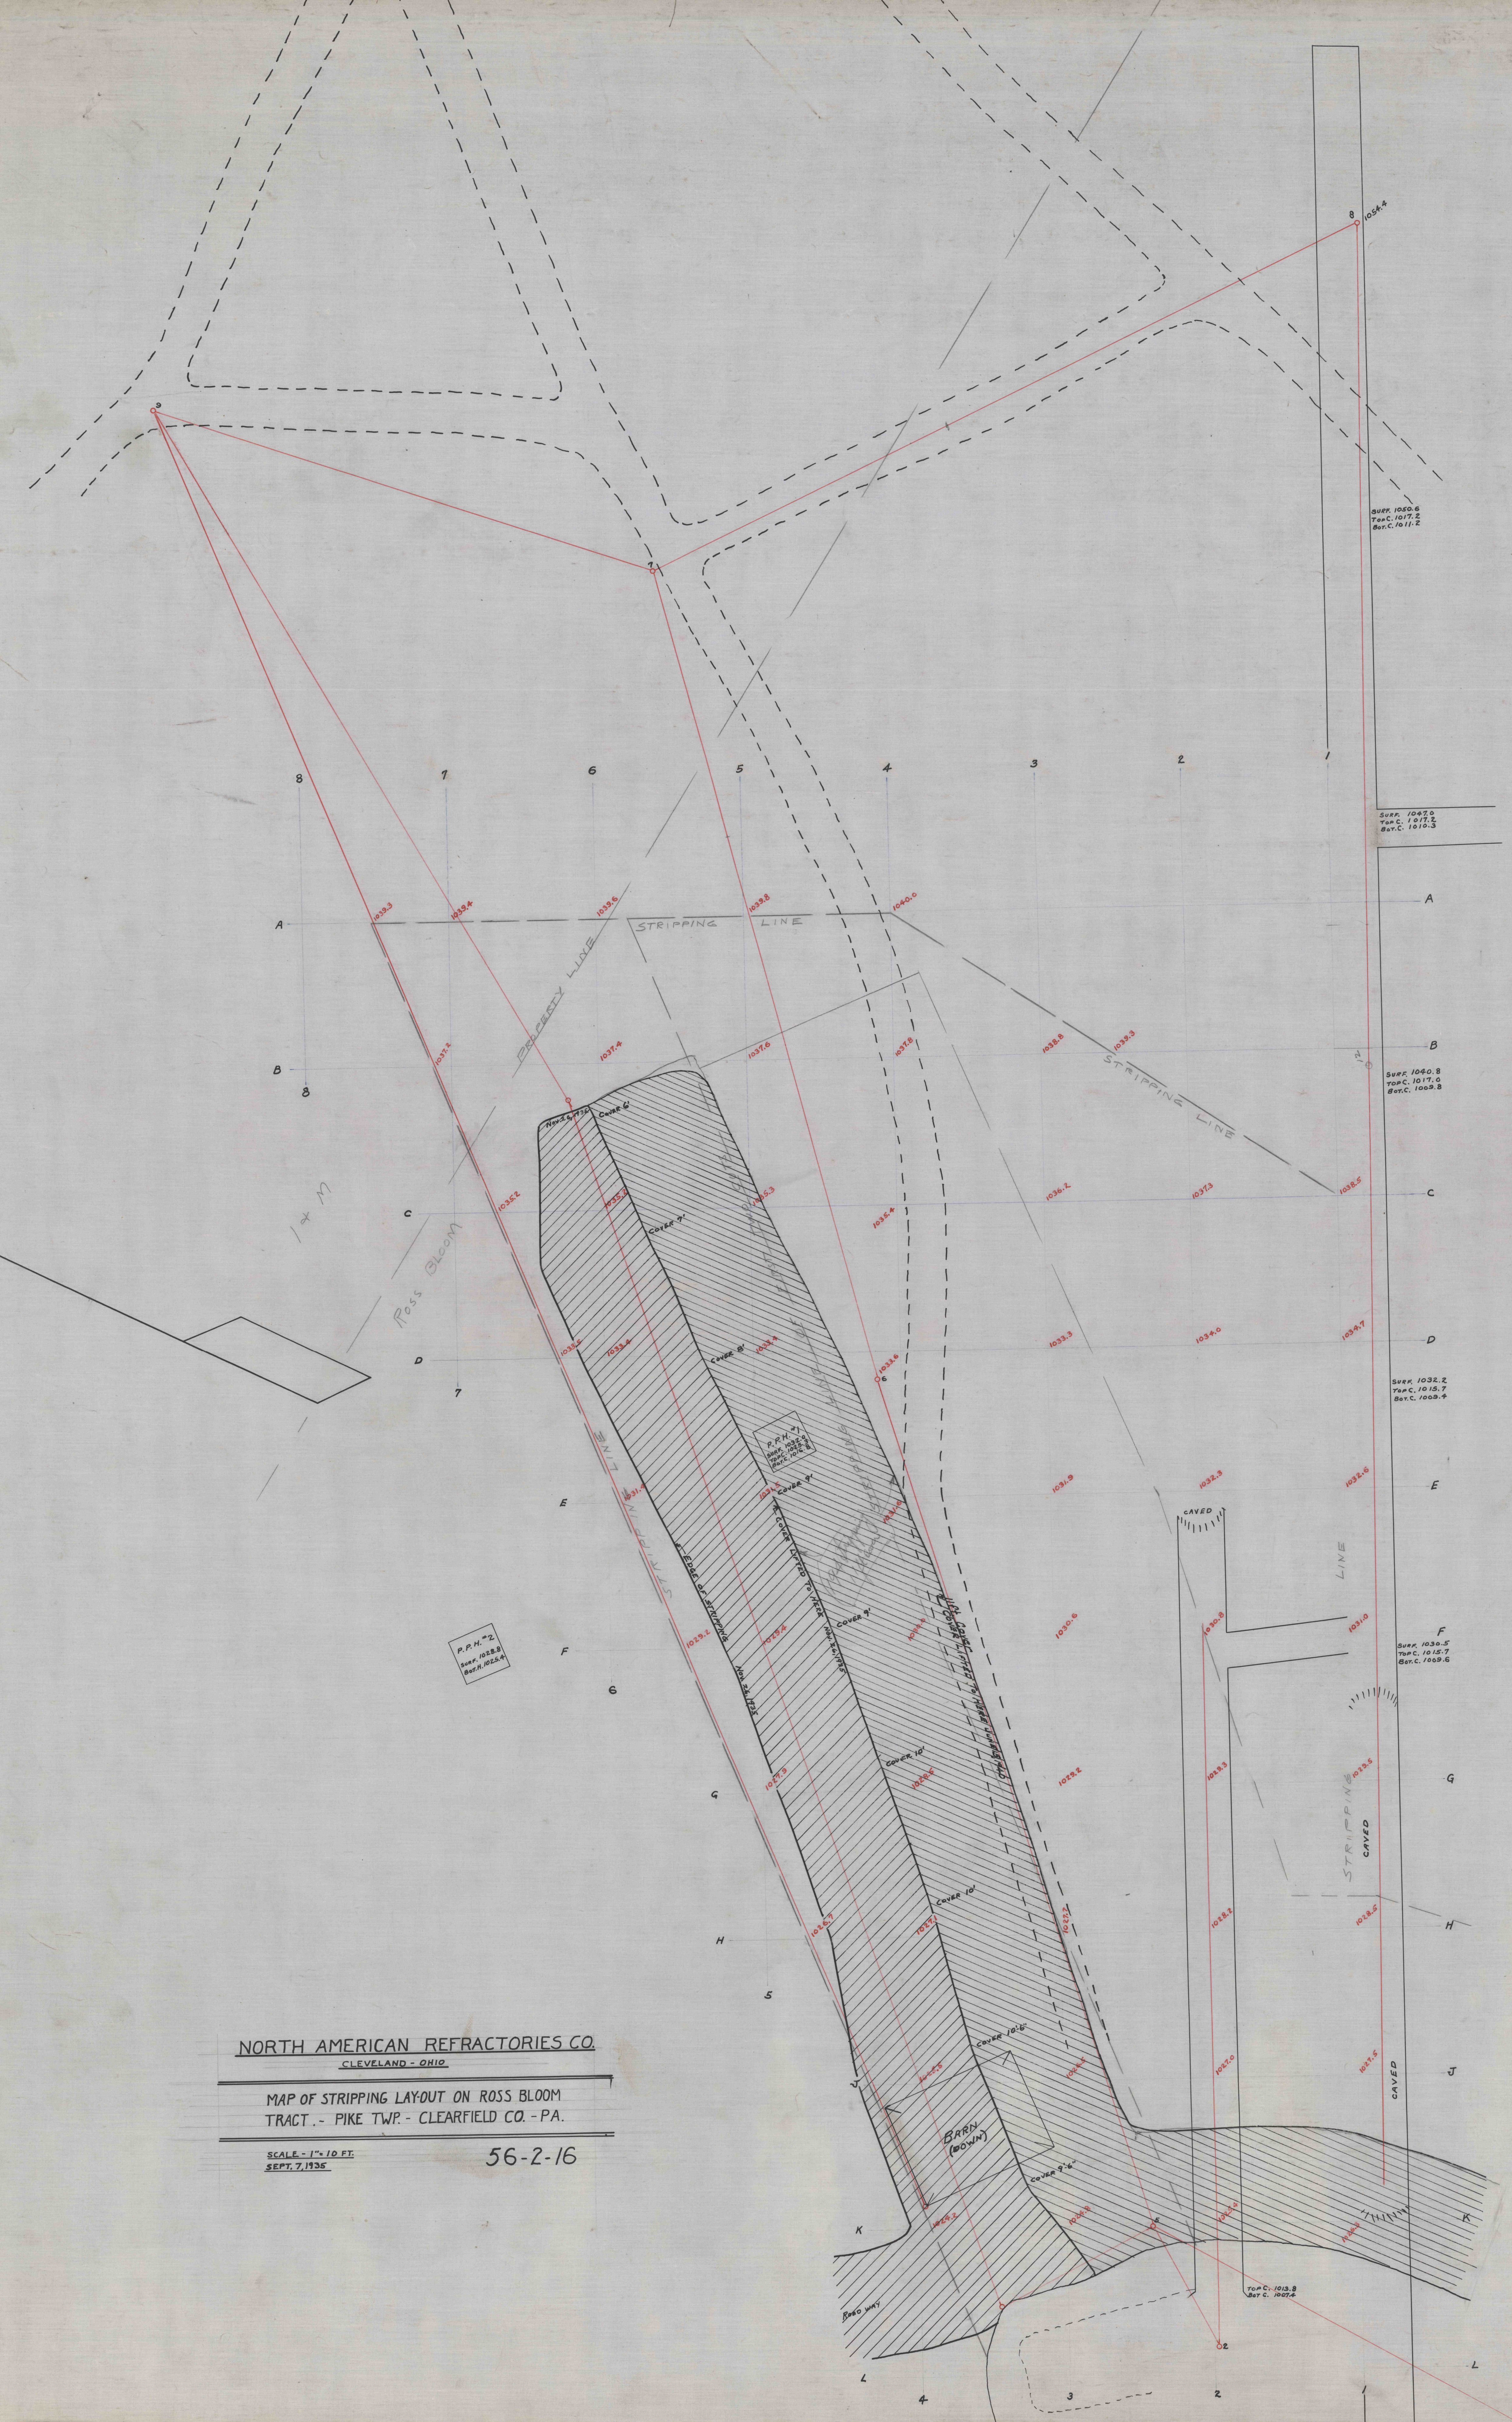






