


CM&M.C

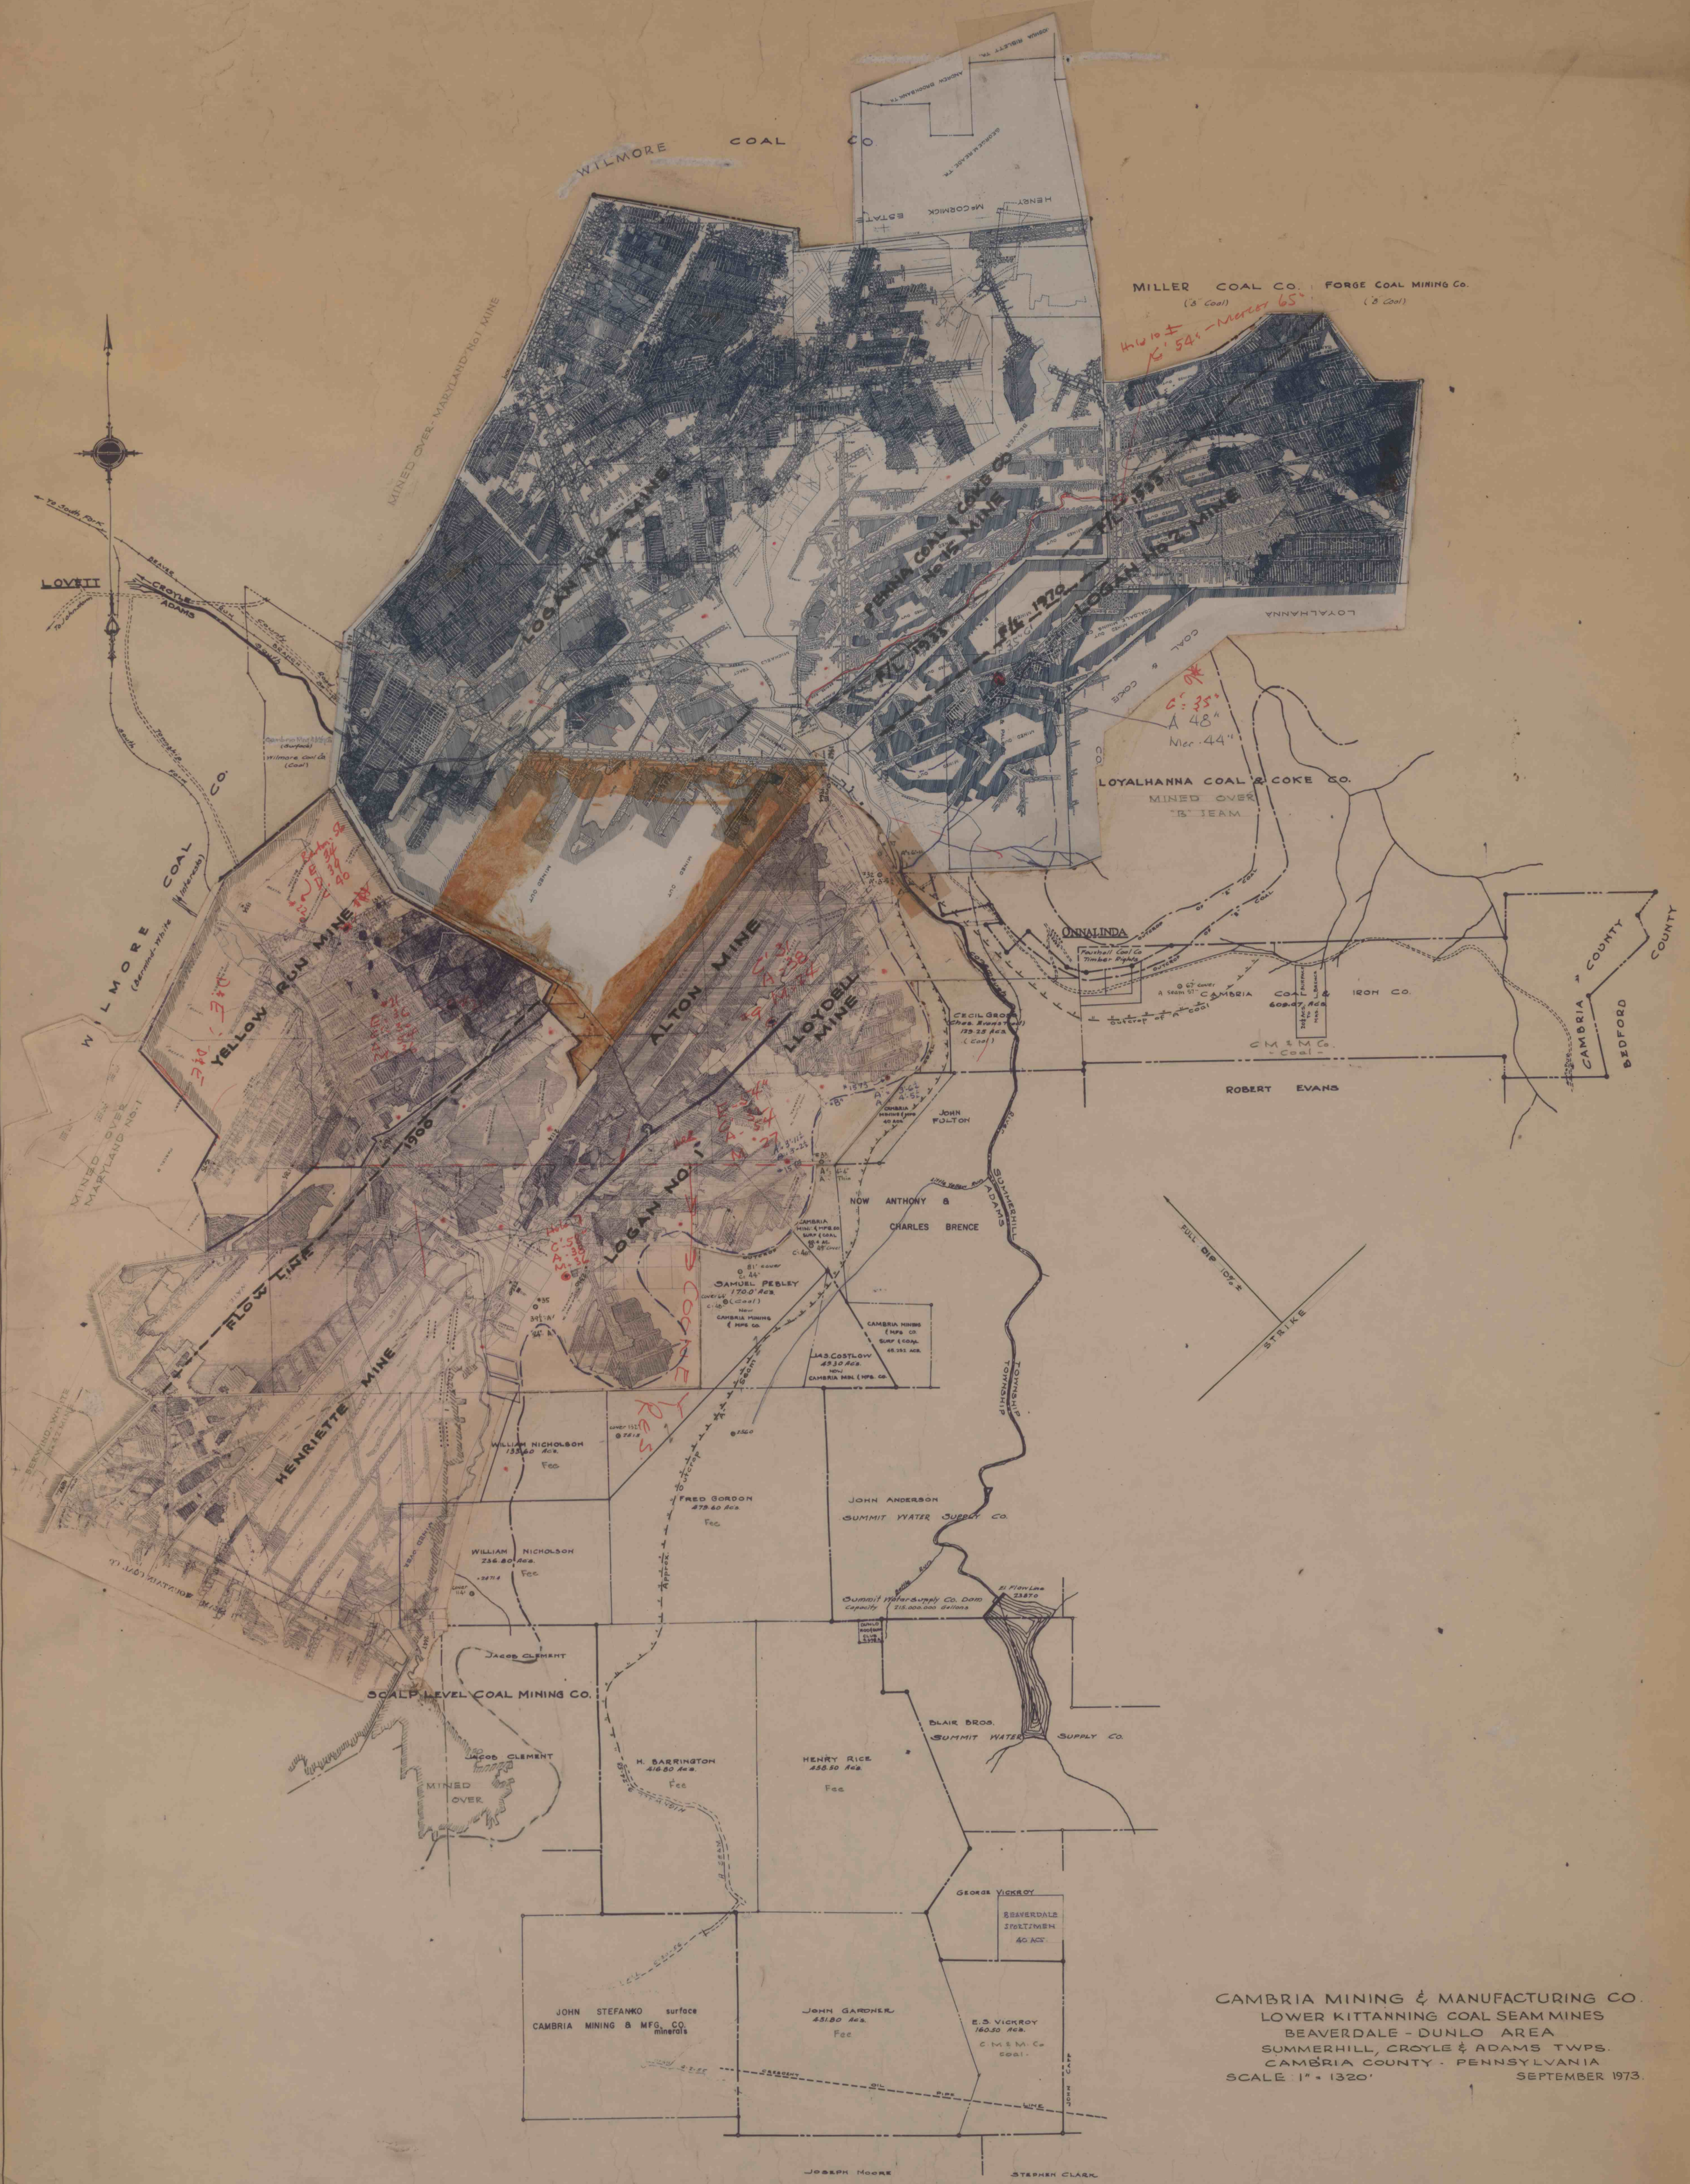

CAMBRIA MINING & MANUFACTURING CO.  
 LOWER KITTANNING COAL SEAM MINES  
 BEAVERDALE - DUNLO AREA  
 SUMMERHILL, CROYLE & ADAMS TWPS.  
 CAMBRIA COUNTY - PENNSYLVANIA  
 SCALE 1" = 1320'  
 SEPTEMBER 1973.