

JOHNSTOWN COAL & COKE CO.

~~CAMBERIA COUNTY COAL CO.~~
C SEAM MINES

SUMMERHILL & POT TAGE TWP'S

CAMBERIA COUNTY
PENNSYLVANIA

SCALE 1"=1320'

KING & STORM
4509 4th

CA HUGHES & CO



PORTAGE No. 10 MINE
LEASED TO MARPORT COAL CO.


PORTAGE No. 8 MINE
- ABANDONED -

No. 2 MINE

PORTAGE

PORTAGE No. 2 MINE
BOUCHER-CORTRIGHT LEASE
(NOW ABANDONED)

MANOR REAL ESTATE & TRUST CO. TRACT

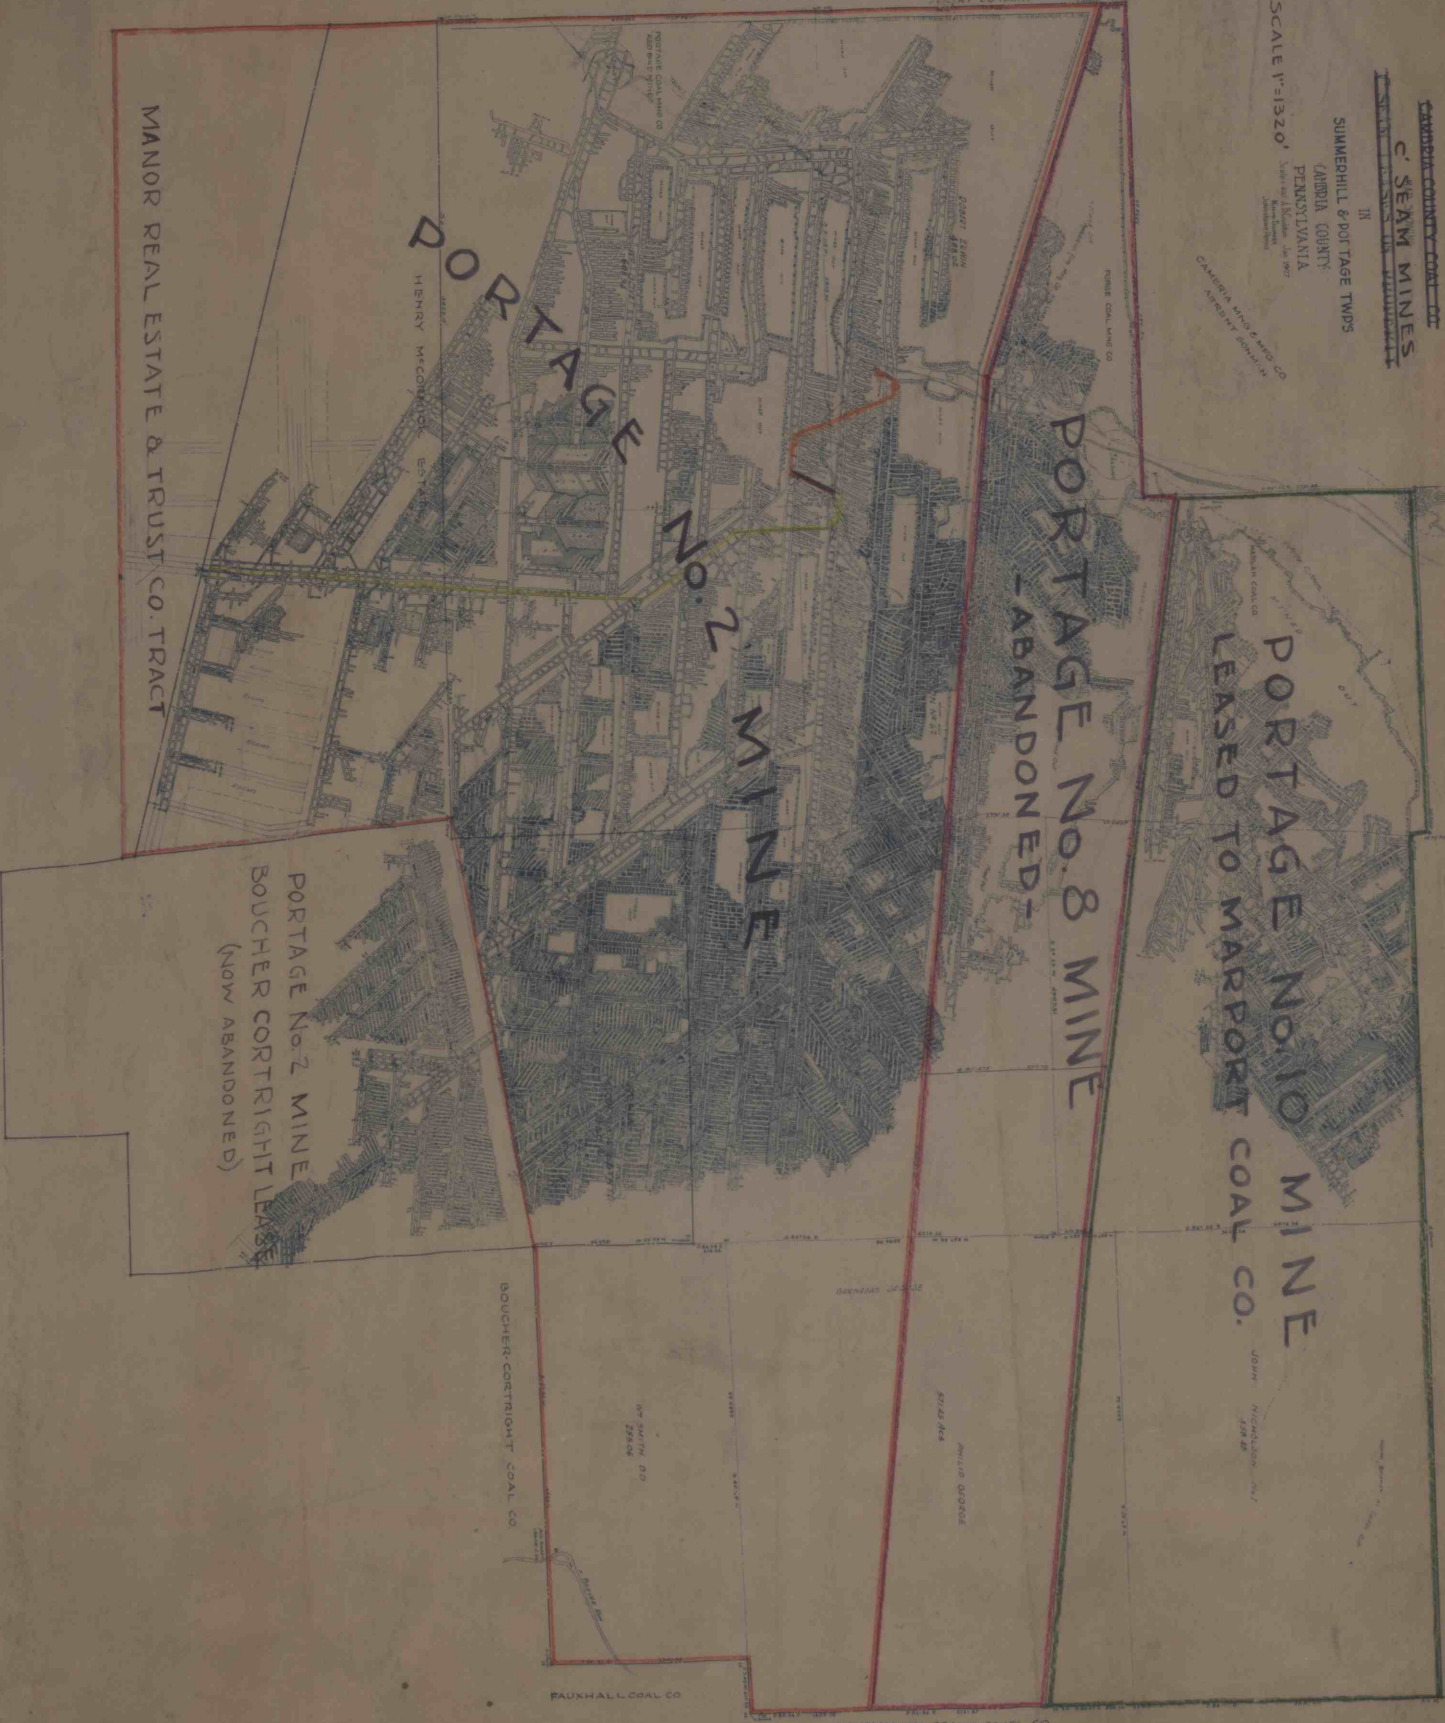

BAUXHALL COAL CO

LOYALHANNA COAL & COKE CO

