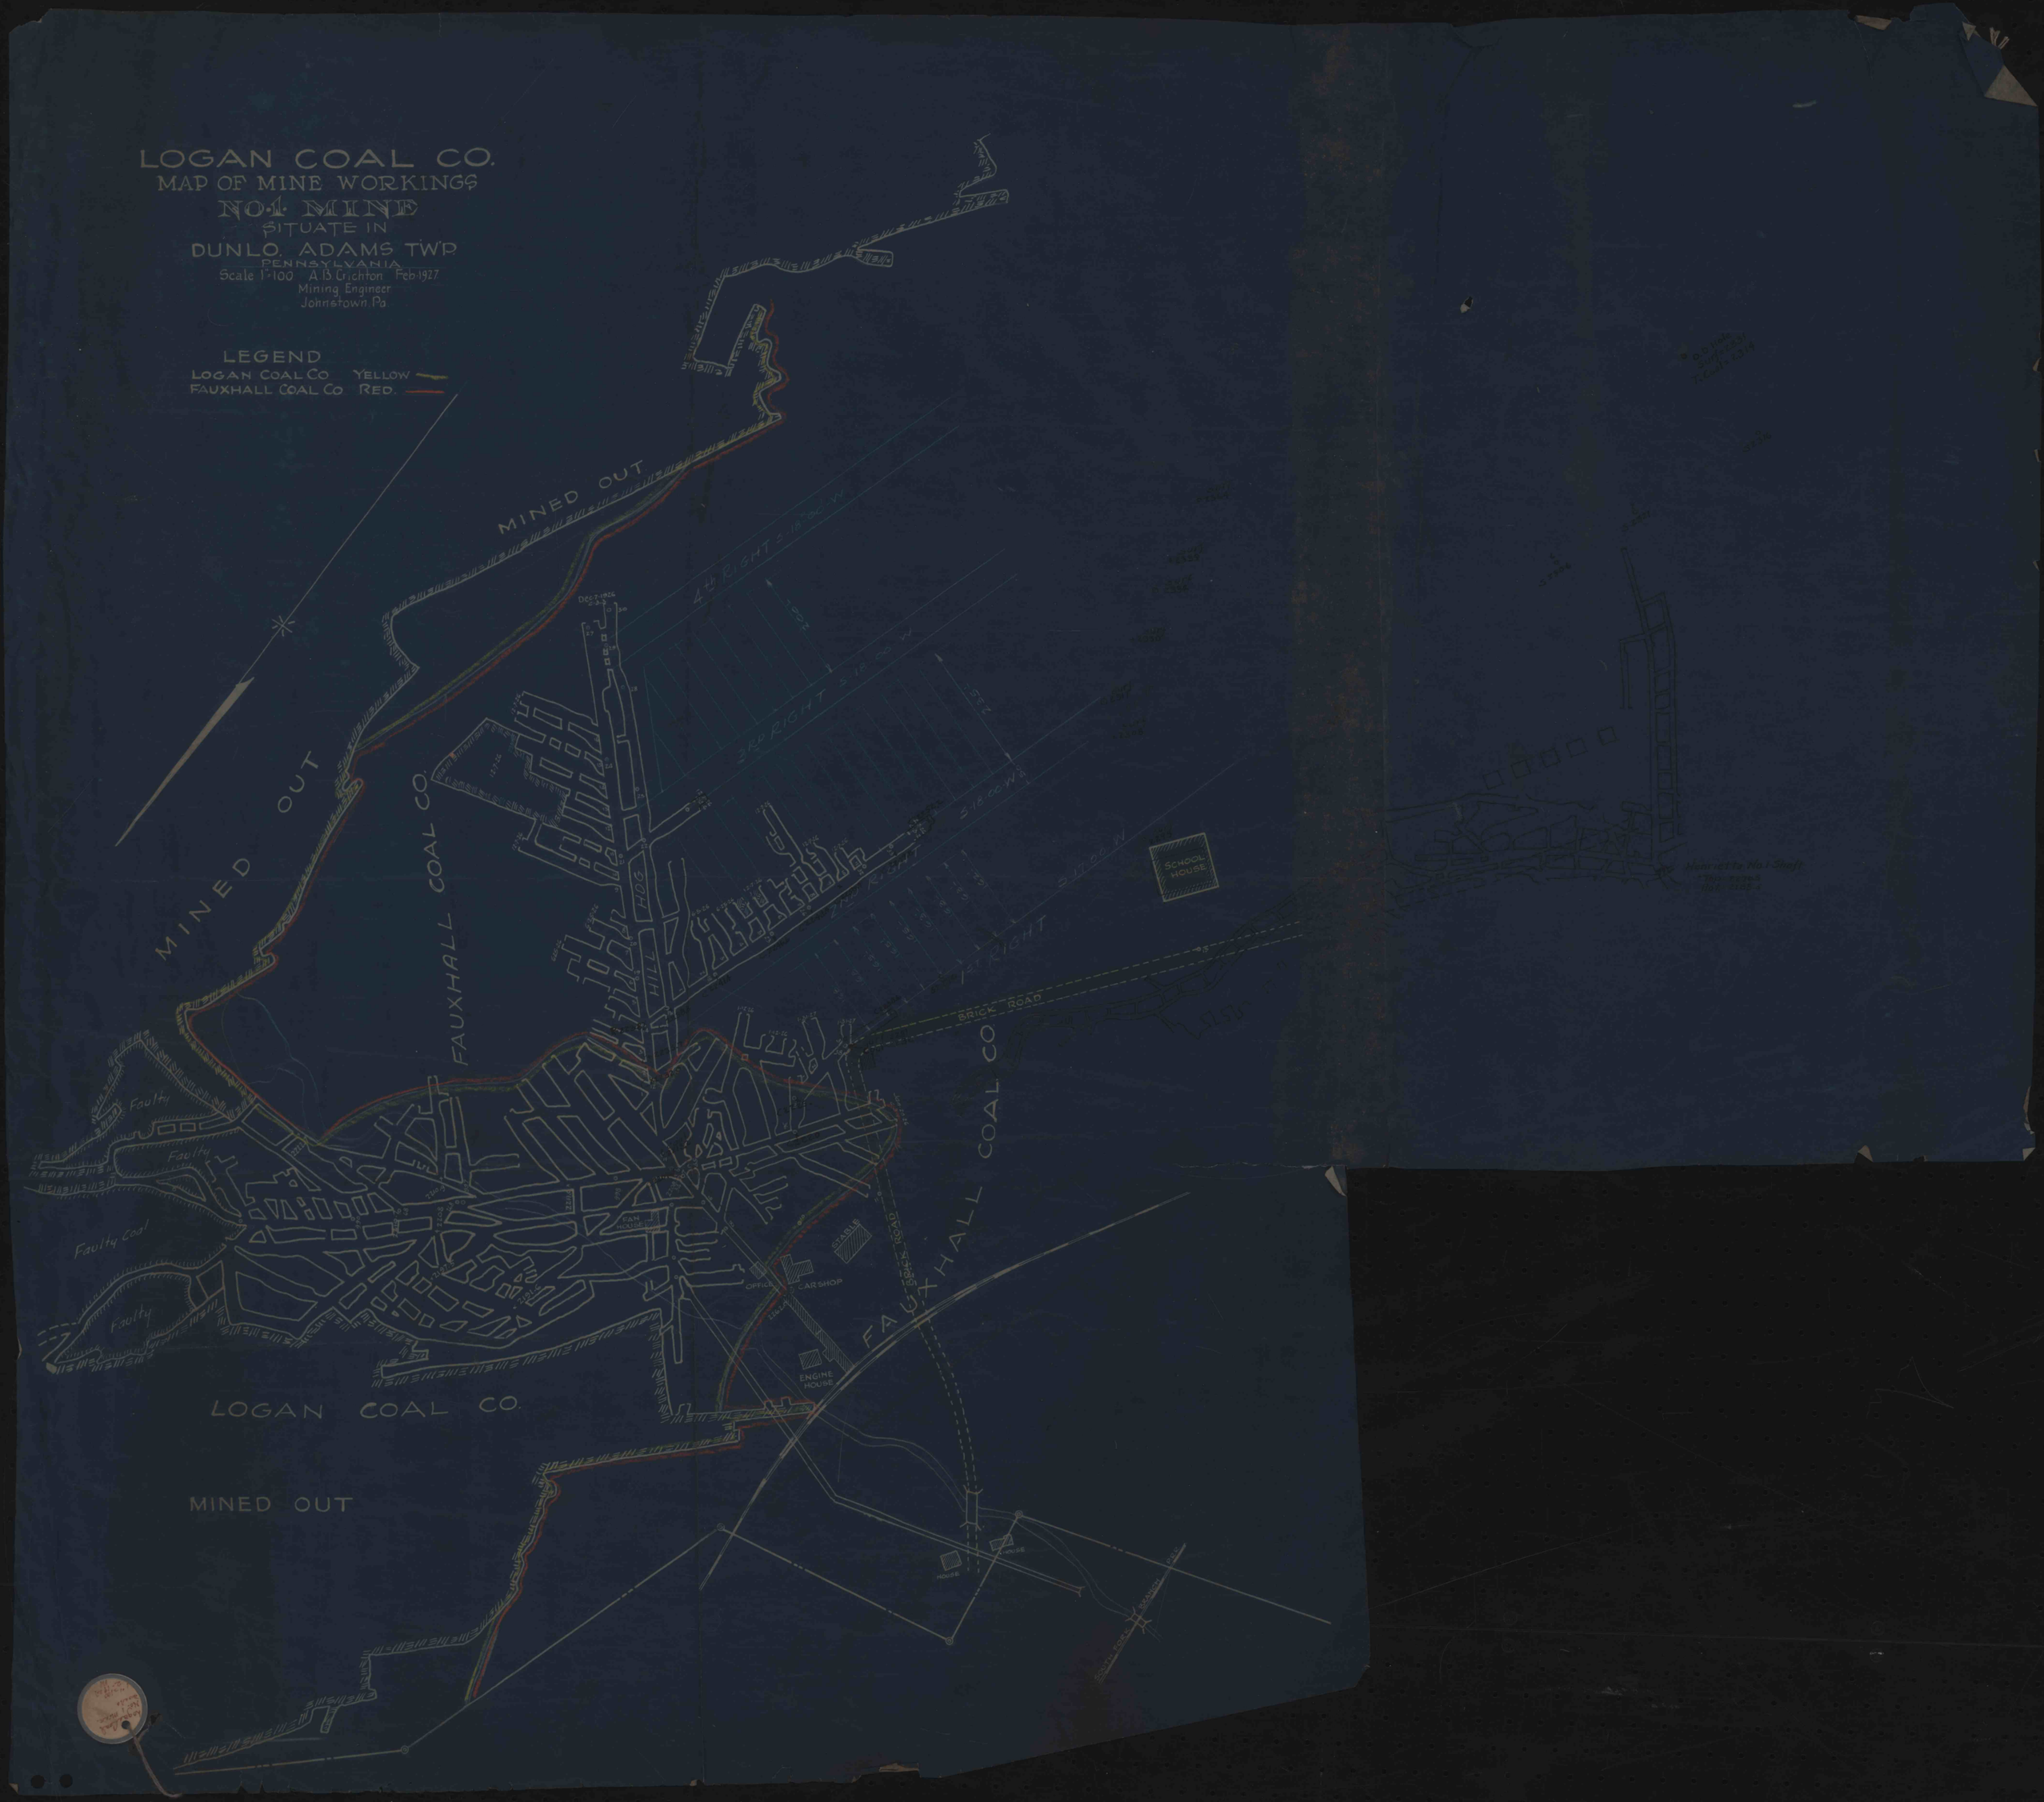
LOGAN COAL CO.
MAP OF MINE WORKINGS
NO. 1 MINE
SITUATE IN
DUNLO, ADAMS TWP.
PENNSYLVANIA
Scale 1"=100 A.B. Crichton Feb. 1927
Mining Engineer
Johnstown Pa.
LEGEND
LOGAN COAL CO YELLOW
FAUXHALL COAL CO RED.
MINED OUT
MINED OUT
FAUXHALL COAL CO.
FAUXHALL COAL CO
LOGAN COAL CO.
MINED OUT
BRICK ROAD
SCHOOL HOUSE
FAN HOUSE
OFFICE
CARSHOP
STABLE
ENGINE HOUSE
HOUSE
Faulty
Faulty
Faulty Coal
Faulty