


MOSHANNON MINE WORKINGS

WATER BARRIER TO MOSHANNON MINE

WANT FAULT ZONE

FAULT ZONE

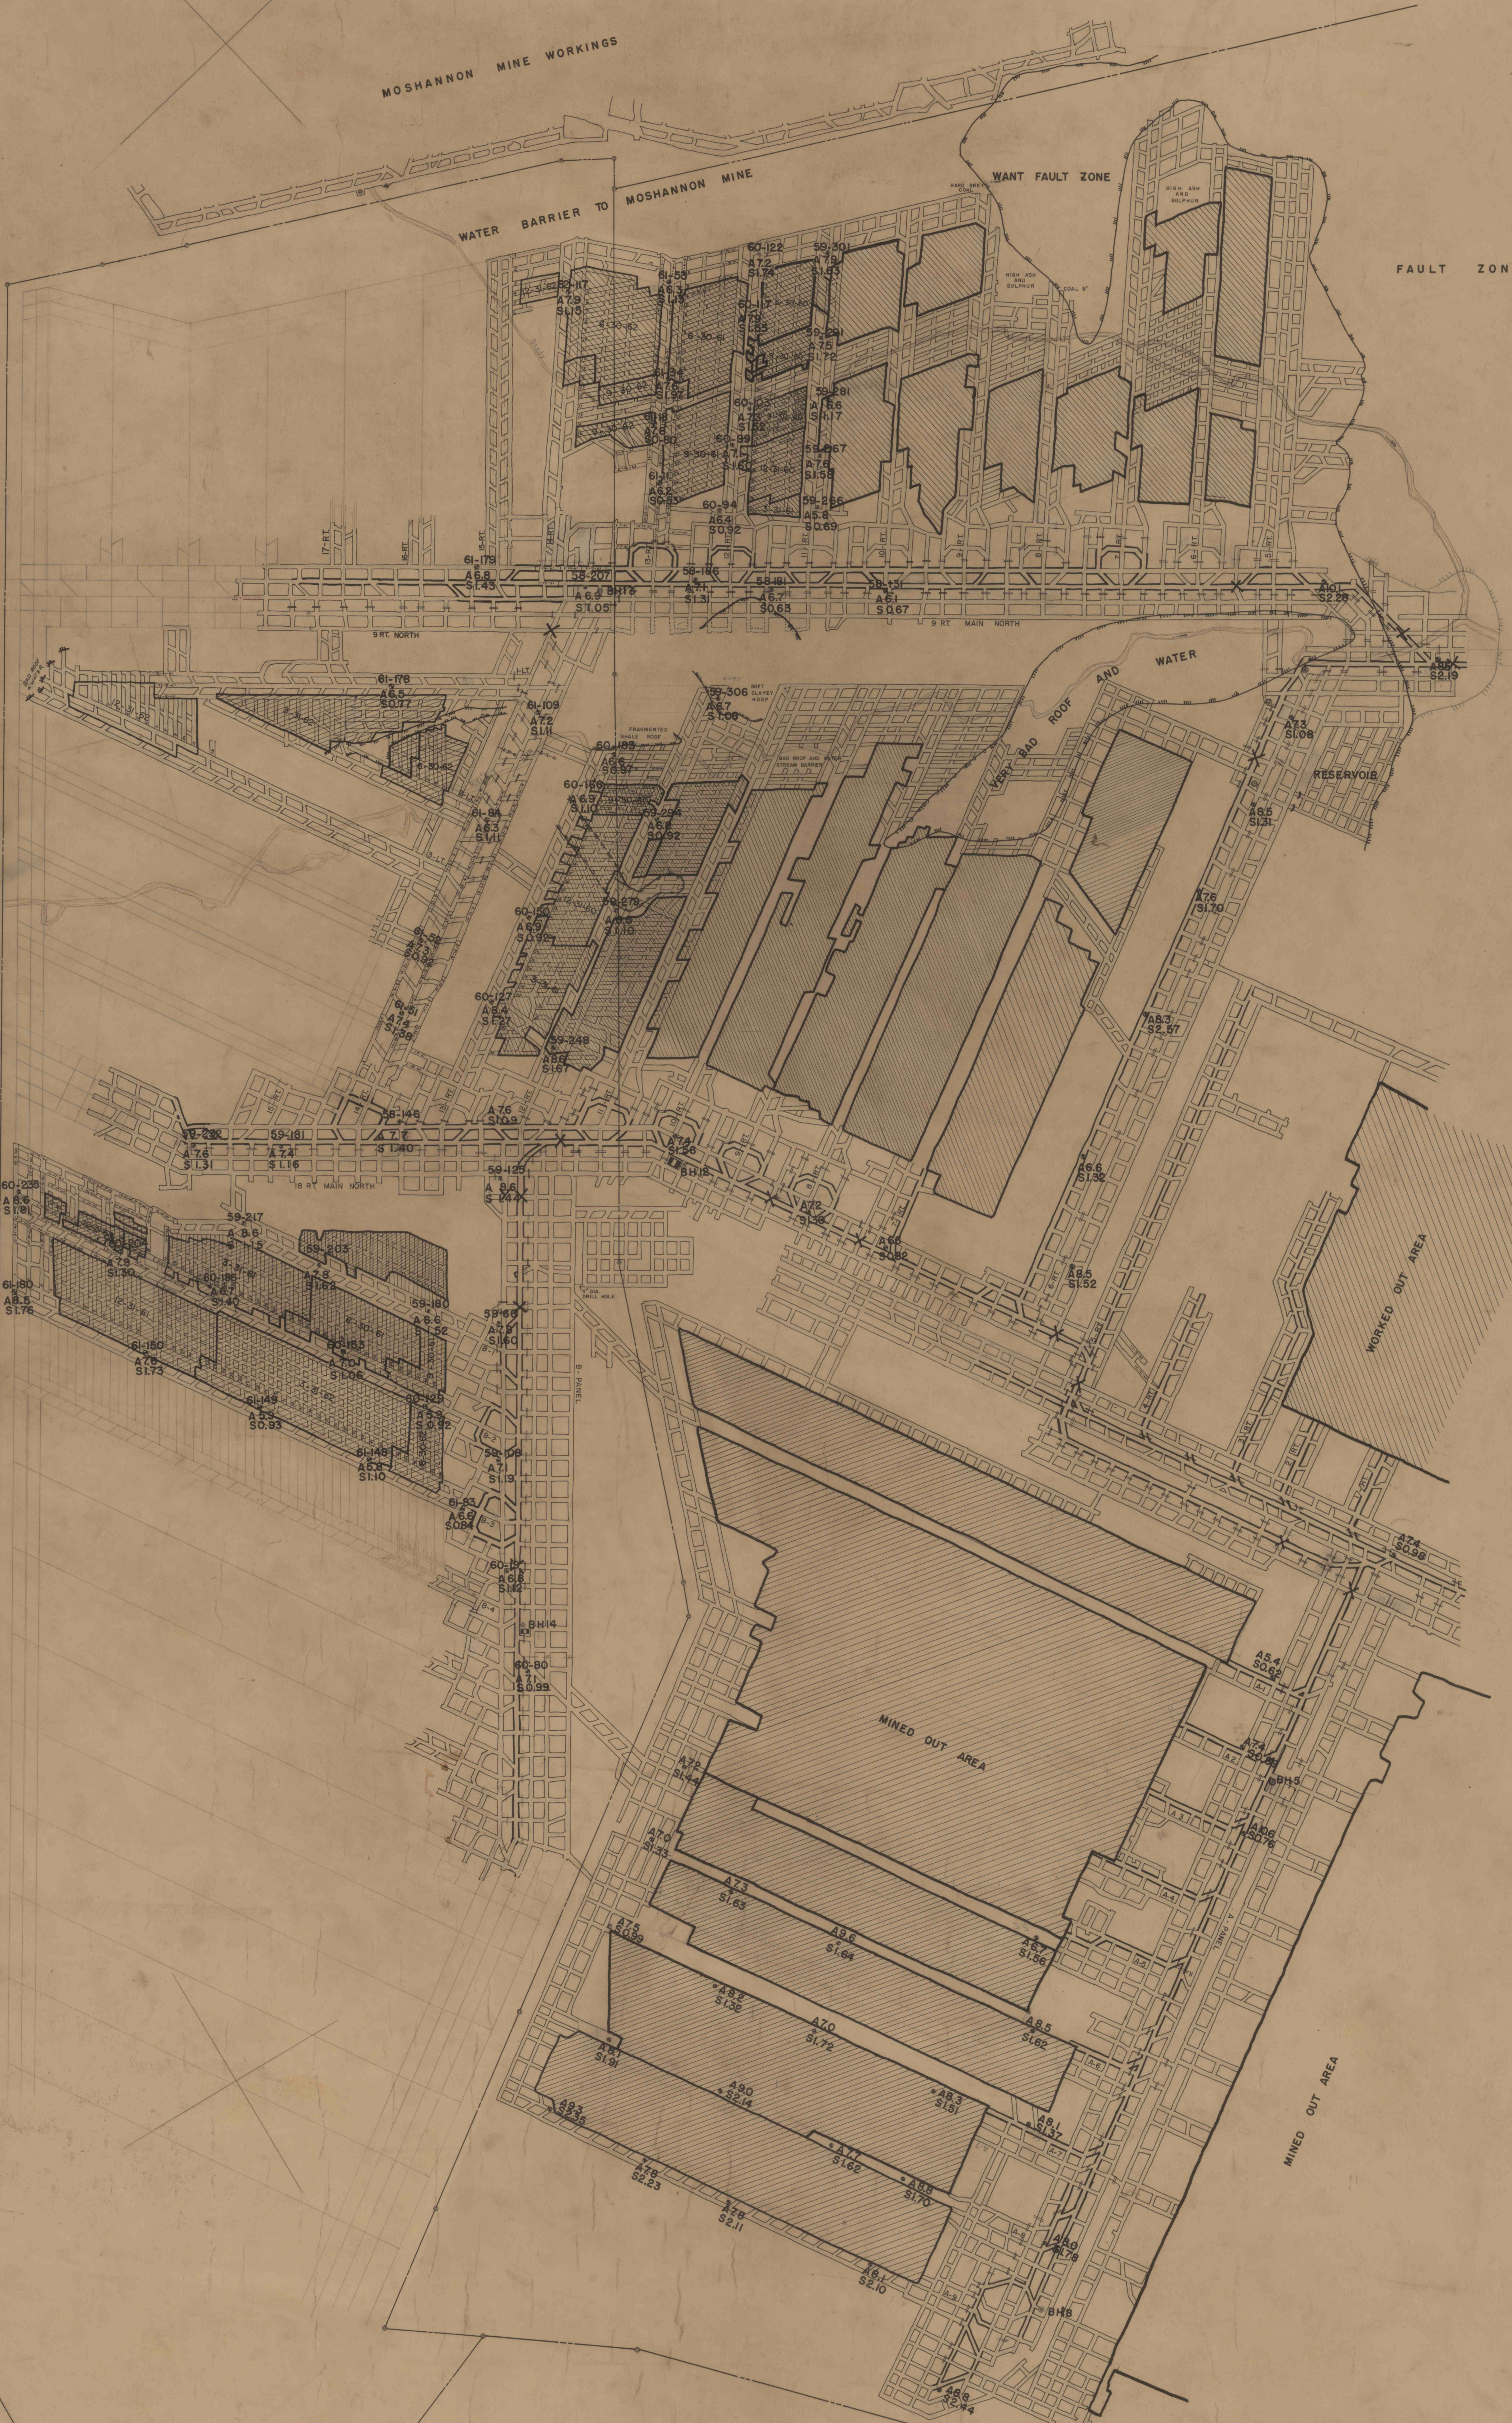

AND WATER

ROOF

RESERVOIR

WORKED OUT AREA

MINED OUT AREA

MINED OUT AREA

