



J.A. Shaffer

S. G. Mahoney

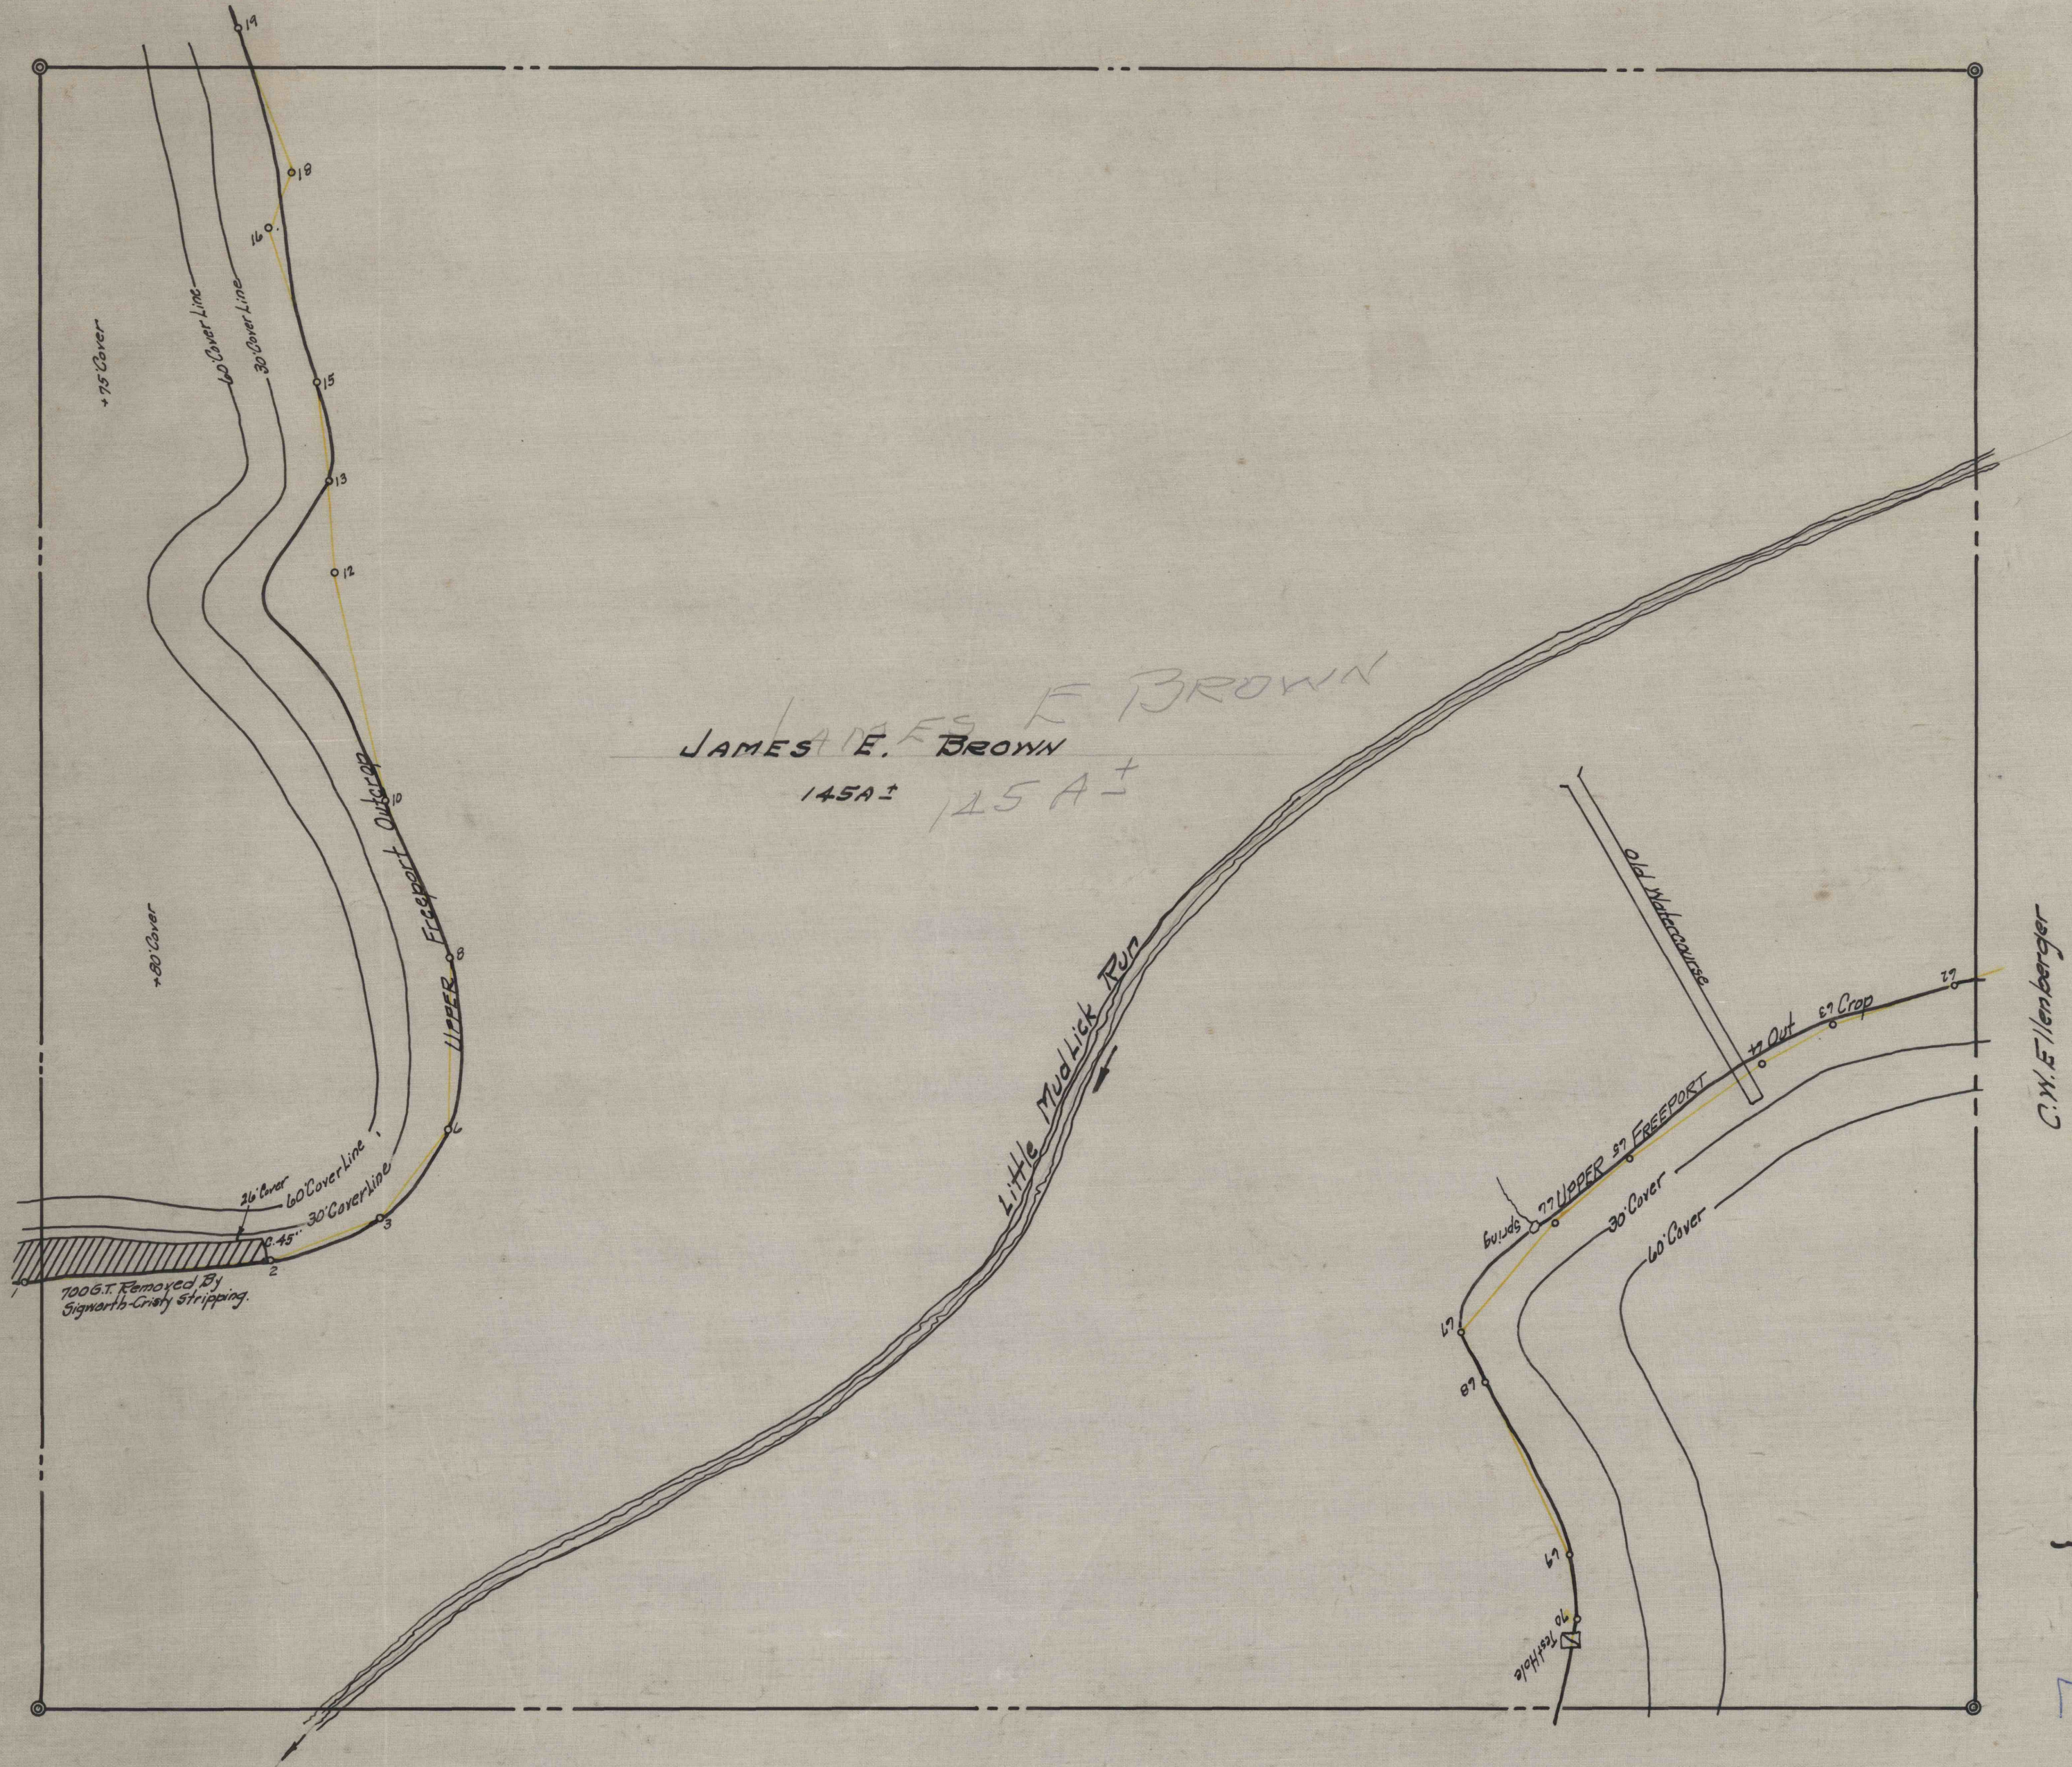

Little Mud Lick Run

C. W. Eilenberger

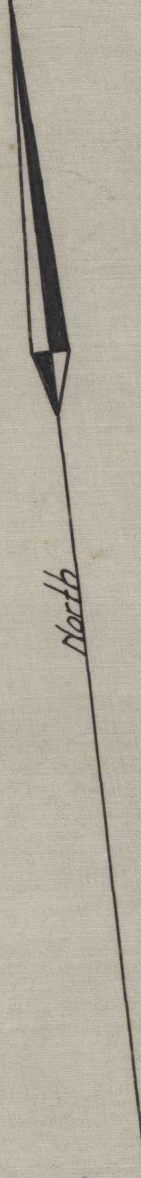

M

Map Of  
 Upper Freeport Stripping Area  
 On The  
 JAMES E. BROWN 145 Acre Tract  
 Red Bank Twp. Armstrong Co. Penna.

SCALE 1"=200'

Oct. 19, 1942

By J. H. Mining Engr  
 Clearfield, Pa.

N.B. Y 252

Amos Sivis

754