


11511

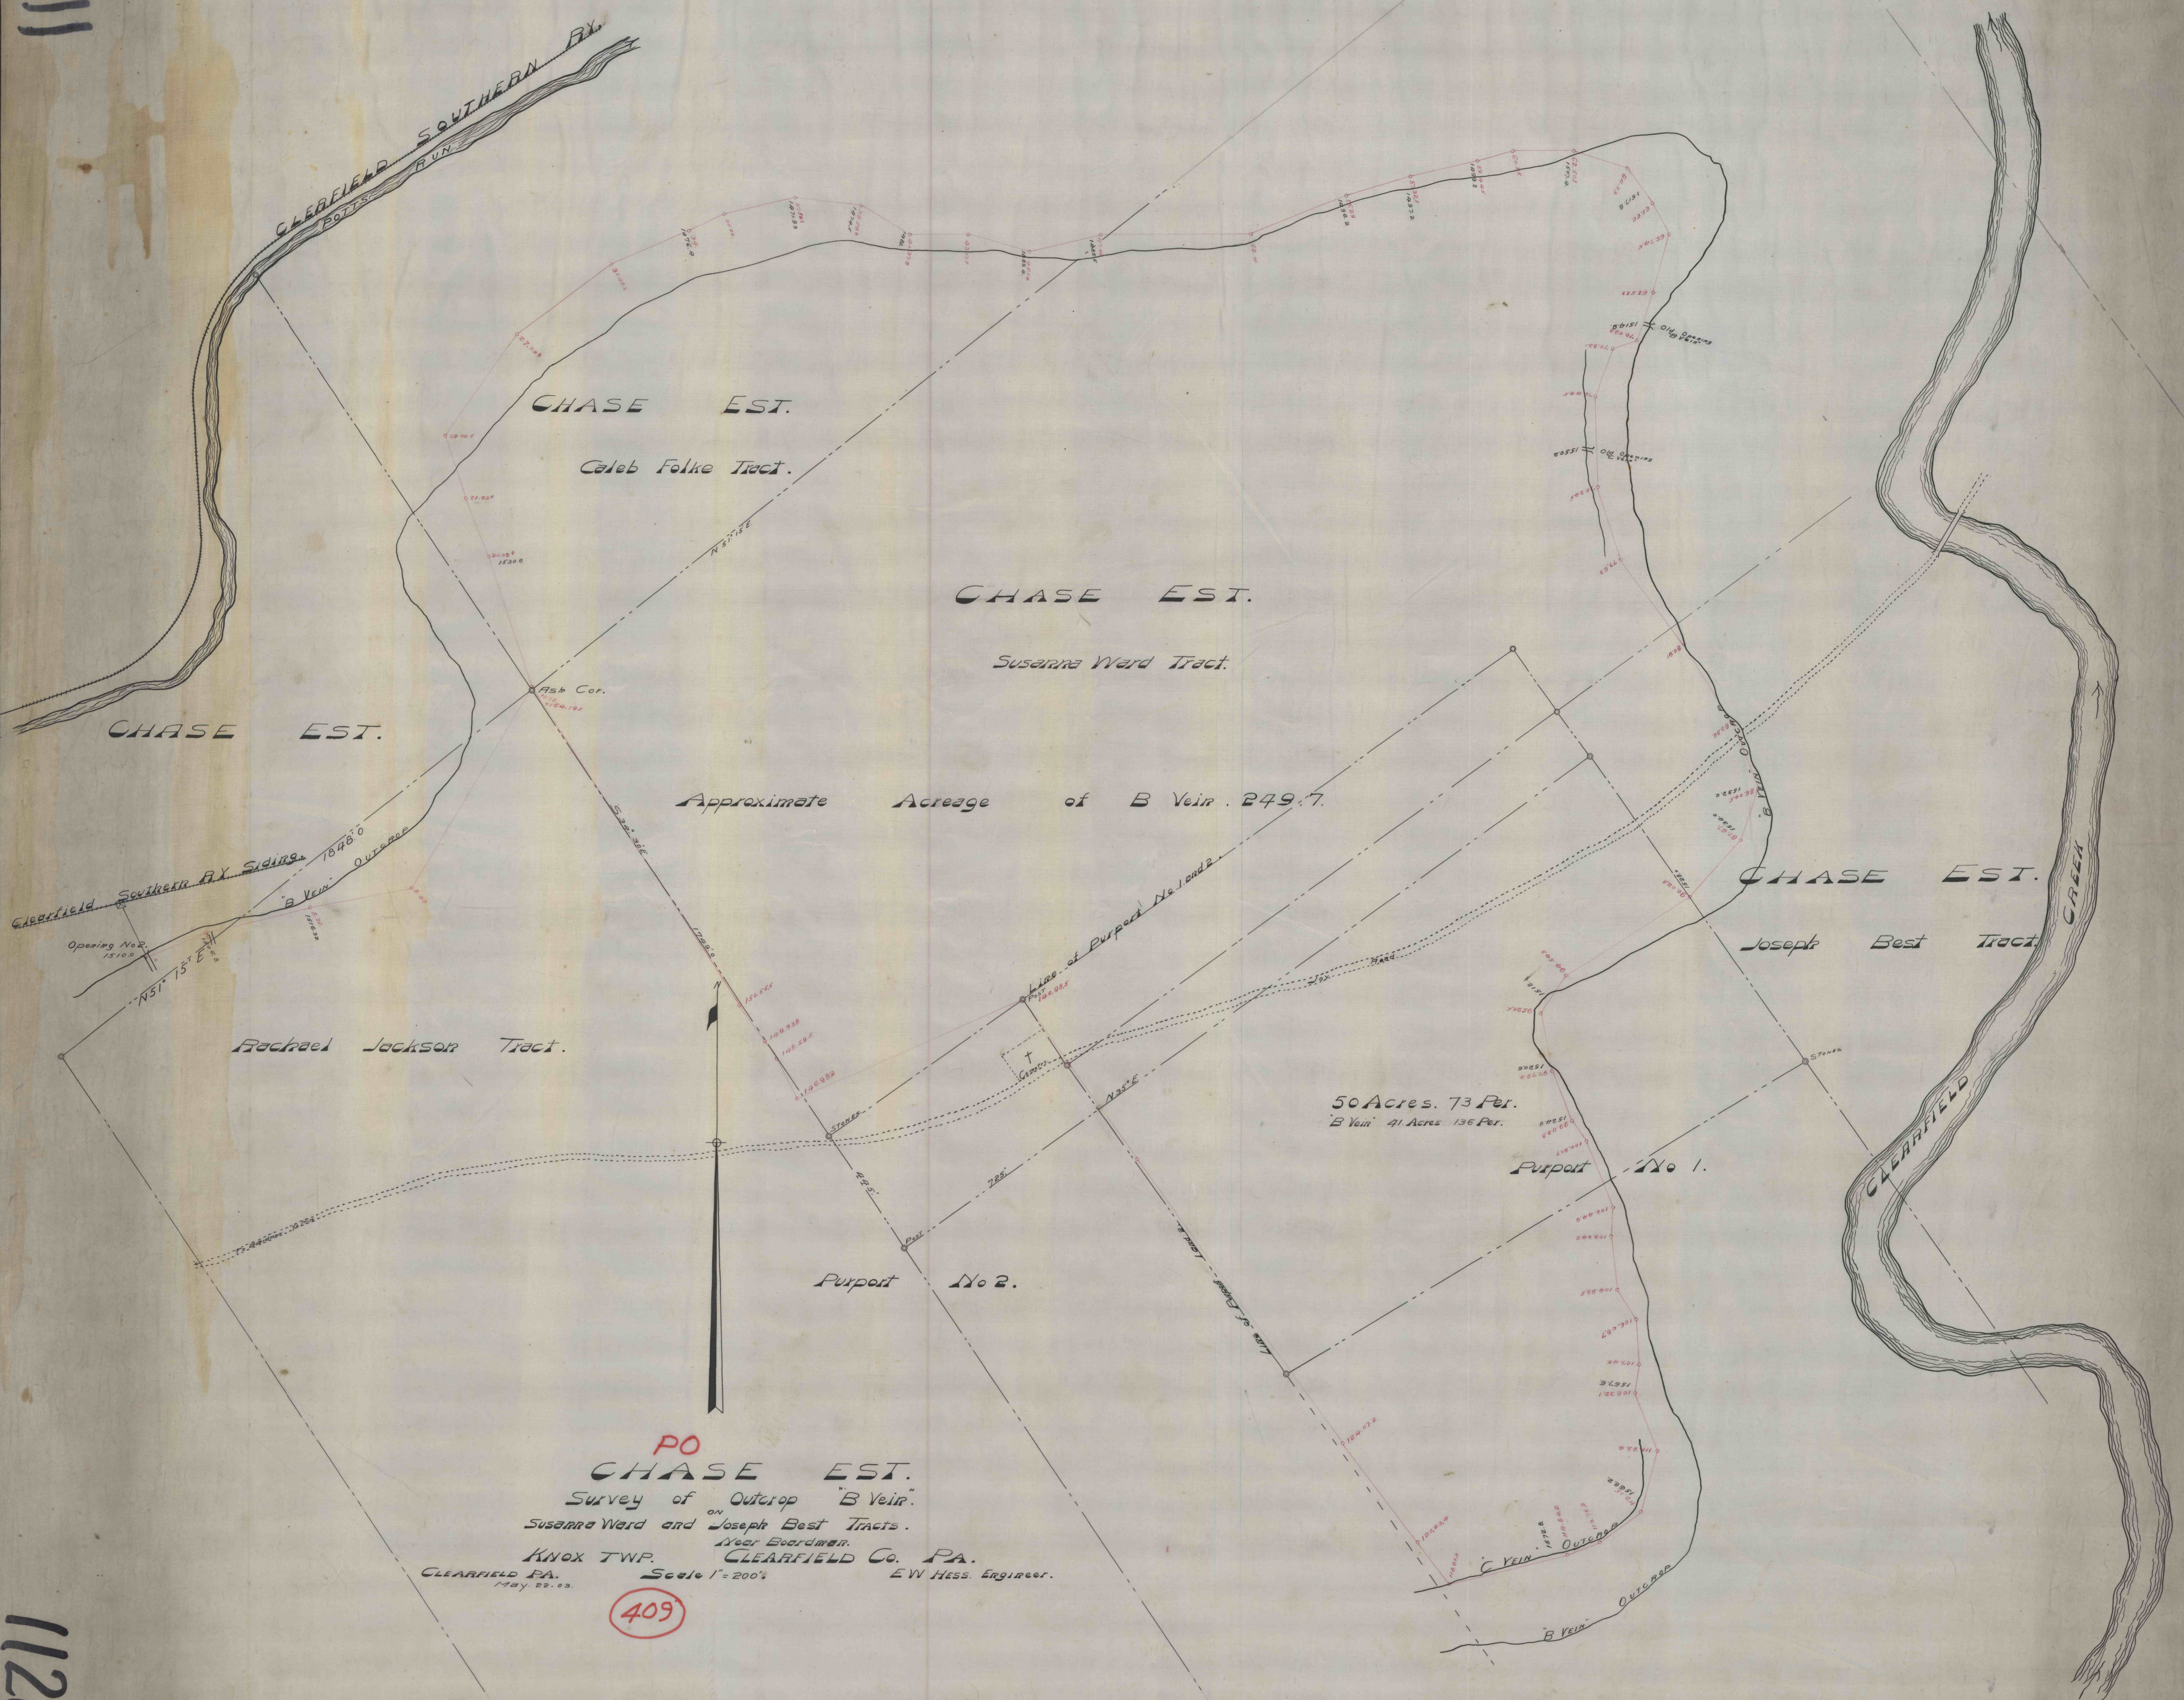

PO  
**CHASE EST.**  
 Survey of Outcrop "B Vein"  
 on Susanna Ward and Joseph Best Tracts.  
 Near Boardman.  
 CLEARFIELD CO. PA.  
 E.W. Hess, Engineer.

KNOX TWP.  
 CLEARFIELD PA.  
 May 22, 03.

Scale 1" = 200'

409

1126

A.M.D.