

8911

T. H. FORCEY



THOMAS MURPHY  

CHARLES PETERSON

101 Acres 116 P. ±

DB. 228 P. 14

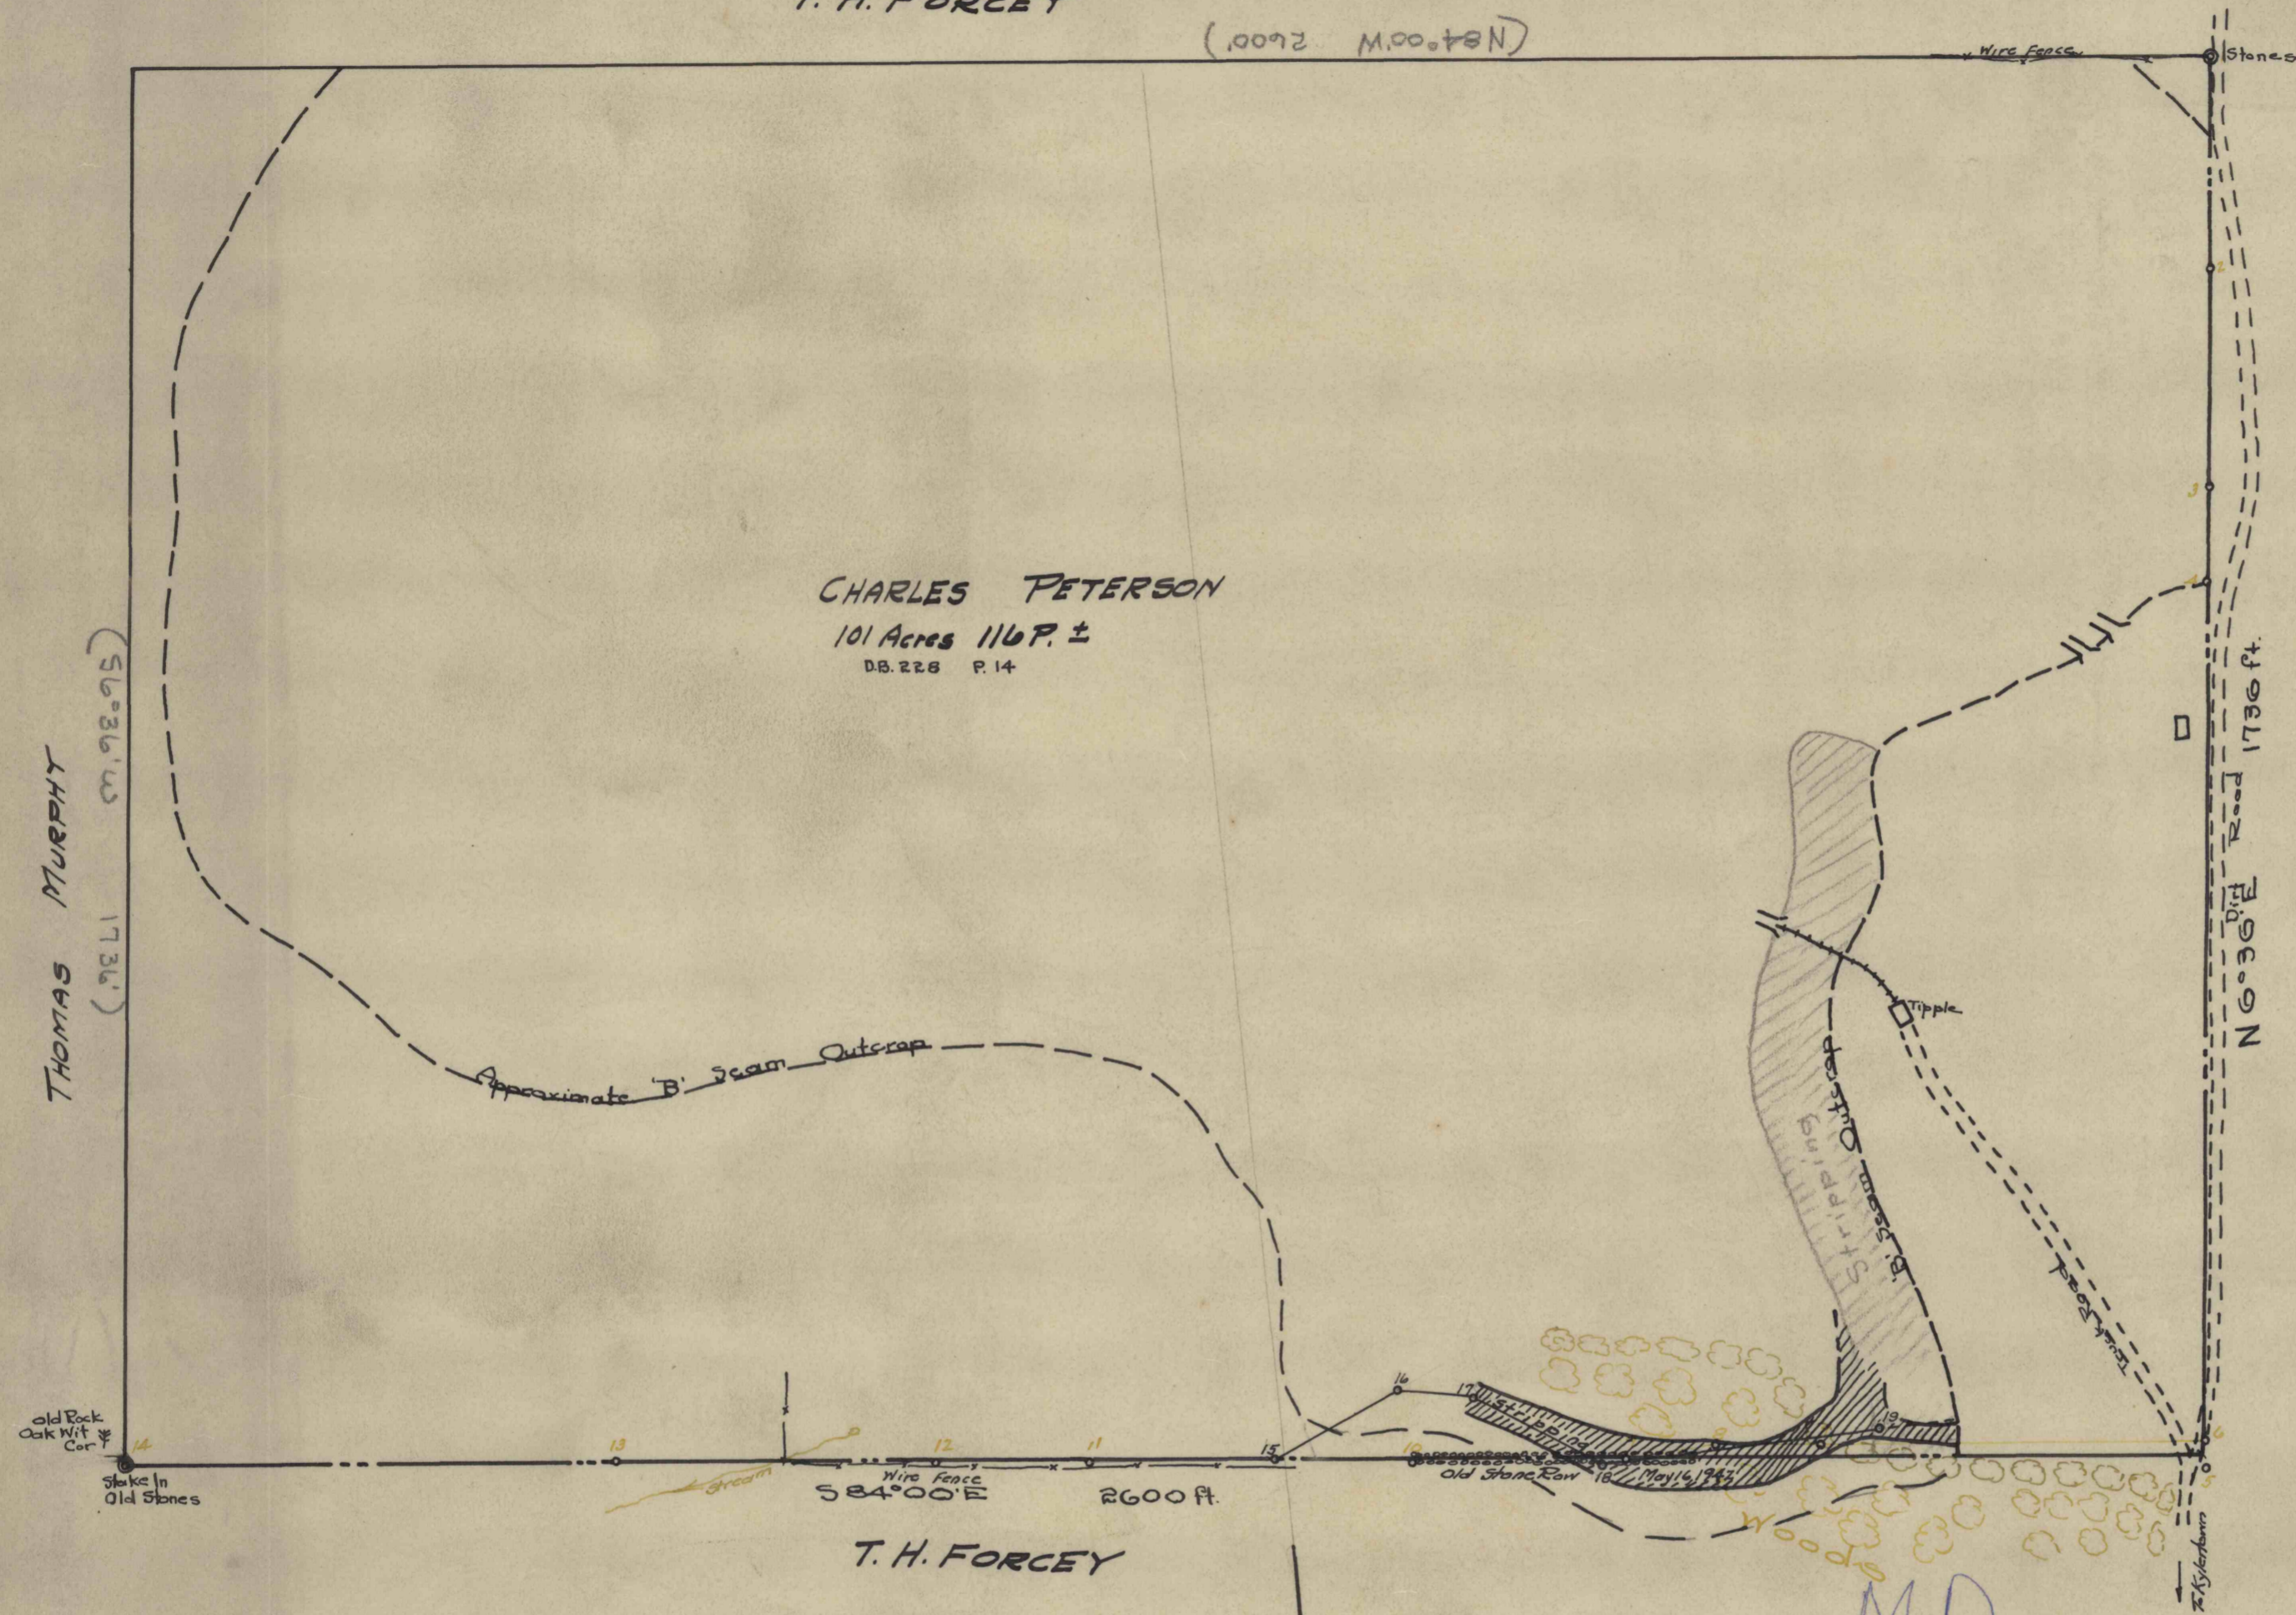

GEO. HOOVER

MP

The Bradford Coal Co  
Map Of  
**CHARLES PETERSON TRACT**  
Cooper Twp. Clfd. Co. Pa

SCALE 1" = 200'

Feb. 17, 1942 By J. H. ... R.S. 5173.

stripping Meas. & Located May 16, 1942

751

8911